



10-11-44  
Dyset  
Dickinson  
B. Wilgus

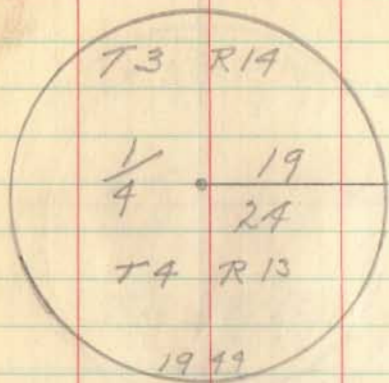

Found Iron pin as referred  
to in Book 558 p. 60 (4)  
Set Concrete Mon. Full Length  
Top 8" below surface of road  
Stamped as above

See Book 558 page 60

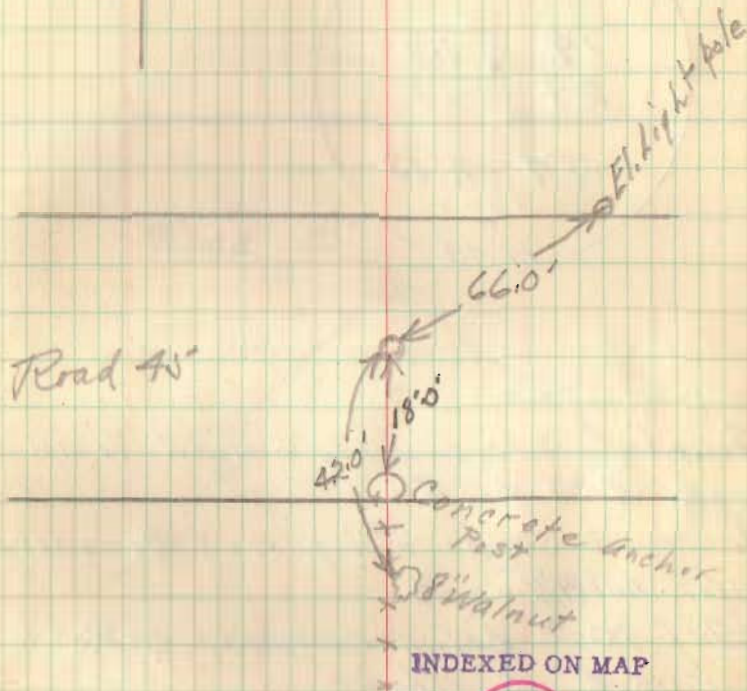

INDEXED ON MAP

2644 Union  
Twp.

INDEXED ON MAP