

(10)


10-12-44
Dybert
Dickinson
B. Wilgus



Found Stone With Iron bar under
stone 2' deep. Removed same and
placed concrete Mon.

Top 20" below present surface
of road
Marked as above
Reference Field Book 558 p 68

33

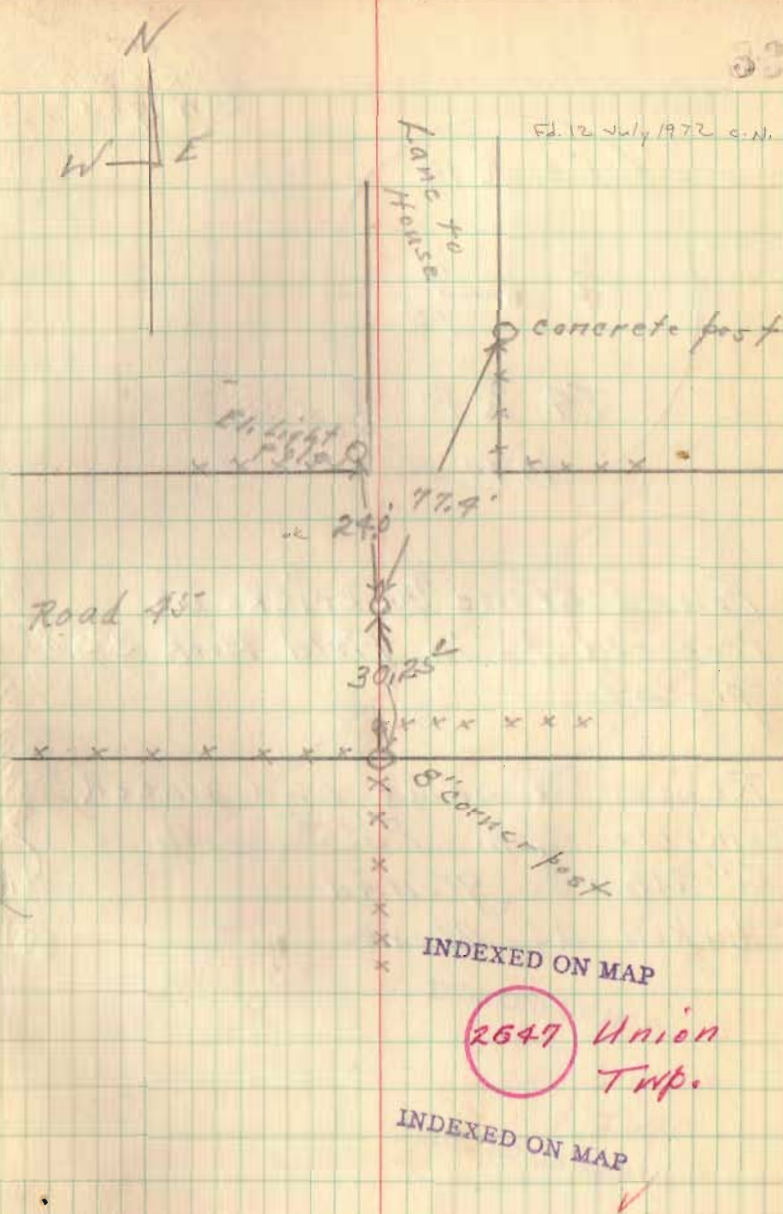

Ed. 12 July 1972 c.N.

El. Light
P. 510.0

INDEXED ON MAP

2647 Union
Twp.

INDEXED ON MAP