




5/3/43

Found stone 5" x 5" x 12" with
brick around it. Removed stone
and placed Mon. 4" below surface.

J H Inskeep
Lane Kerns
Paul Fout

71

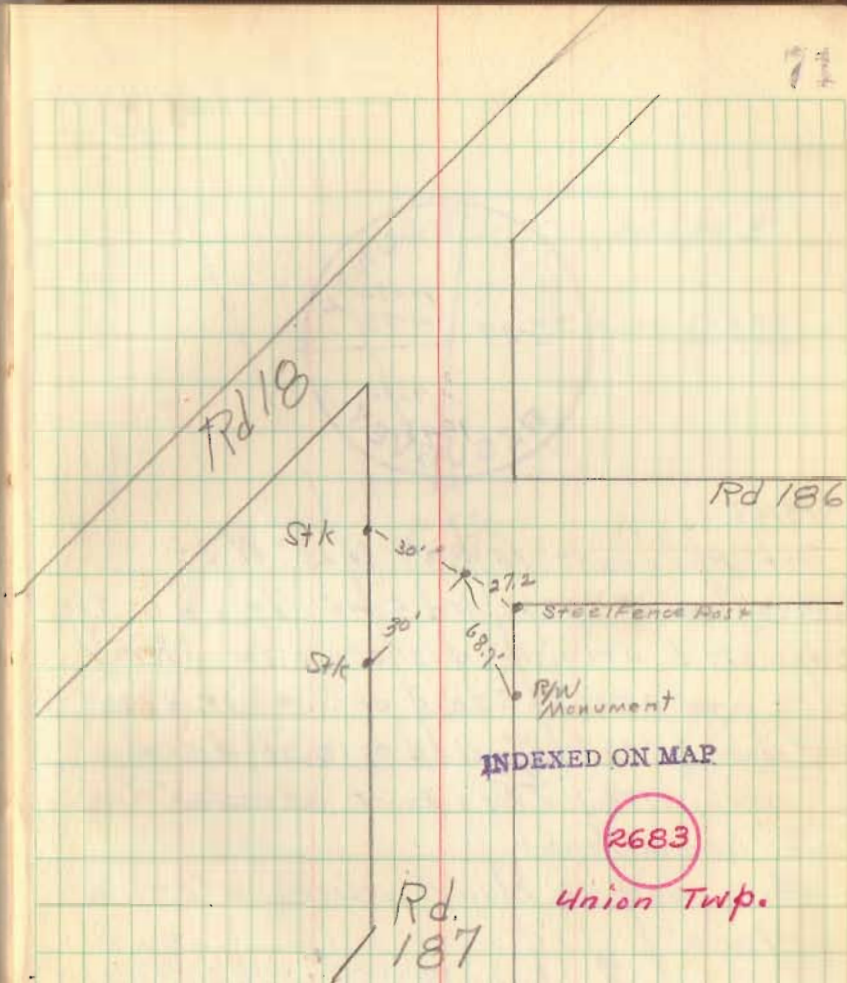

Witness
Field Book 654 P 48

Dakes
Lake