

Resurvey of CH 45  
 from CH 31 to CH 18  
 Union Township  
 Logan County O

+ 21.3

8

7

4

5

4

3

2

1

0

Concrete 11" W.C. to  
 19-25-24-30  
 Spike in br  
 31-3, 25 Cor  
 to 19 and 25 T3 R4  
 and 24 and 30 T4 R3

580 1/2 E

96

CA. M. Keck Co. Exp. 10-31-44  
 PA Hartman  
 H. E. Dysart  
 Geo. Drake  
 Homer Starns  
 Elmer Waples

12

Set hubs for M<sub>2</sub>  
 90° 30' 03" 1/2  
 Iron bar (found.)  
 of line  
 Set RR spike for M<sub>2</sub>

4407

INDEXED ON MAP

519, T R

Fence of 8" x 1" line

CH 31 Range Line

524 T R

Concrete 11"


CH 31 Section  
 Line

CH 31 Section  
 Line

529, T R

530 T R

20  
 19  
 18  
 + 85'  
 17  
 16  
 15  
 14  
 13  
 12  
 11  
 10  
 + 33  
 9

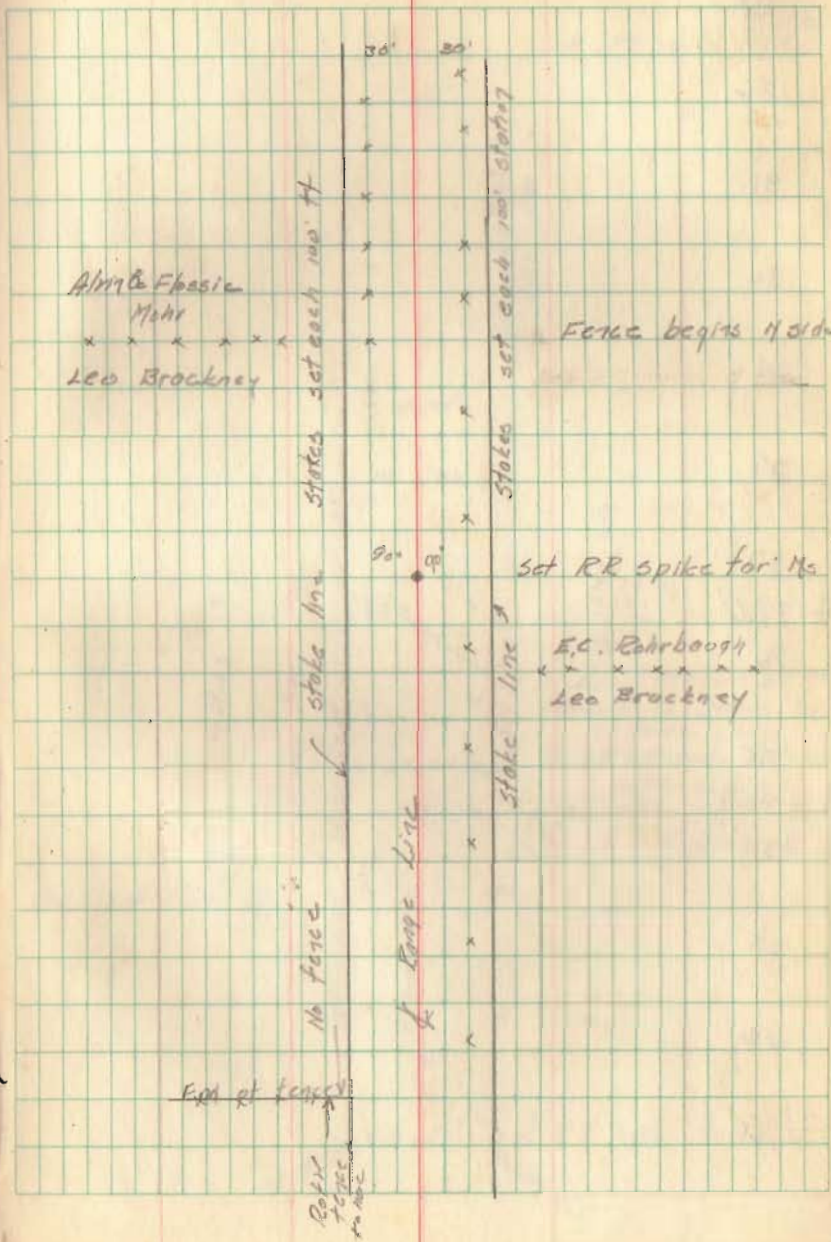



44

43

42

41

40

39

38


37

36

35

34

33

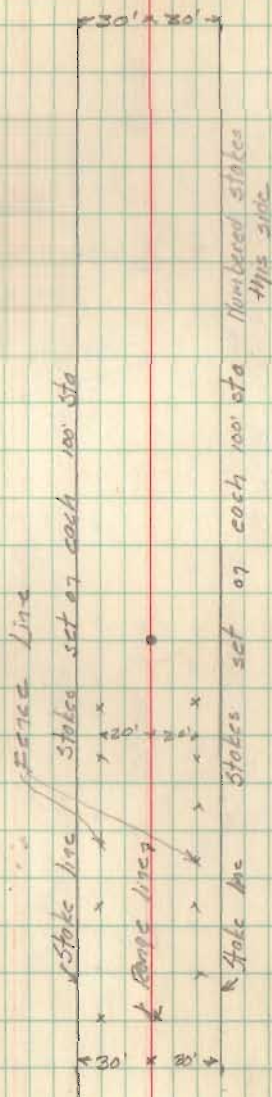

for the set RR spike out

+97.6'

53

52

51

50

49

48

47

46

45

$\frac{0^{\circ}-22' L}{0^{\circ}-45'}$   
 $\frac{0^{\circ}-22'-20' L}{0^{\circ}-45'}$

S. 13-3-14

Calvin R. Moore

Section line 22x50.0

Otto M. Mohr

S. 19-3-14

set RR spike for Ma

Range line

1/2 fence

set of call 100 5/16

Stakes set of call 100 5/16  
Numbered stakes of 1/2 5/16

Stake line

Range line

0.10'

Stake line

set RR spike for Ma

Concrete 14 (found)

S. 18-4-13

Upton J. Moore

Section line

Galen C. Custer dix

S. 24-4-13

64

63

62

61

60

59

58

57

56

55

5A

L95

11-1-44

C. A. Wallace  
D. A. Wortman  
H. E. Dycert  
Emer. Vaples  
Geo. Drake  
Homer Stevens

17

Martha Proter

+95 End of fence  
Colony R. Moore

< 30' 30' >

Stakes set on each 100' sta

set RR spike for Ms

Stakes set on each 100' sta

Stake line

change line

Stake line

no fence

< 30' 30' >

Set RR spike for Ms

75

74

73

72

71

70


69

68

67

66

65

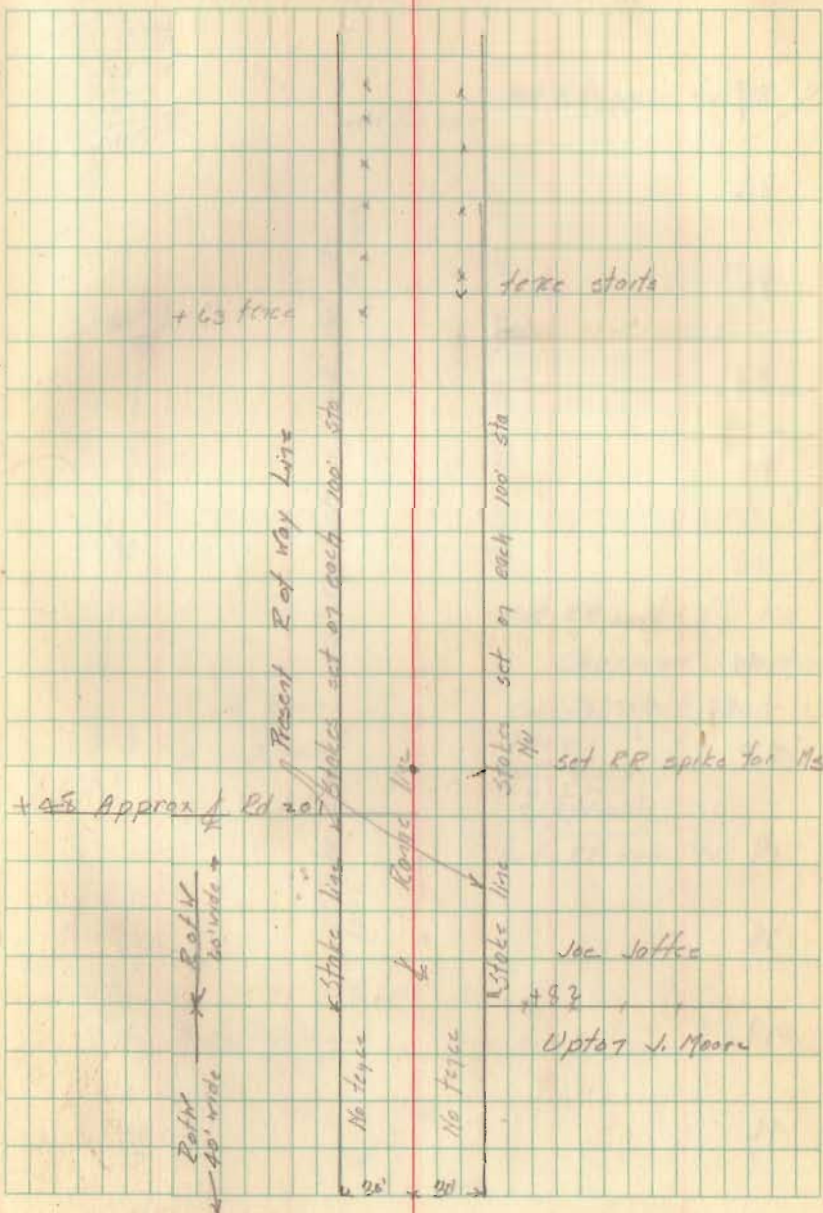

87

86

85

84

83

82

81

+28.7 00.07' R

80

79

78

77

76


2028.7  
77.784

22823  
80725  
17965  
19671  
2302  
249525

f 31.9

612

19

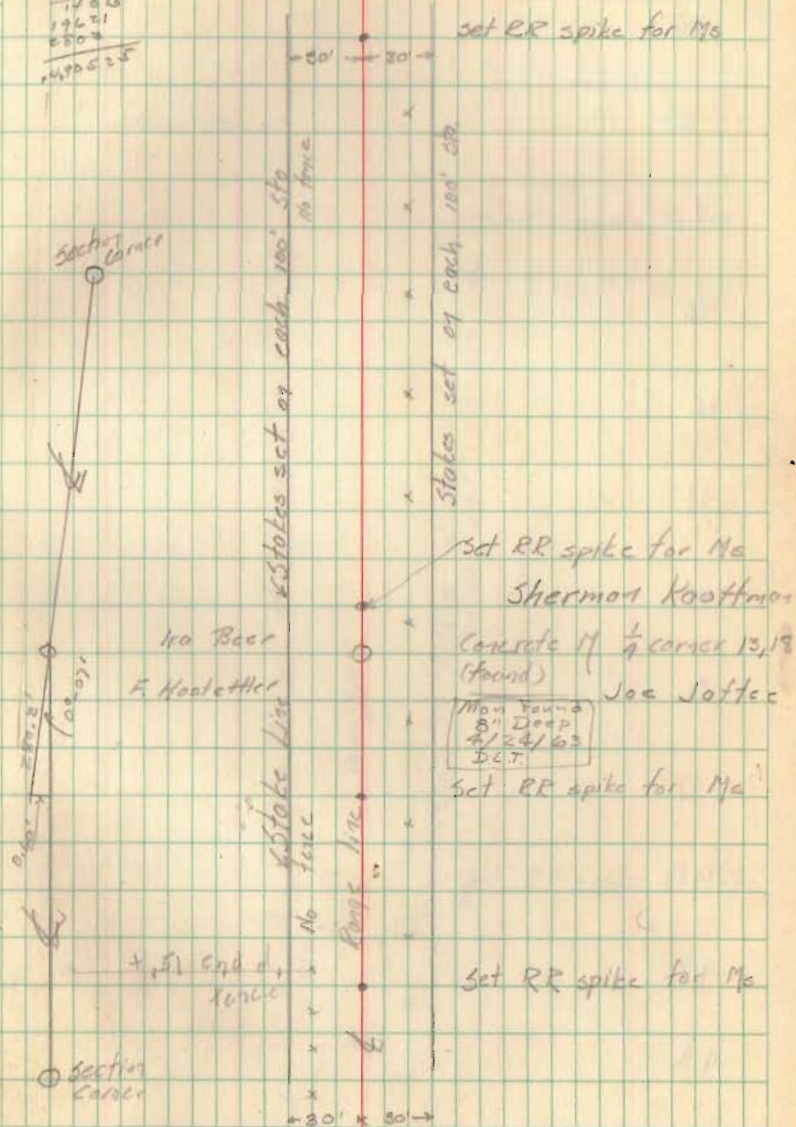



99

98

97

96

95

94

93

92

91

90

89

88

Fence stakes

1 stake line stakes set at each no. Sta

No fence

Fence line

1 stake line / 150 ft line set at each no. Sta

Numbered stakes at this side

Fence line

+70

set RR spike for Ma

set RR spike for Ma



111

112

113

114

115

116

117


118

119

120

121

122

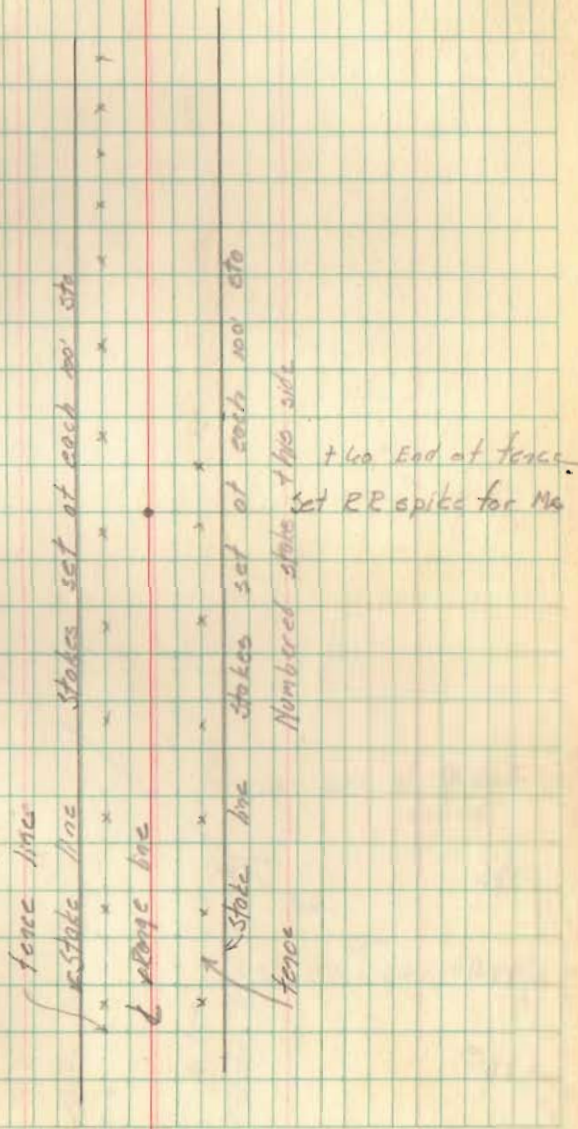

+21.7

125

12A

123

27  
21.7  
5.0

23

