

Roth to Smith Survey Description

February, 1972

Being situated in Union Township, Logan County, Ohio; and being a part of Section 13, Town 3, Range 13.

Beginning at a corner post in the east line of said Section 13 that bears North 803.0 feet from the southeast corner of Section 13.

Thence S  $69^{\circ}$  - 16'W 591.5 feet to a iron.

Thence S  $4^{\circ}$  - 56'W 139.5 feet to a iron.

Thence S  $6^{\circ}$  - 51'W 127.5 feet to a iron.

Thence S  $89^{\circ}$  - 56'W 161.5 feet to a iron at the southeast corner of a 118.12 acre tract.

Thence with the east line of said 118.12 acre tract North 1417.5 feet to a iron.

Thence N  $89^{\circ}$  - 25'E 742.0 feet to a iron.

Thence South 950.0 feet to the place of beginning.

Containing 19.43 acres more or less. Being surveyed from a 23.65 acre tract.


---

Owen K. Shirk  
Surveyor 4271

INDEXED ON MAP

5050 1D

ROTH to SMITH SURVEY  
 UNION TWP., LOGAN CO., OHIO  
 SECTION 13, TOWN 3, RANGE 14 - 1" = 300'

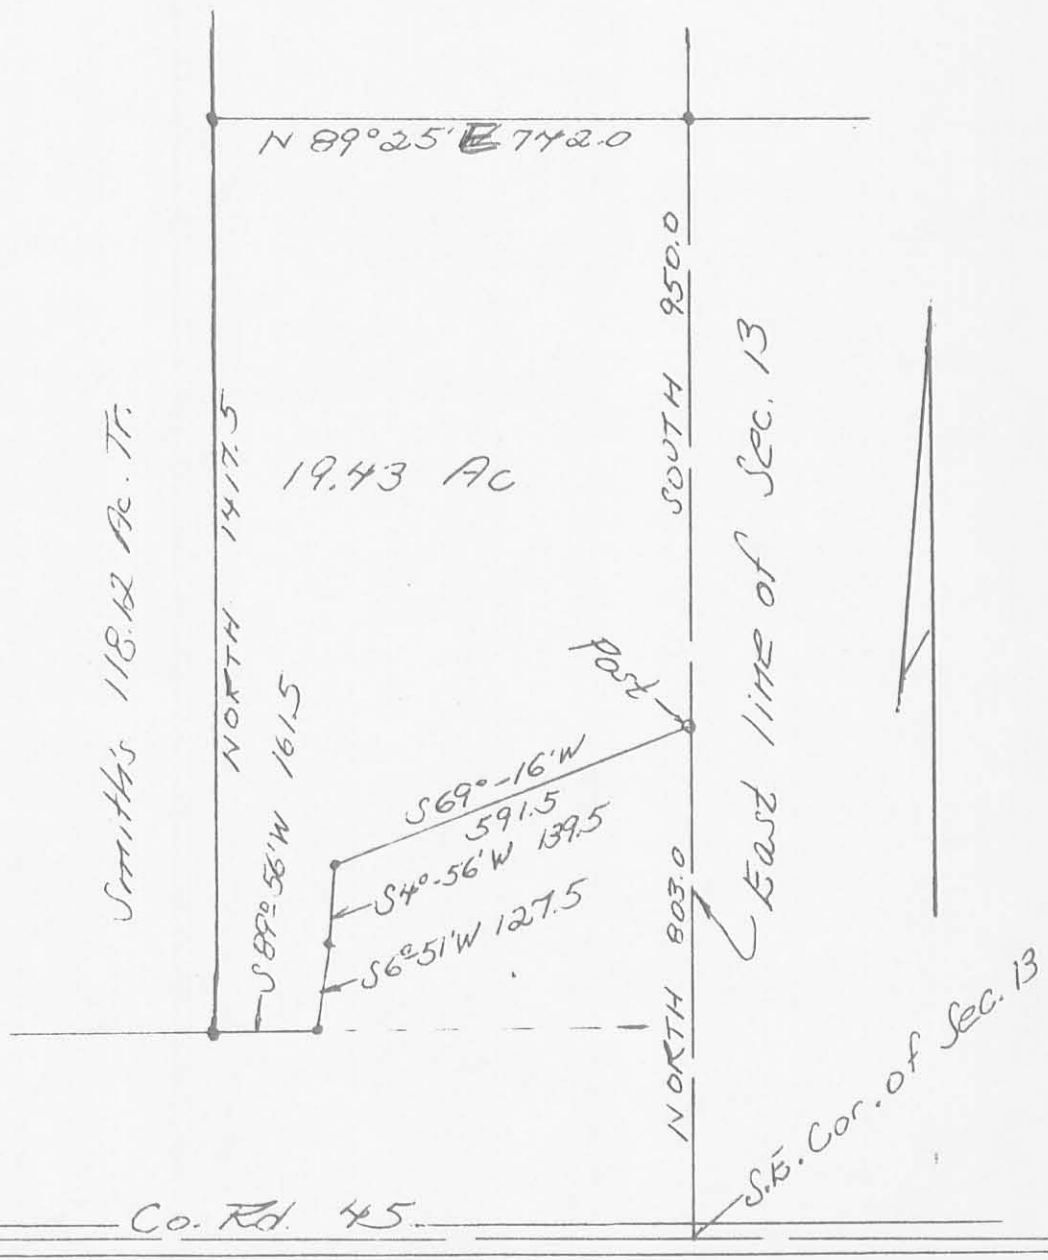

Owen K. Shirk  
 Surveyor 4271  
 Surveyed: 2-19-72