

Survey For Nathan I. Coon (Near Loperium)

(Copied from Book # 384 Page 82)

See Book 390 Page 3 for later survey.

See Book D Page 84



James T. Campbell

TO
Nathan I. Coon


Logan Co. Deed Book # 127 Page 492

Range 8 Town 6 Sec. 36.

Note that this deed description

is from previous survey.

A - 2" x 2" x 24" Nails
 B - 2" x 2" x 24" Nails
 C - Pipe found
 D - Steel Fence Post
 E - 2" x 1" Highway Stake found
 Marked 241

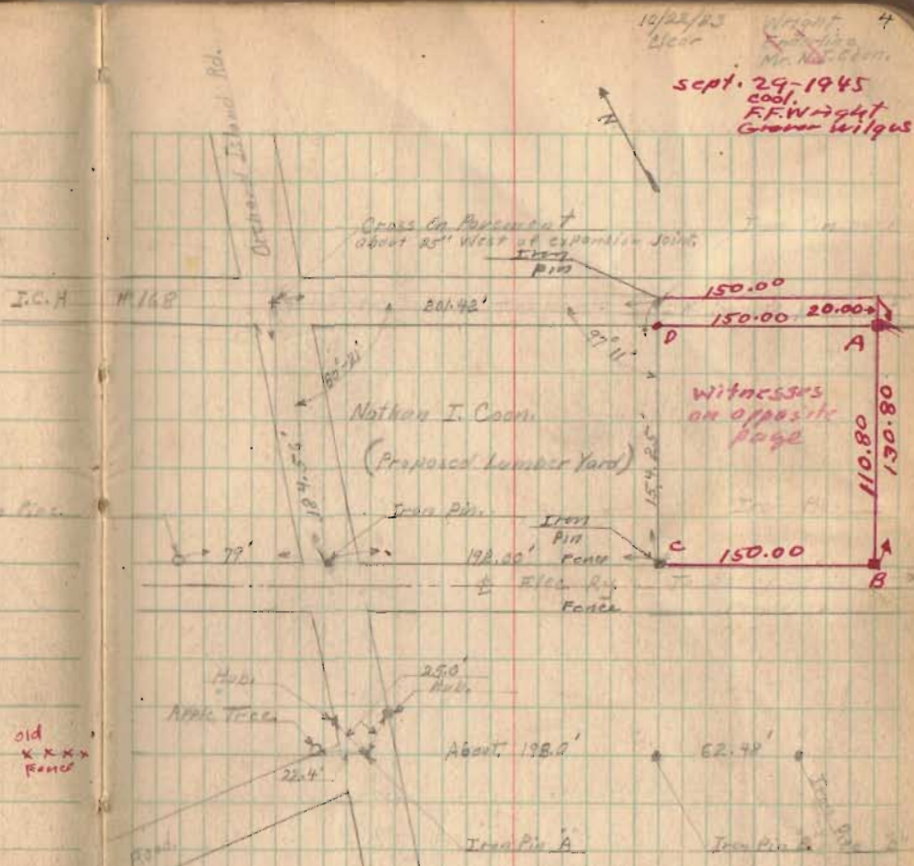

Note:-

Iron pin A or B or
pipe C were found but
were not used in this
survey.

INDEXED ON MAP