




- A - same as A Page 15
- B 20' from Iron Post.  
B is 3'-6" North of line CA.
- See Drawing in Drawer G14
- C Stone
- D - Iron Placed.

July-12-1926  
 17

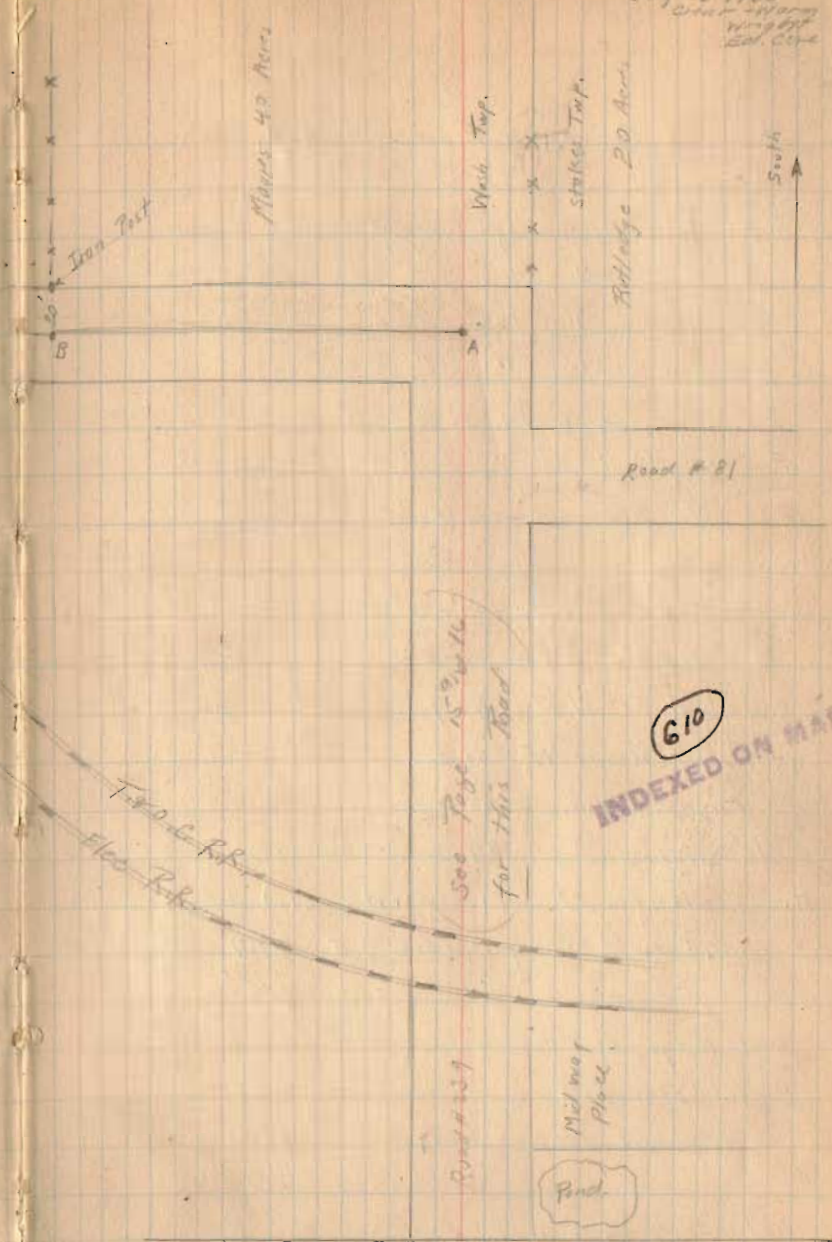

I.C.R. Concrete Road To Lakeview →

Indian Lake.

INDEXED ON MAP

610