


Hicks Survey (Continued.)

9-8-30

41

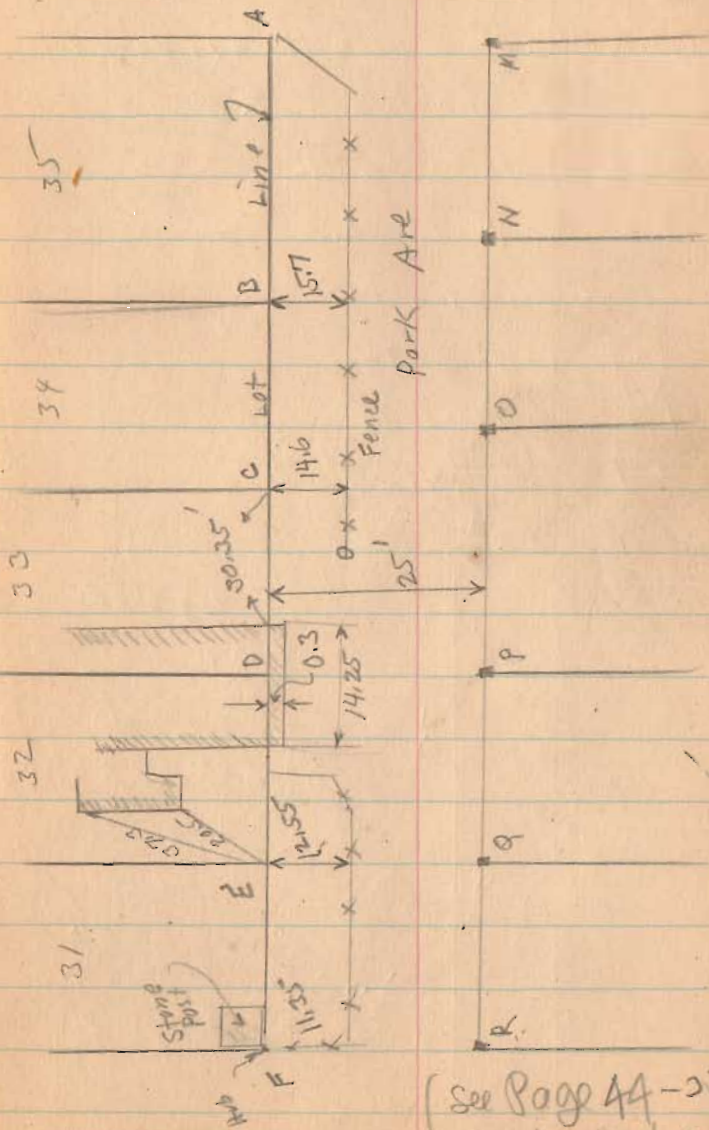

(See Page 44-32
Note Dates)