

Road 241 and 61 Wash Tap

For Notes as to line see
M^s Kinnans field book #2 pp 58
#1 pp 1 -

1305
INDEXED ON MAP

Road 241, 61

Minnie L
Marhadale

Minnie L Marhadale




0+00

1 CH 24 TO De Groot

Road 61

1305
INDEXED ON MAP

5

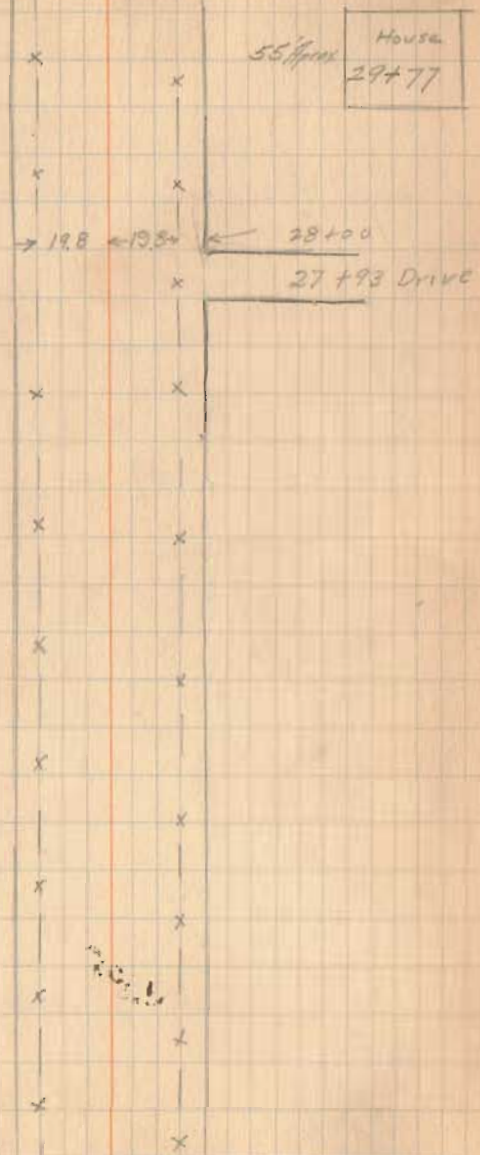

92
 40 + 00

 52 + 00
 33

Bridge

1500 County + Imp

92
 74 + 00

 18.00
 29.00
 15 -



 52

Town
 County
 Town + County

41 70
 41 + 30

 6.40

1305
 INDEXED ON MAP

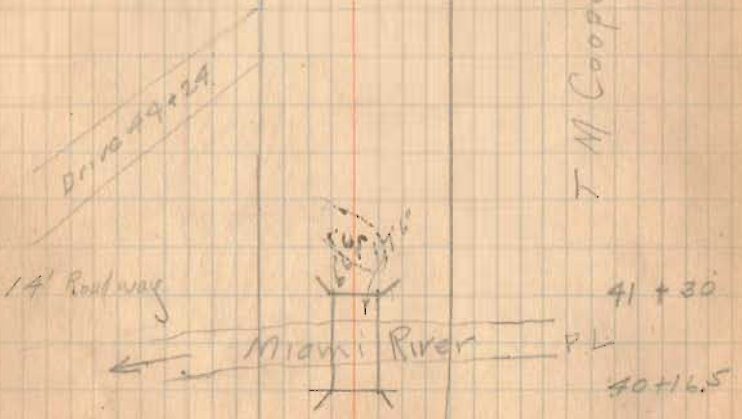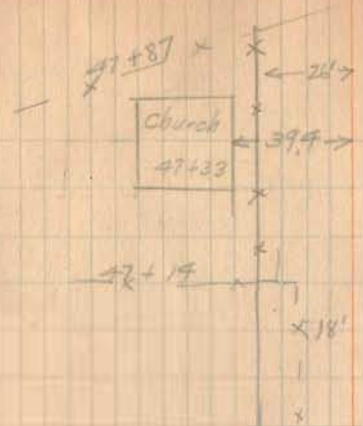


T M Cooper

$$\begin{array}{r} 54.87 \\ 49.51 \\ \hline 5.36 \end{array}$$

$$\begin{array}{r} 49.51 \\ 41.30 \\ \hline 8.21 \end{array}$$

1705
INDEXED ON MAP

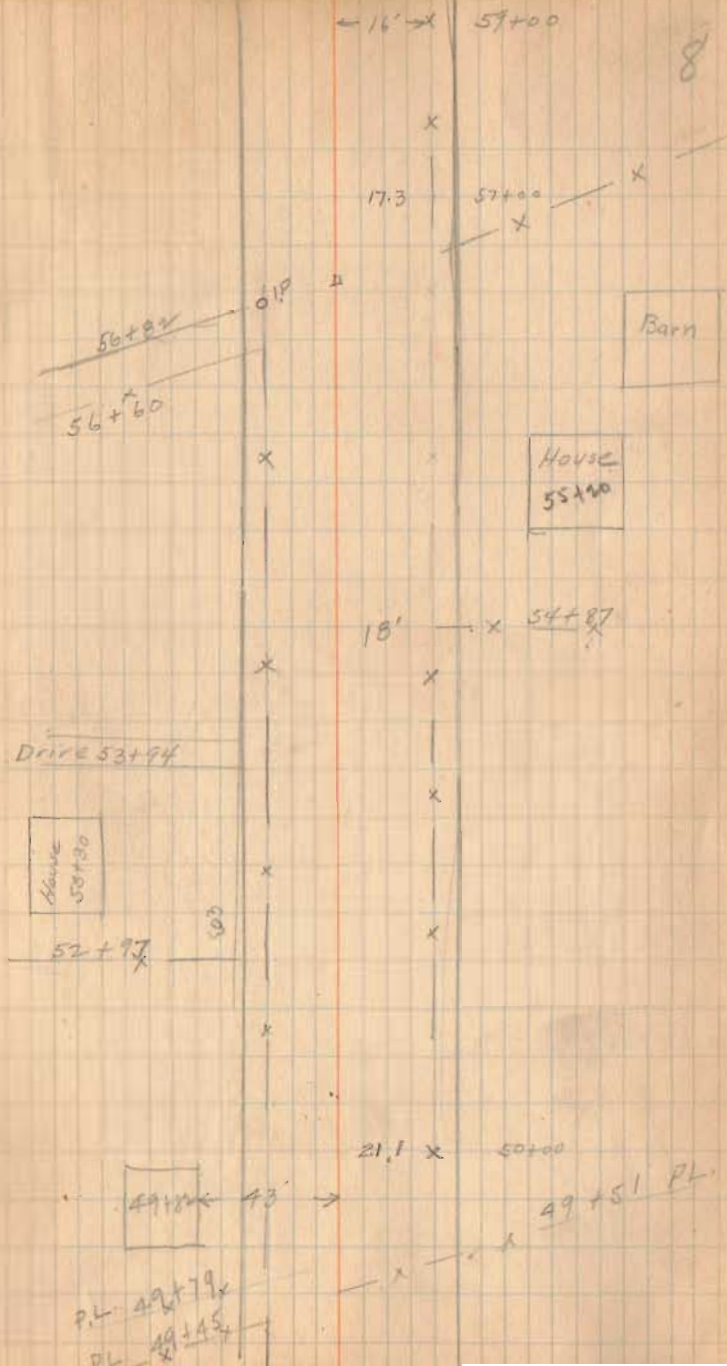

9

15' 66+74

16+85
HOUSE

15' x 66+77 x
66+60

65+77

64+65

Barn

15' x 63+00

street

62+38

HOUSE
62+10

Building
57+
61+98


57+90 PL
DRIVE 57+80

57+89

57

1205
INDEXED ON MAR

1205

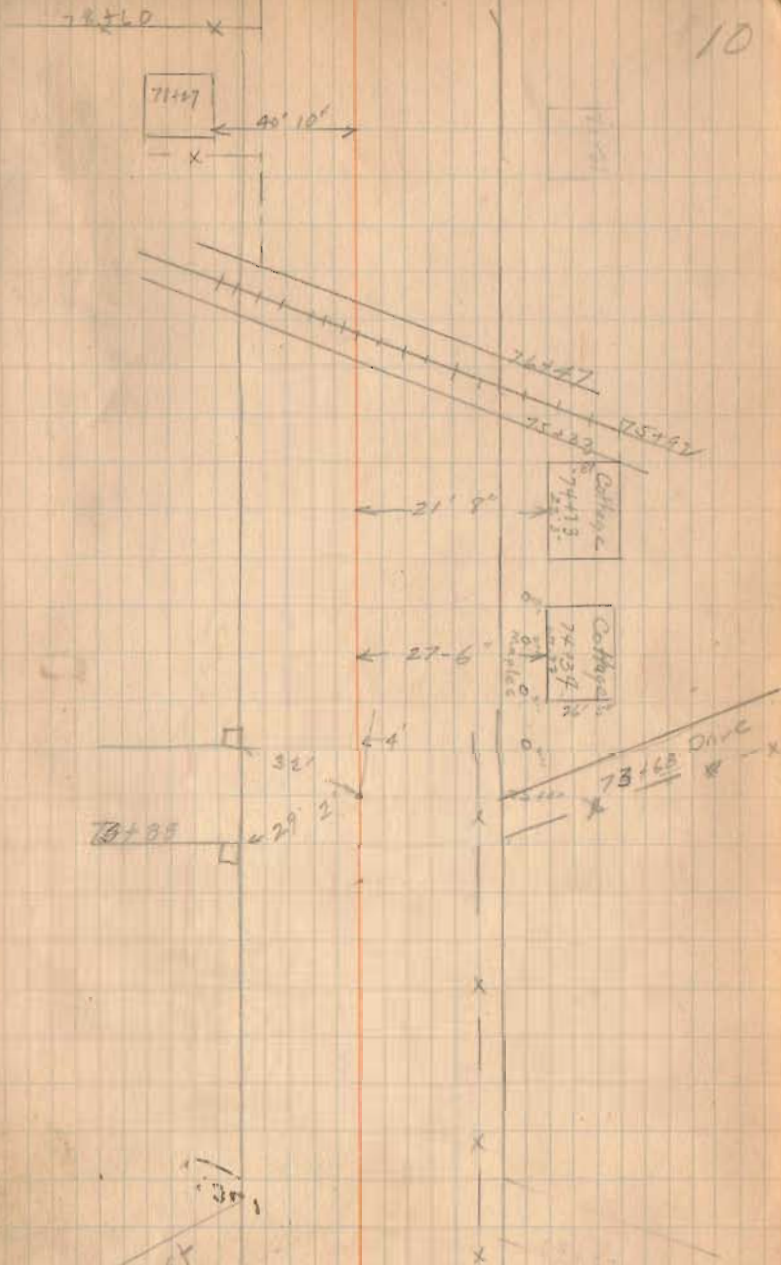

1705
INDEXED ON MAP


30'
R.K. ST
8+67

155 68+00

see line
Taylor Road

1.8

98.5
113
58
85 + 98.1

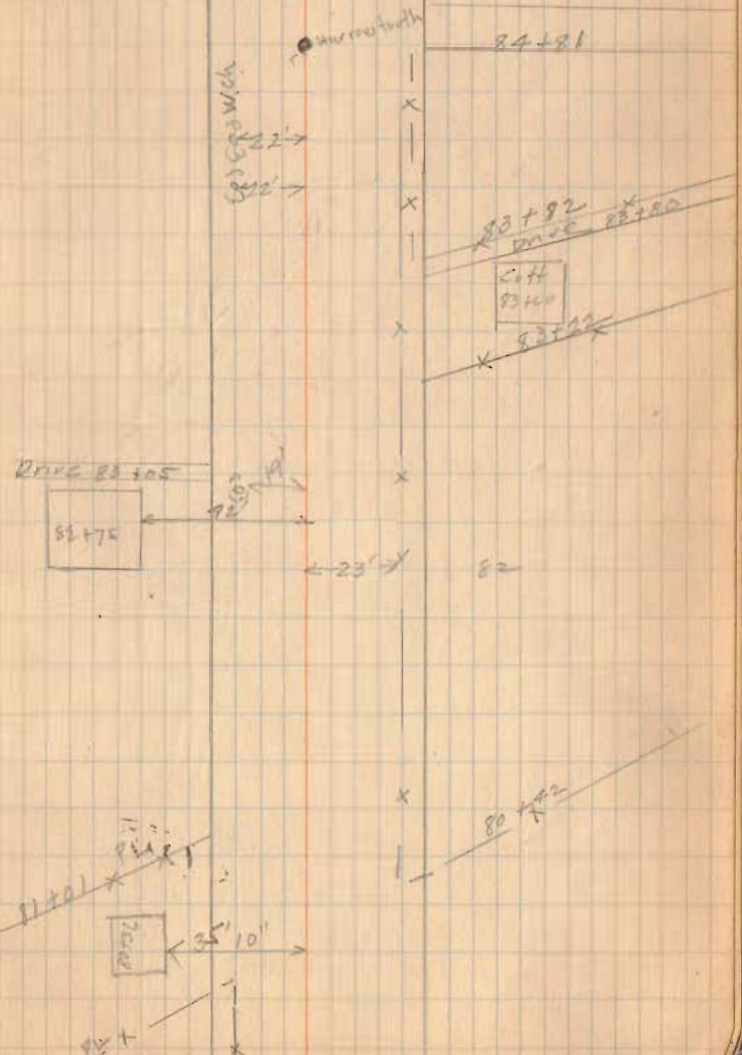


1305
INDEXED ON MAP

IP 90+91 x x

Chip Electric 90+70



28+88
 1603
 6-20-37

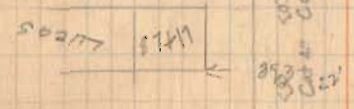

INDEXED BY MAP (504)

