


Orchard Island
 Lot: 257

Apr 1 - 16 - 1955
 Cold.
 F. Wright
 E. Curt
 J. Montgomery

(see Page 16)

■ Hubs 24" long
 ● Iron

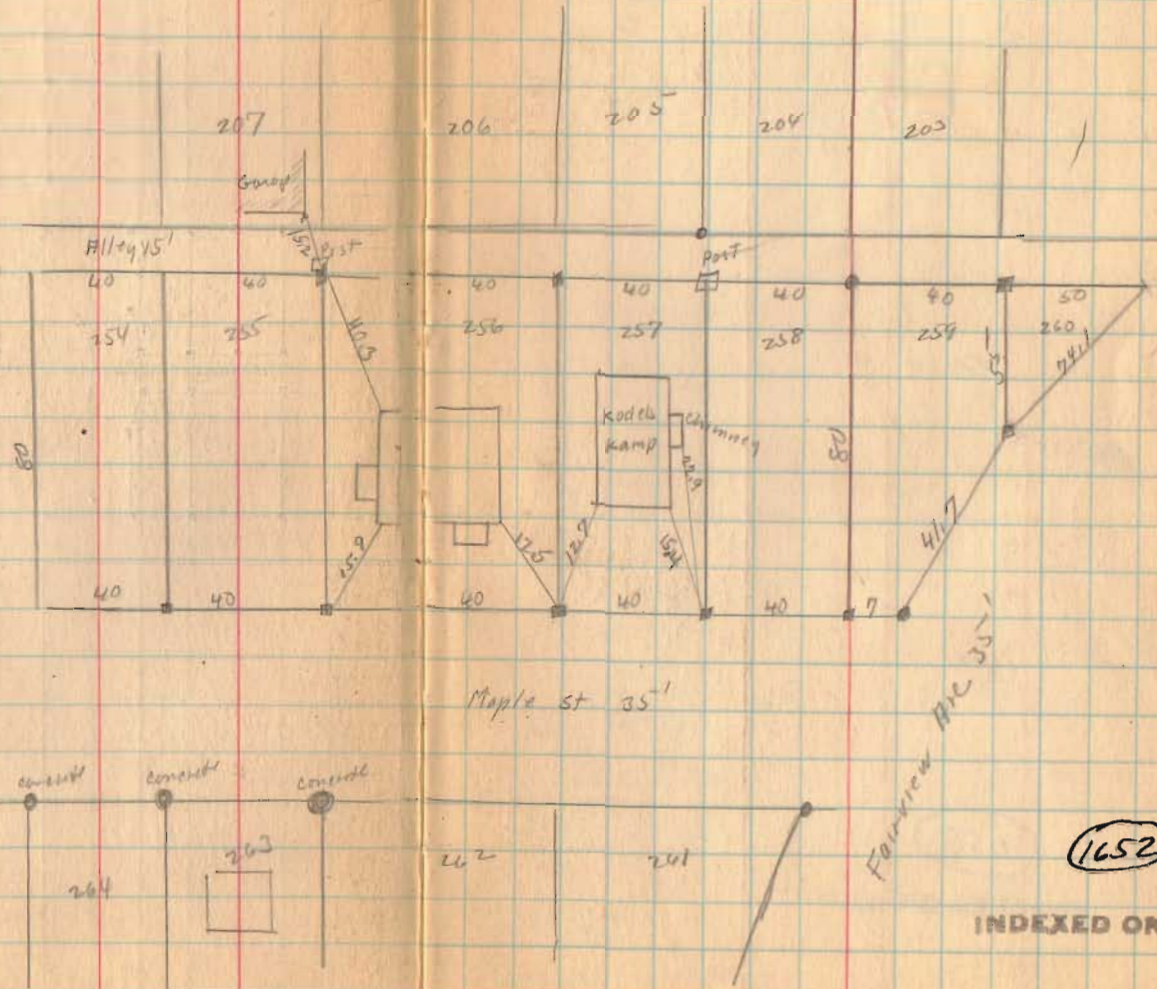

1652

INDEXED ON MAP