


ORCHARD ISLAND

1691
INDEXED ON MAP
Drawn by
Washington, Tenn.

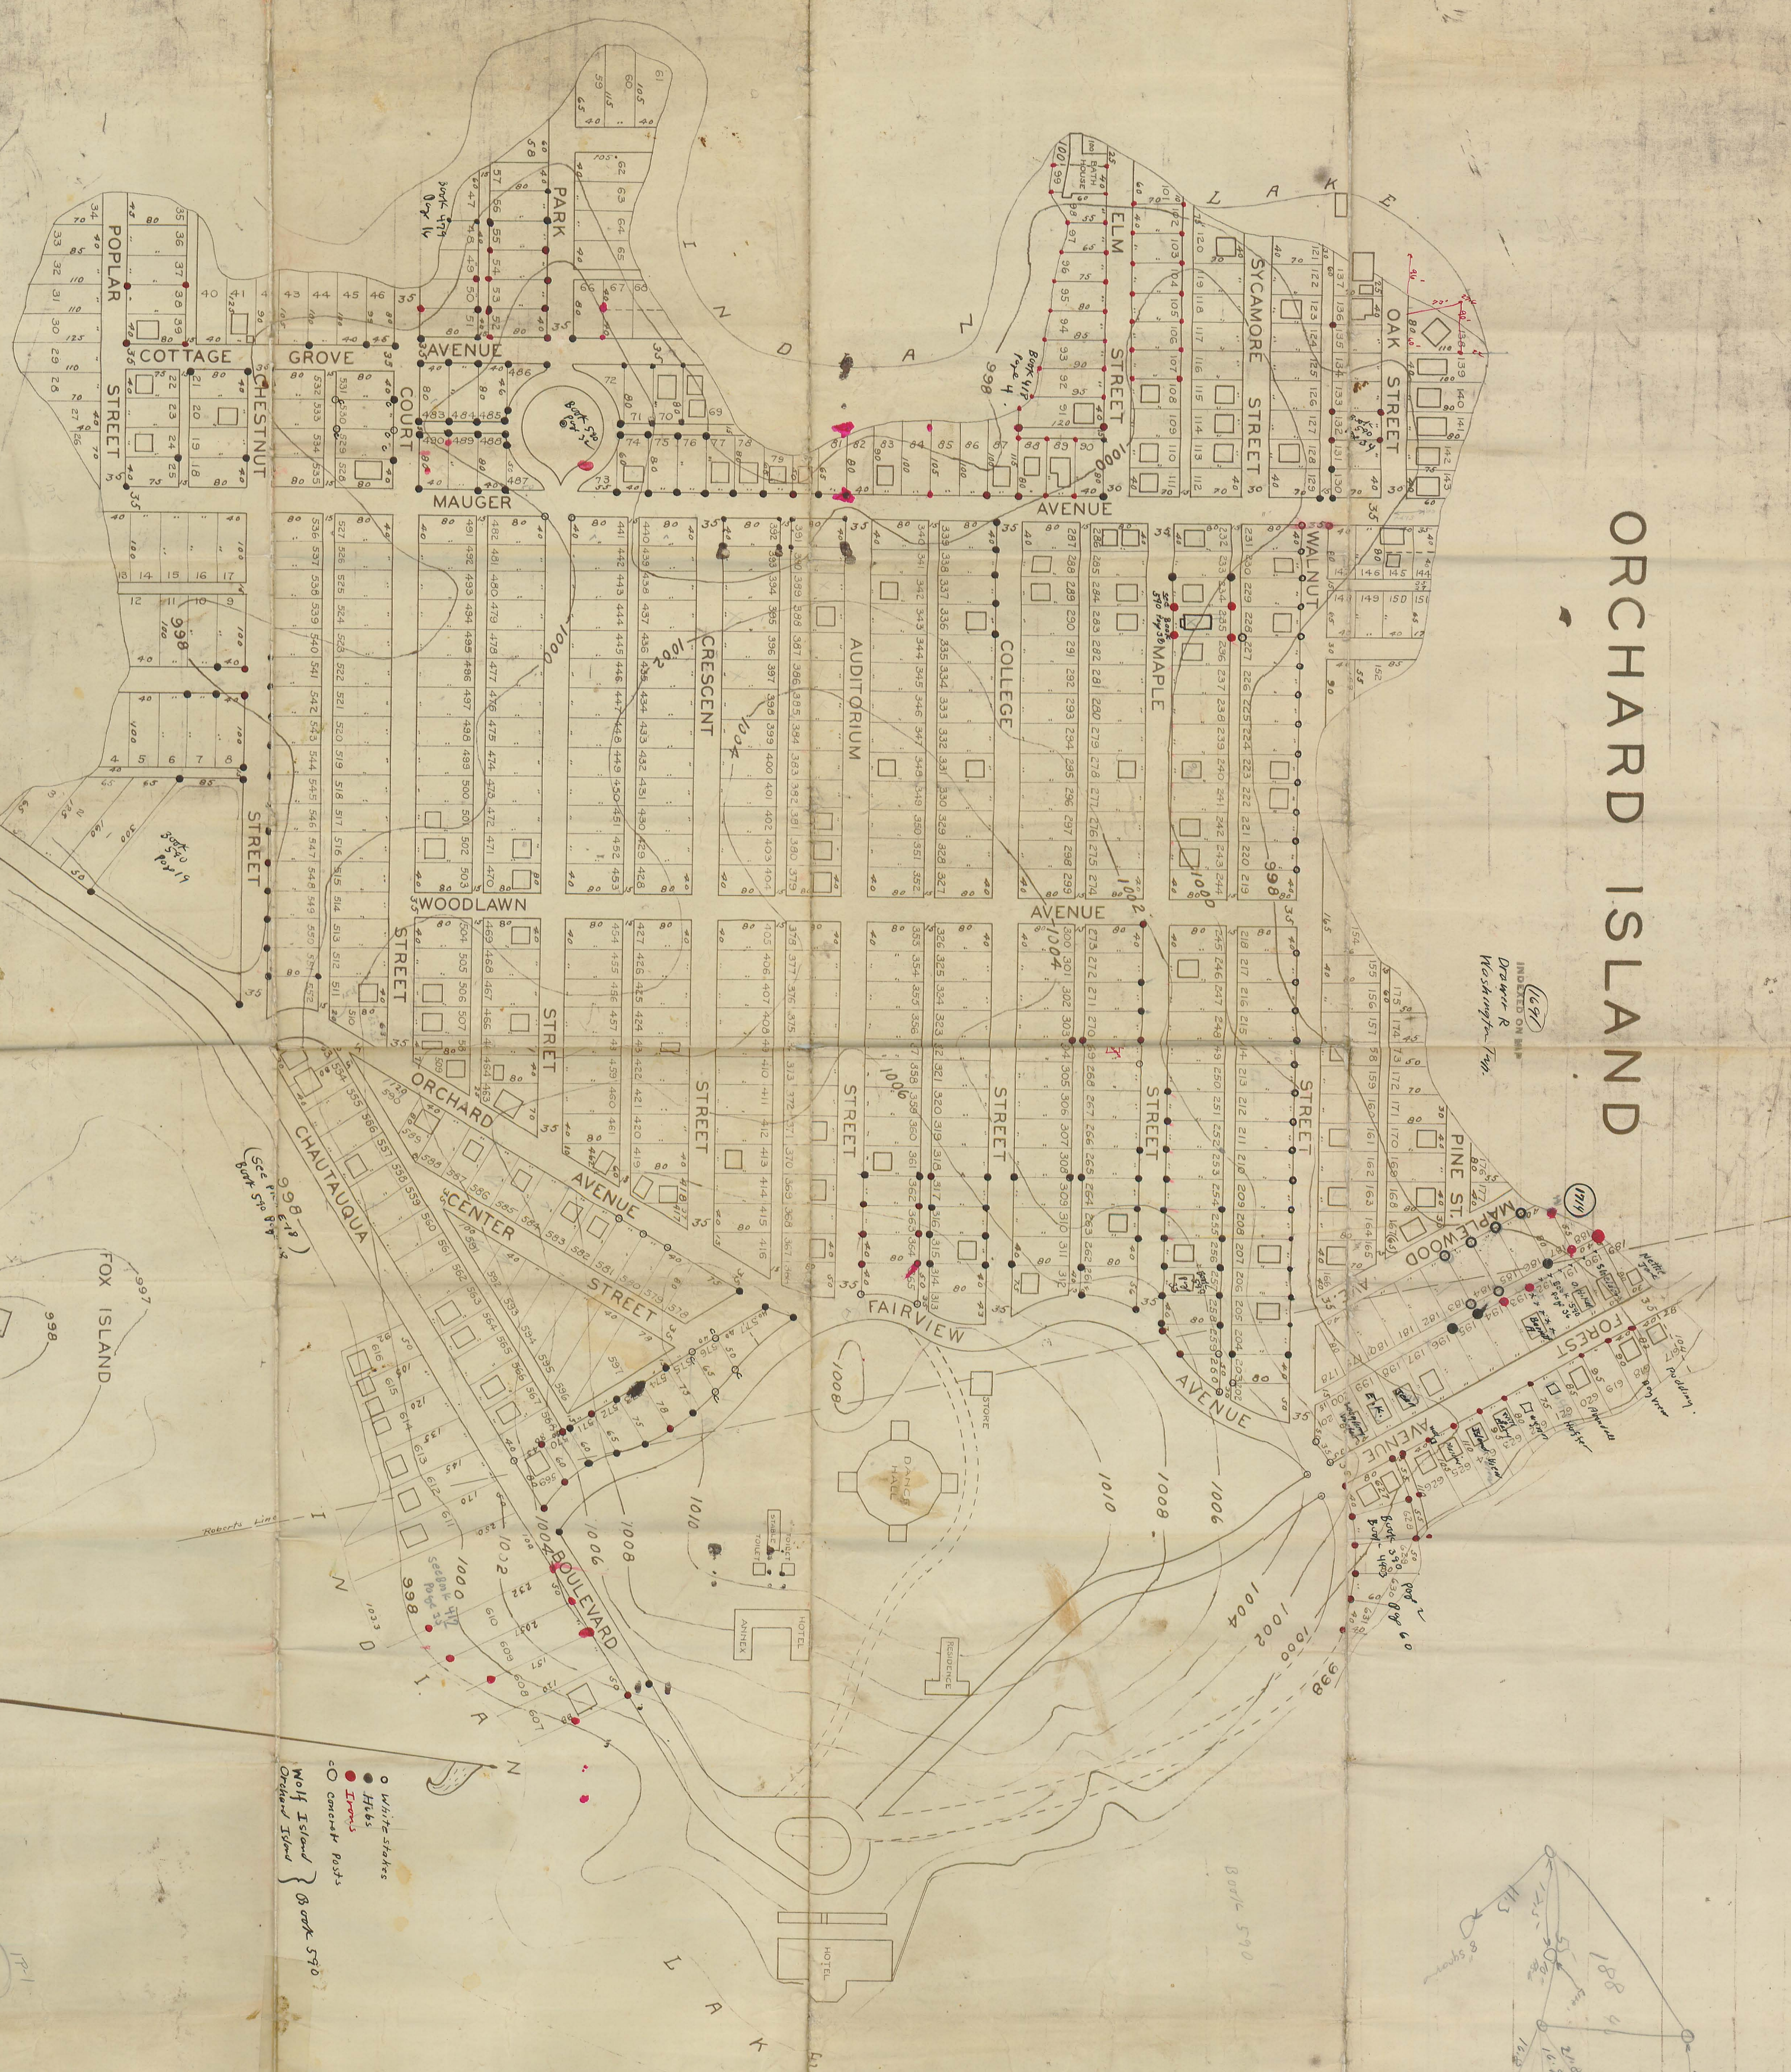


- White stakes
- Hubs
- Irons
- concrete posts
- Wolf Island } Book 590
- Orchard Island }

SCALE: 1 INCH = 100 FEET

INDEXED ON MAP
1691

ORCHARD ISLAND

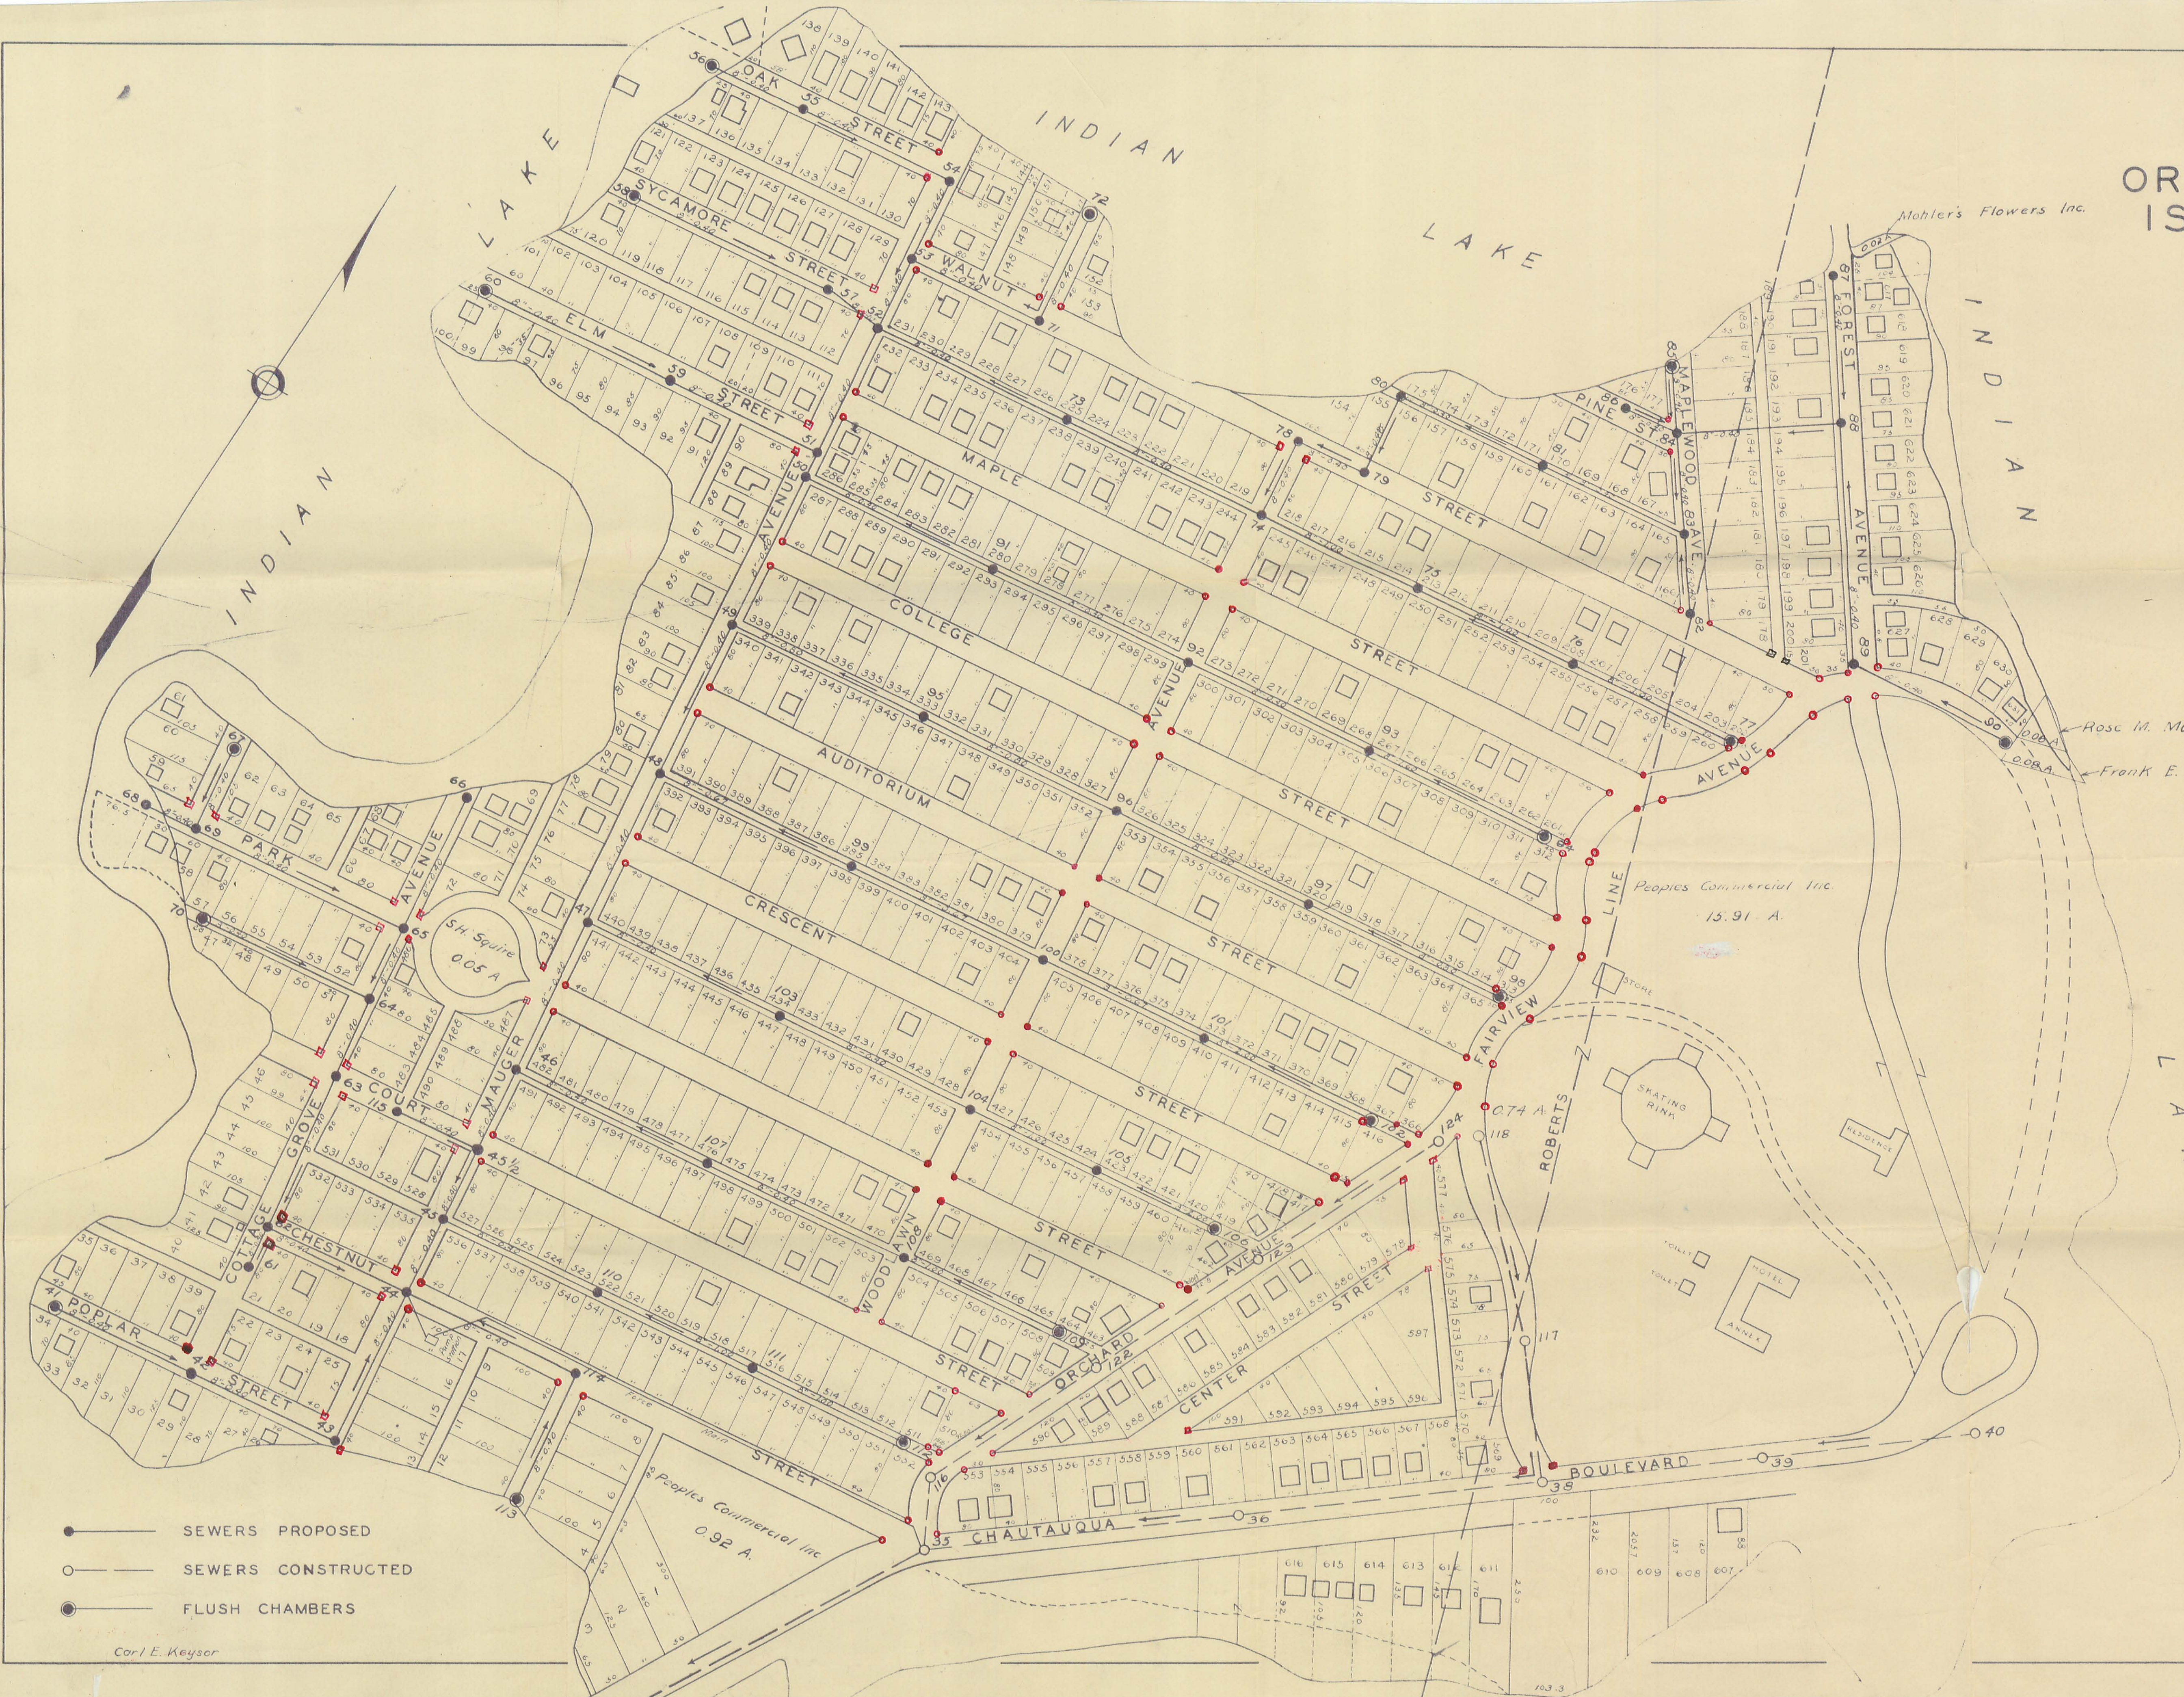

- Iron Bar
- R/R Monuments
- Hubs

Corners Set 1940 Survey
Field Book No. 652

INDIAN LAKE SANITARY SEWER DISTRICT LOGAN COUNTY OHIO SANITARY SEWERS EXTENSION NO. 6

SCALE: 1" = 100' DECEMBER, 1939
CLAIR A. INSKEEP
COUNTY SANITARY ENGINEER

- SEWERS PROPOSED
- SEWERS CONSTRUCTED
- FLUSH CHAMBERS

INDEXED ON MAP
11691 11692



8" Hickory

19.7

2x2 C.I.
R/W Mon

35.0

8" Hickory

4.0

1 1/2" Iron

CHESTNUT STREET

54.1

59.4

38.2

2x2 C.I.
R/W Mon.

18.5

15" Elm

MAUGER AVE.

1 1/2" Iron

27" Oak

3.4

MAUGER AVE. ^{opp}

CHESTNUT ST.

1691 IP-3
1705

INDEXED ON MAP



COURT ST.

LOT NO 511

LOT NO 510

ORCHARD AVE.

ALLEY

ALLEY

LOT NO 551

LOT NO 552

LOT NO 553


CHAUTAUQUA BOULD.

CHESTNUT ST.

STUMPPS GROCERY


1691
124

CHESTNUT ST. CHAUTAUQUA BOULD. ORCHARD AVE. COURT ST.

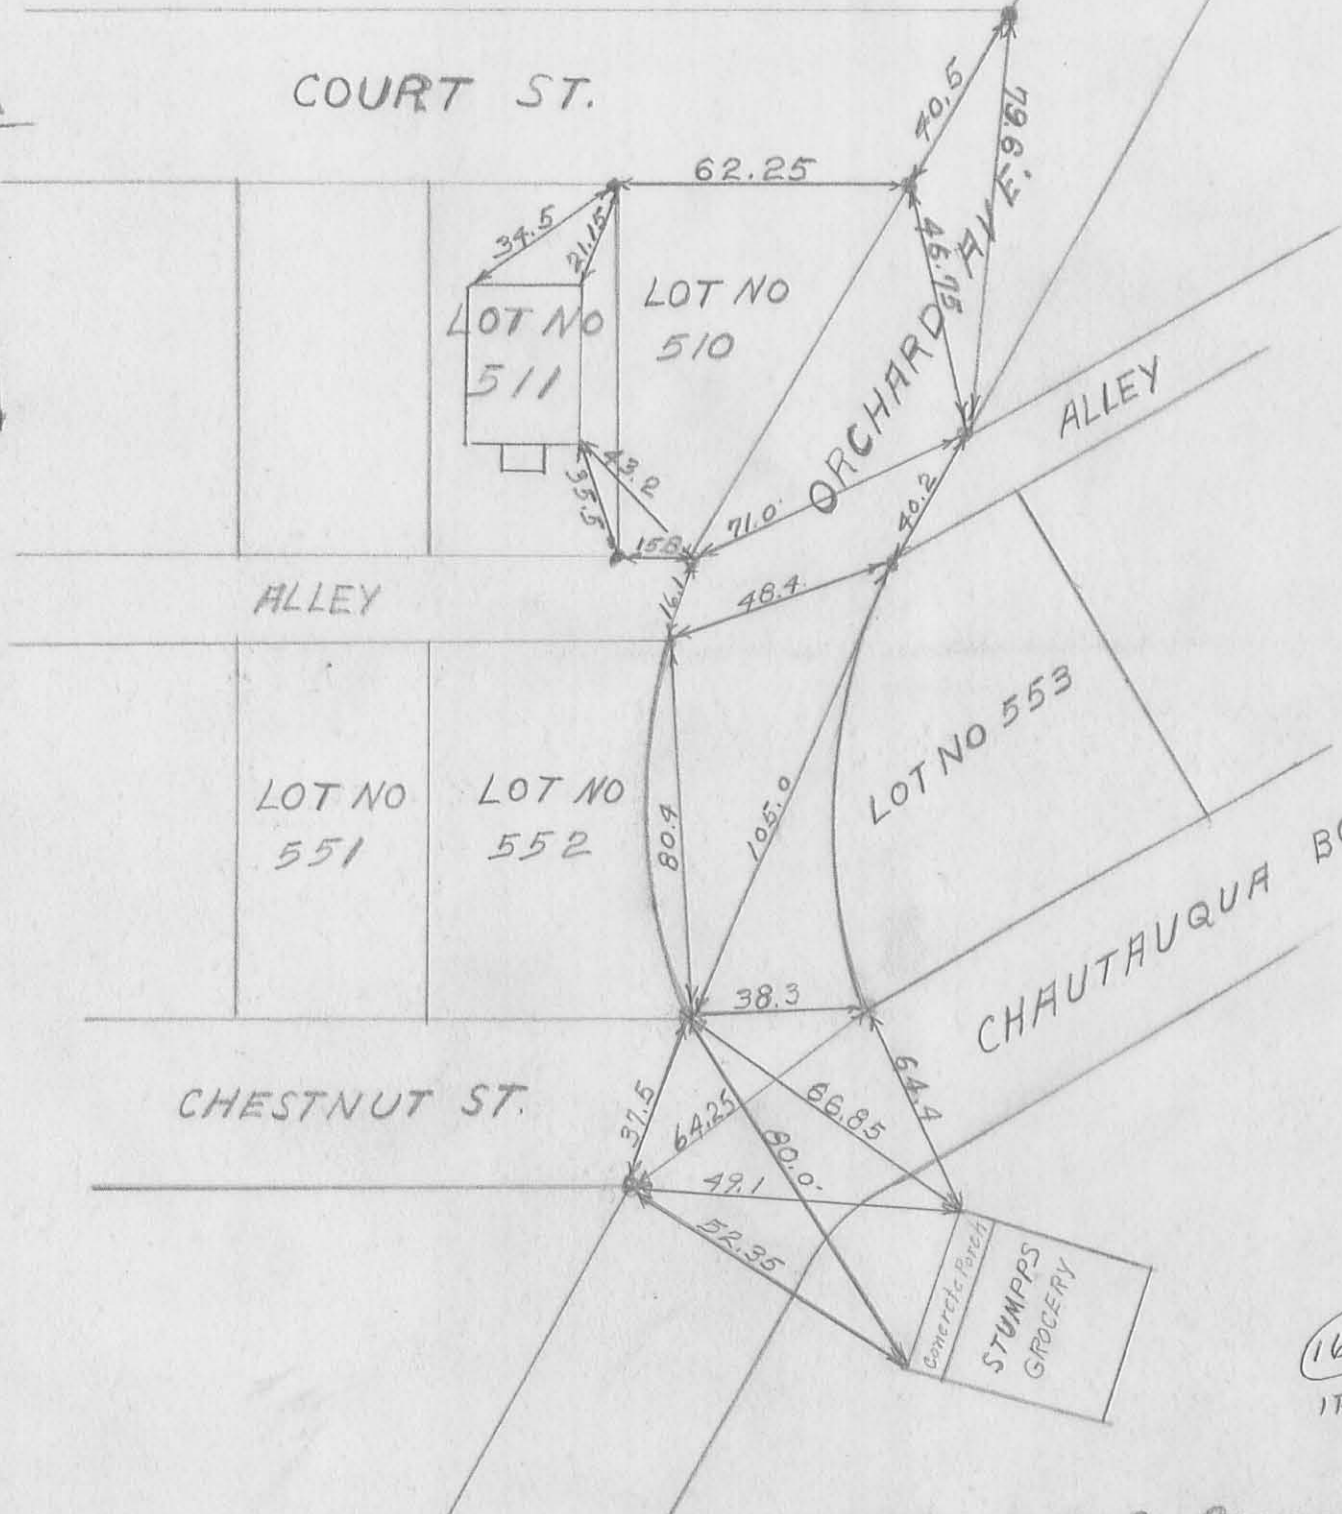



WOODLAWN AVE.

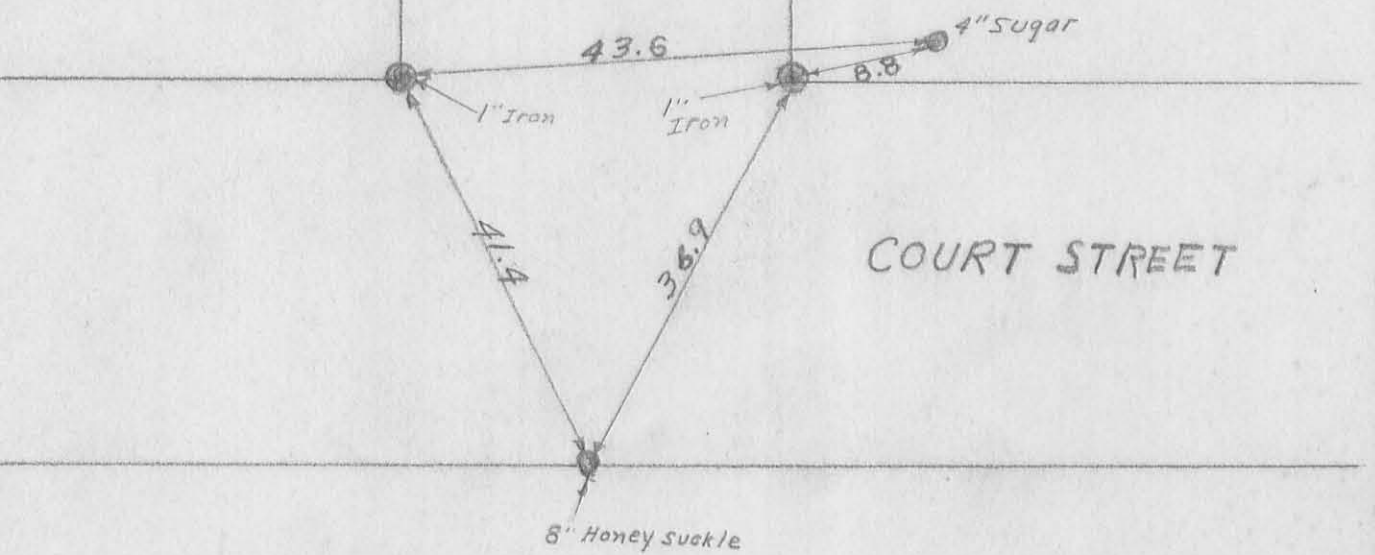


COURT STREET

8" Honey Suckle


1691
1P-5

COURT STREET ^{2nd} WOODLAWN AVE.

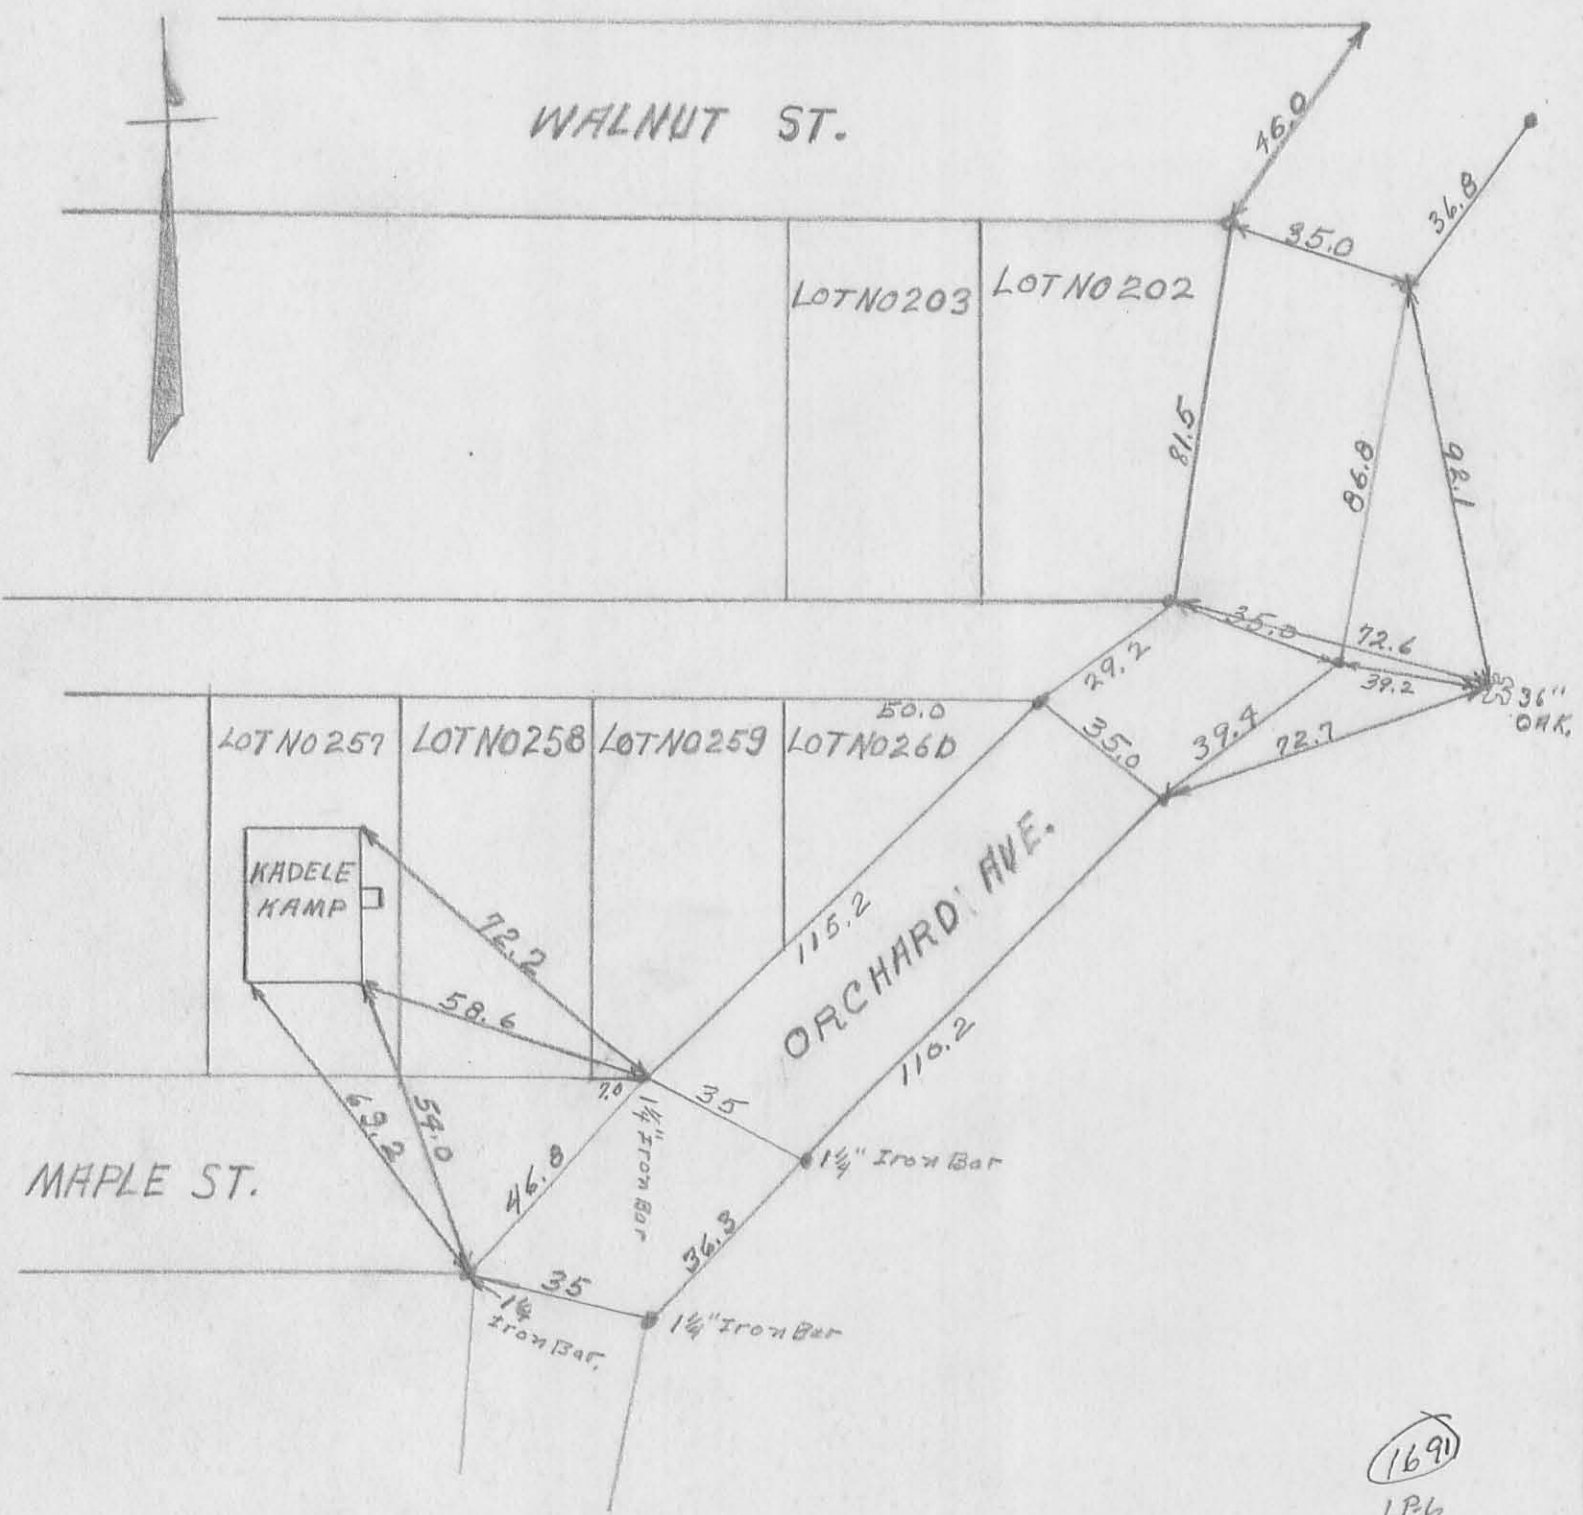


1691
 1 P 6

MAPLE ST. WALNUT ST ^{AND} ORCHARD AVE.

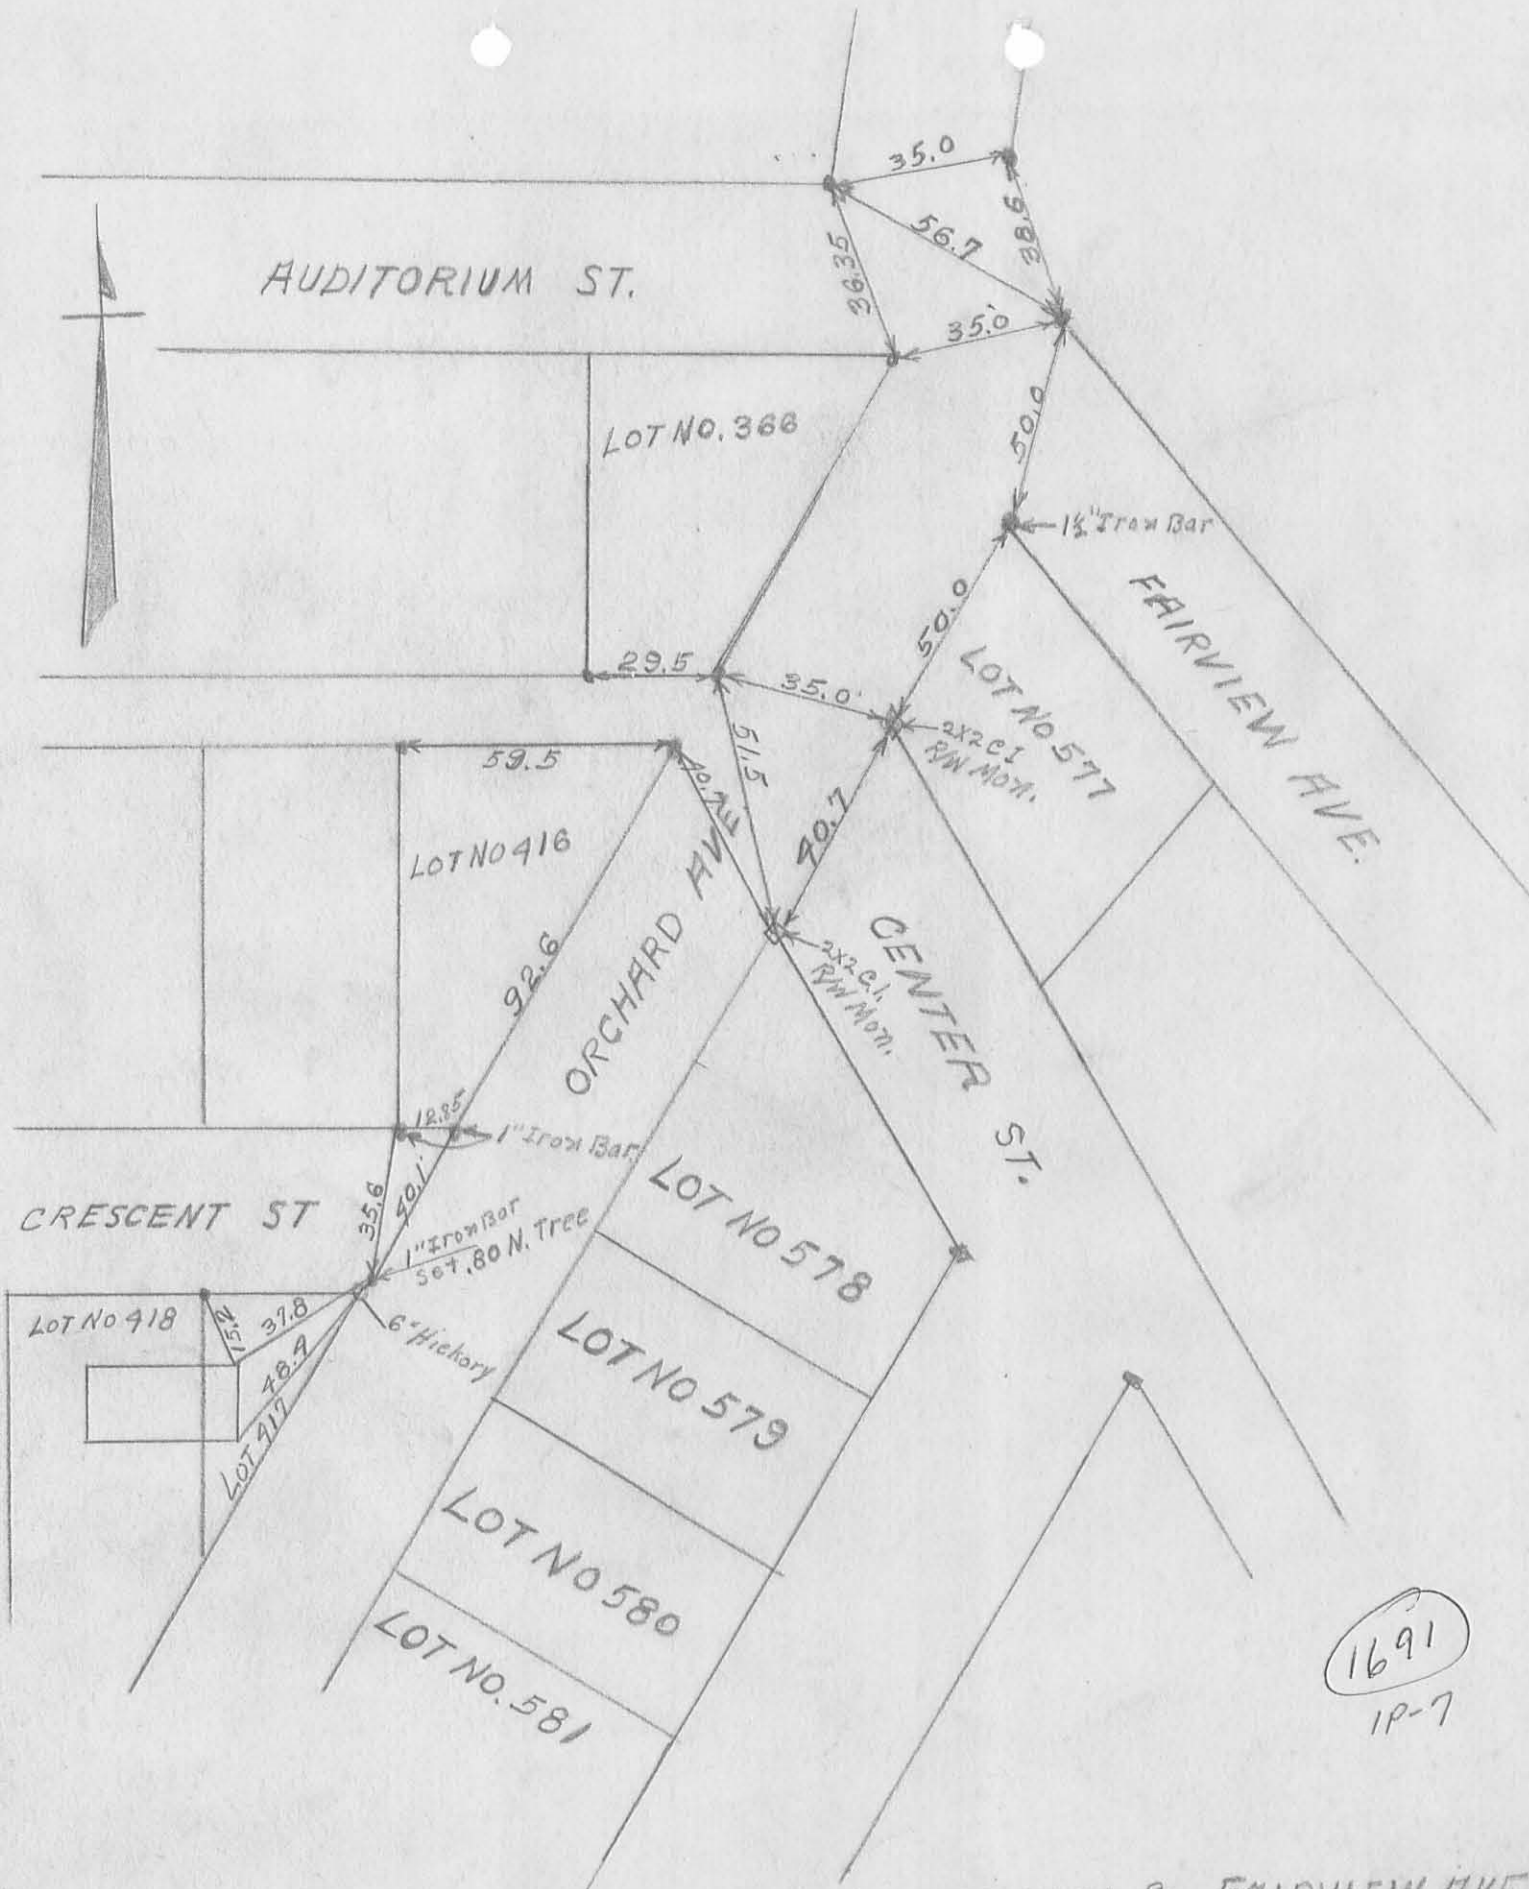


1691
1P-7

CRESCENT ST ORCHARD AVE. CENTER ST. AUDITORIUM ST. FAIRVIEW AVE.

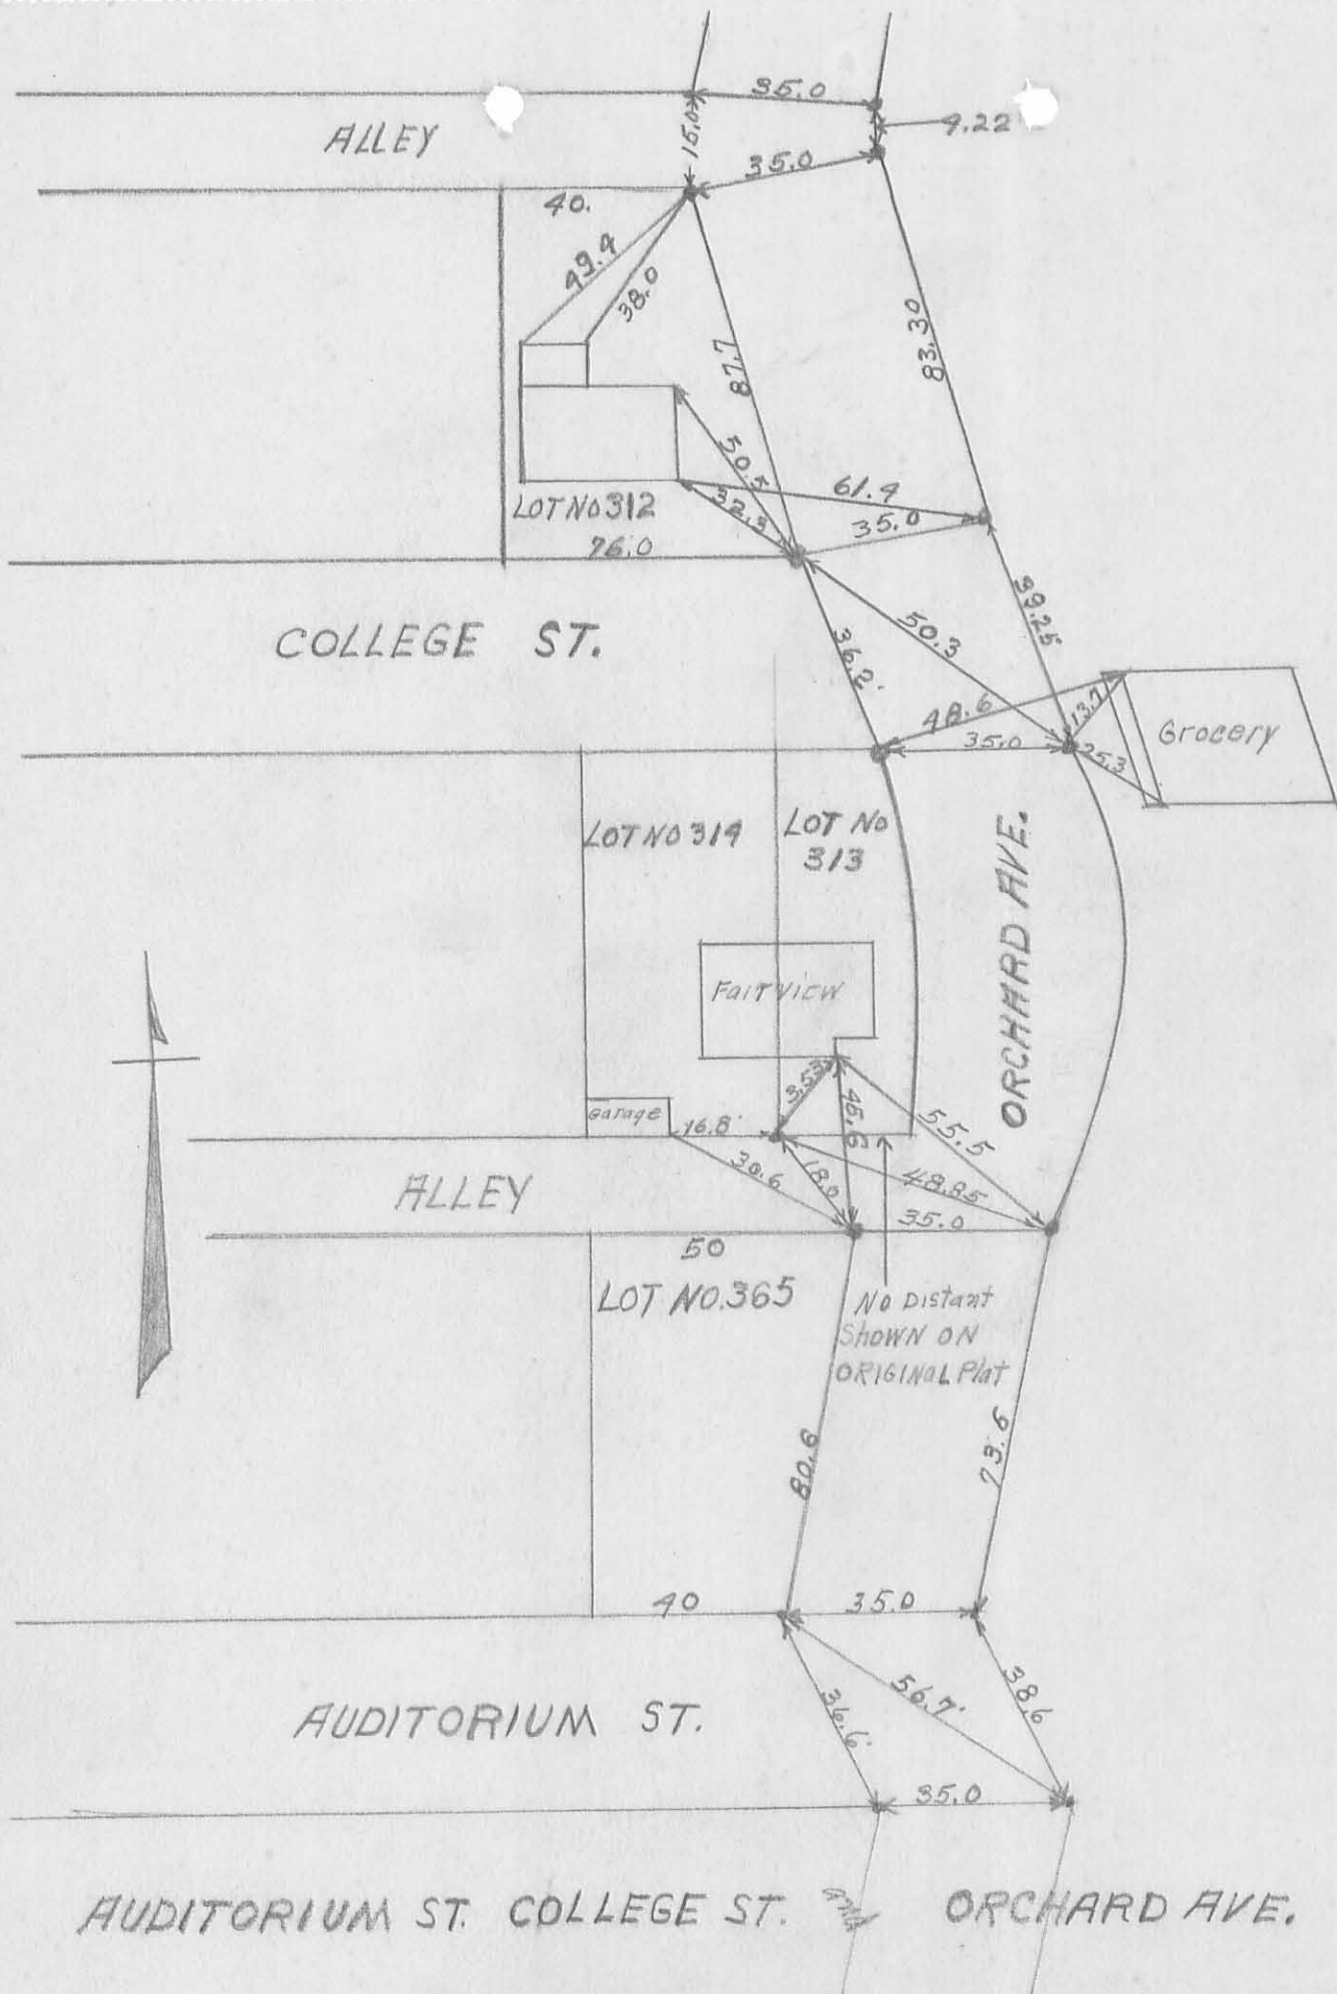



COTTAGE GROVE AVE.

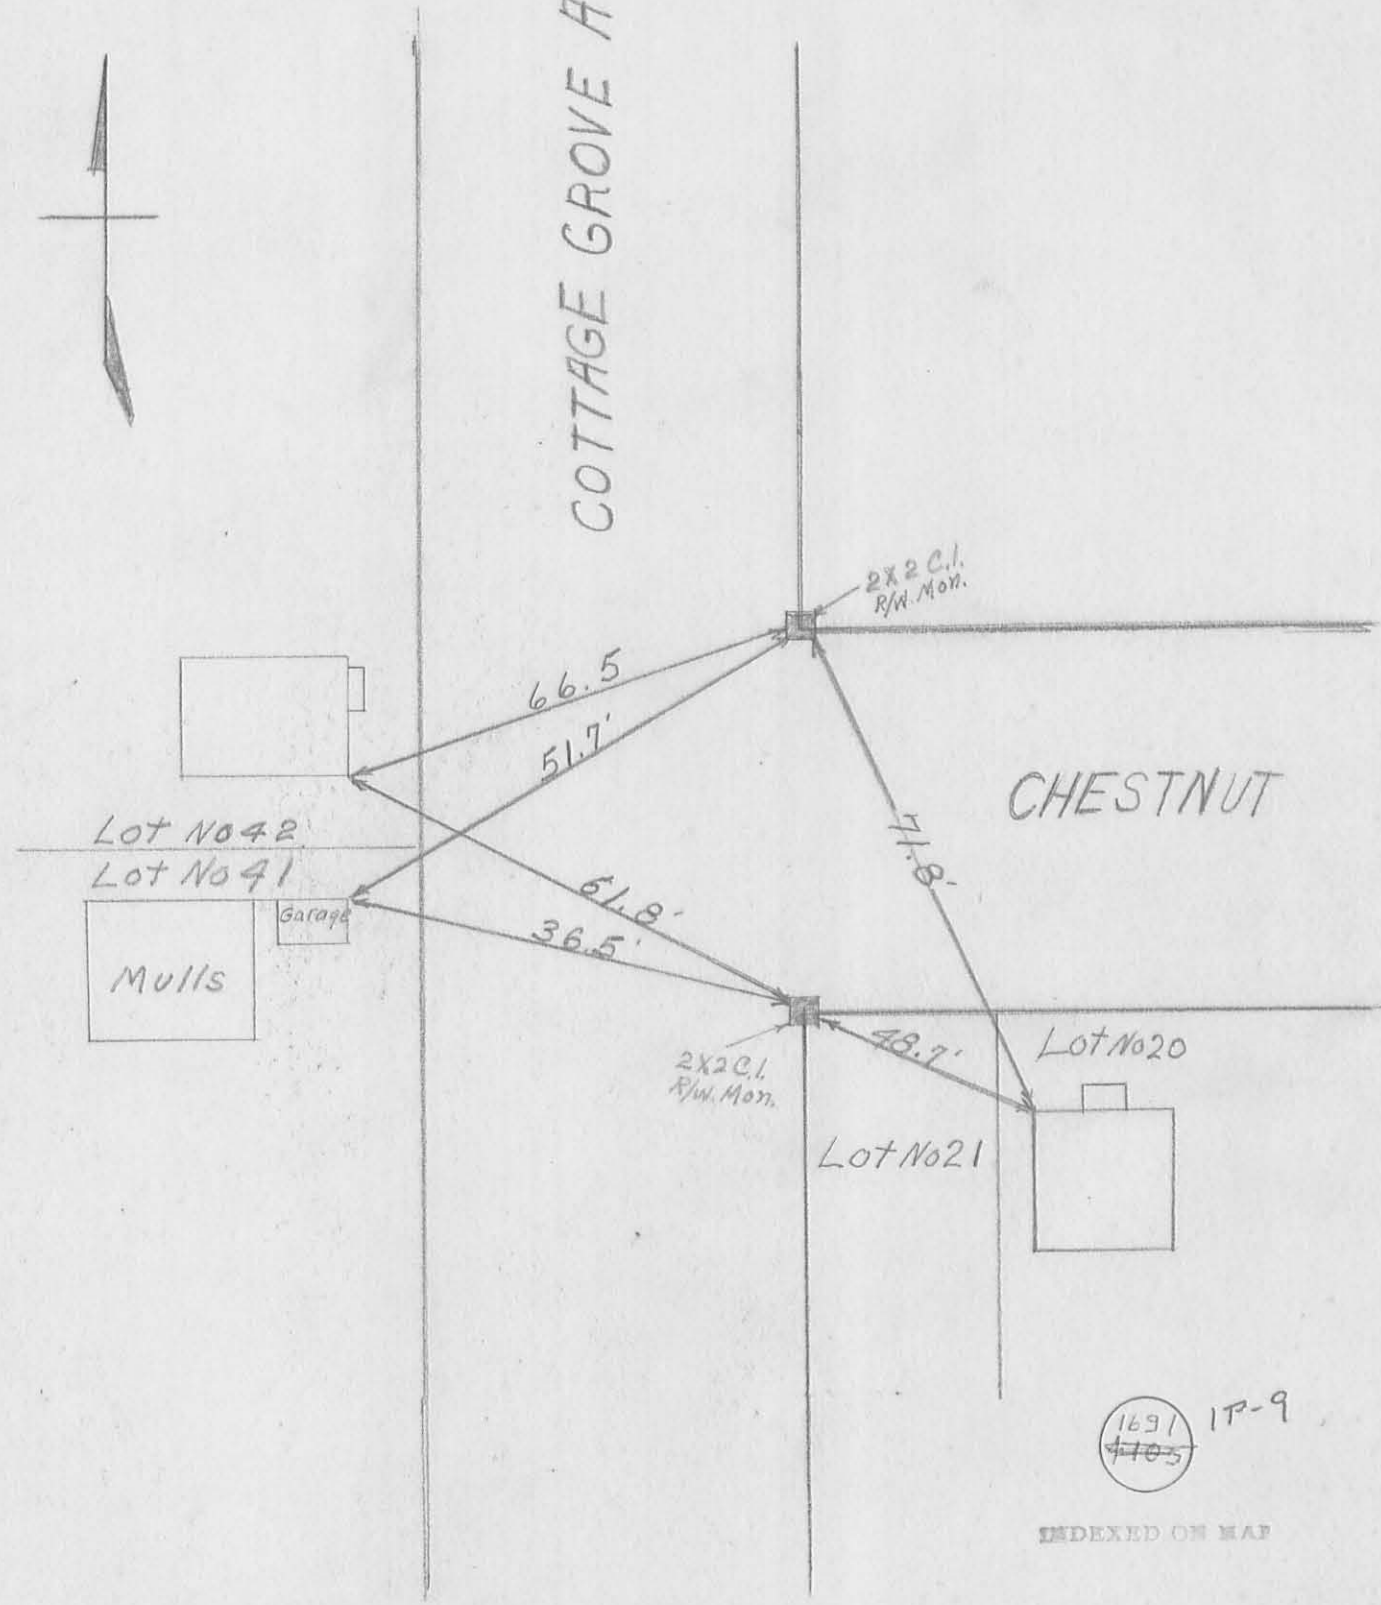

CHESTNUT

Lot No 42
Lot No 41

Mullis
Garage

2X2 C.I.
R/W. Mon.


Lot No 21

Lot No 20

1691
1703
17-9

INDEXED ON MAP


COTTAGE GROVE ^{R/W} CHESTNUT STREET

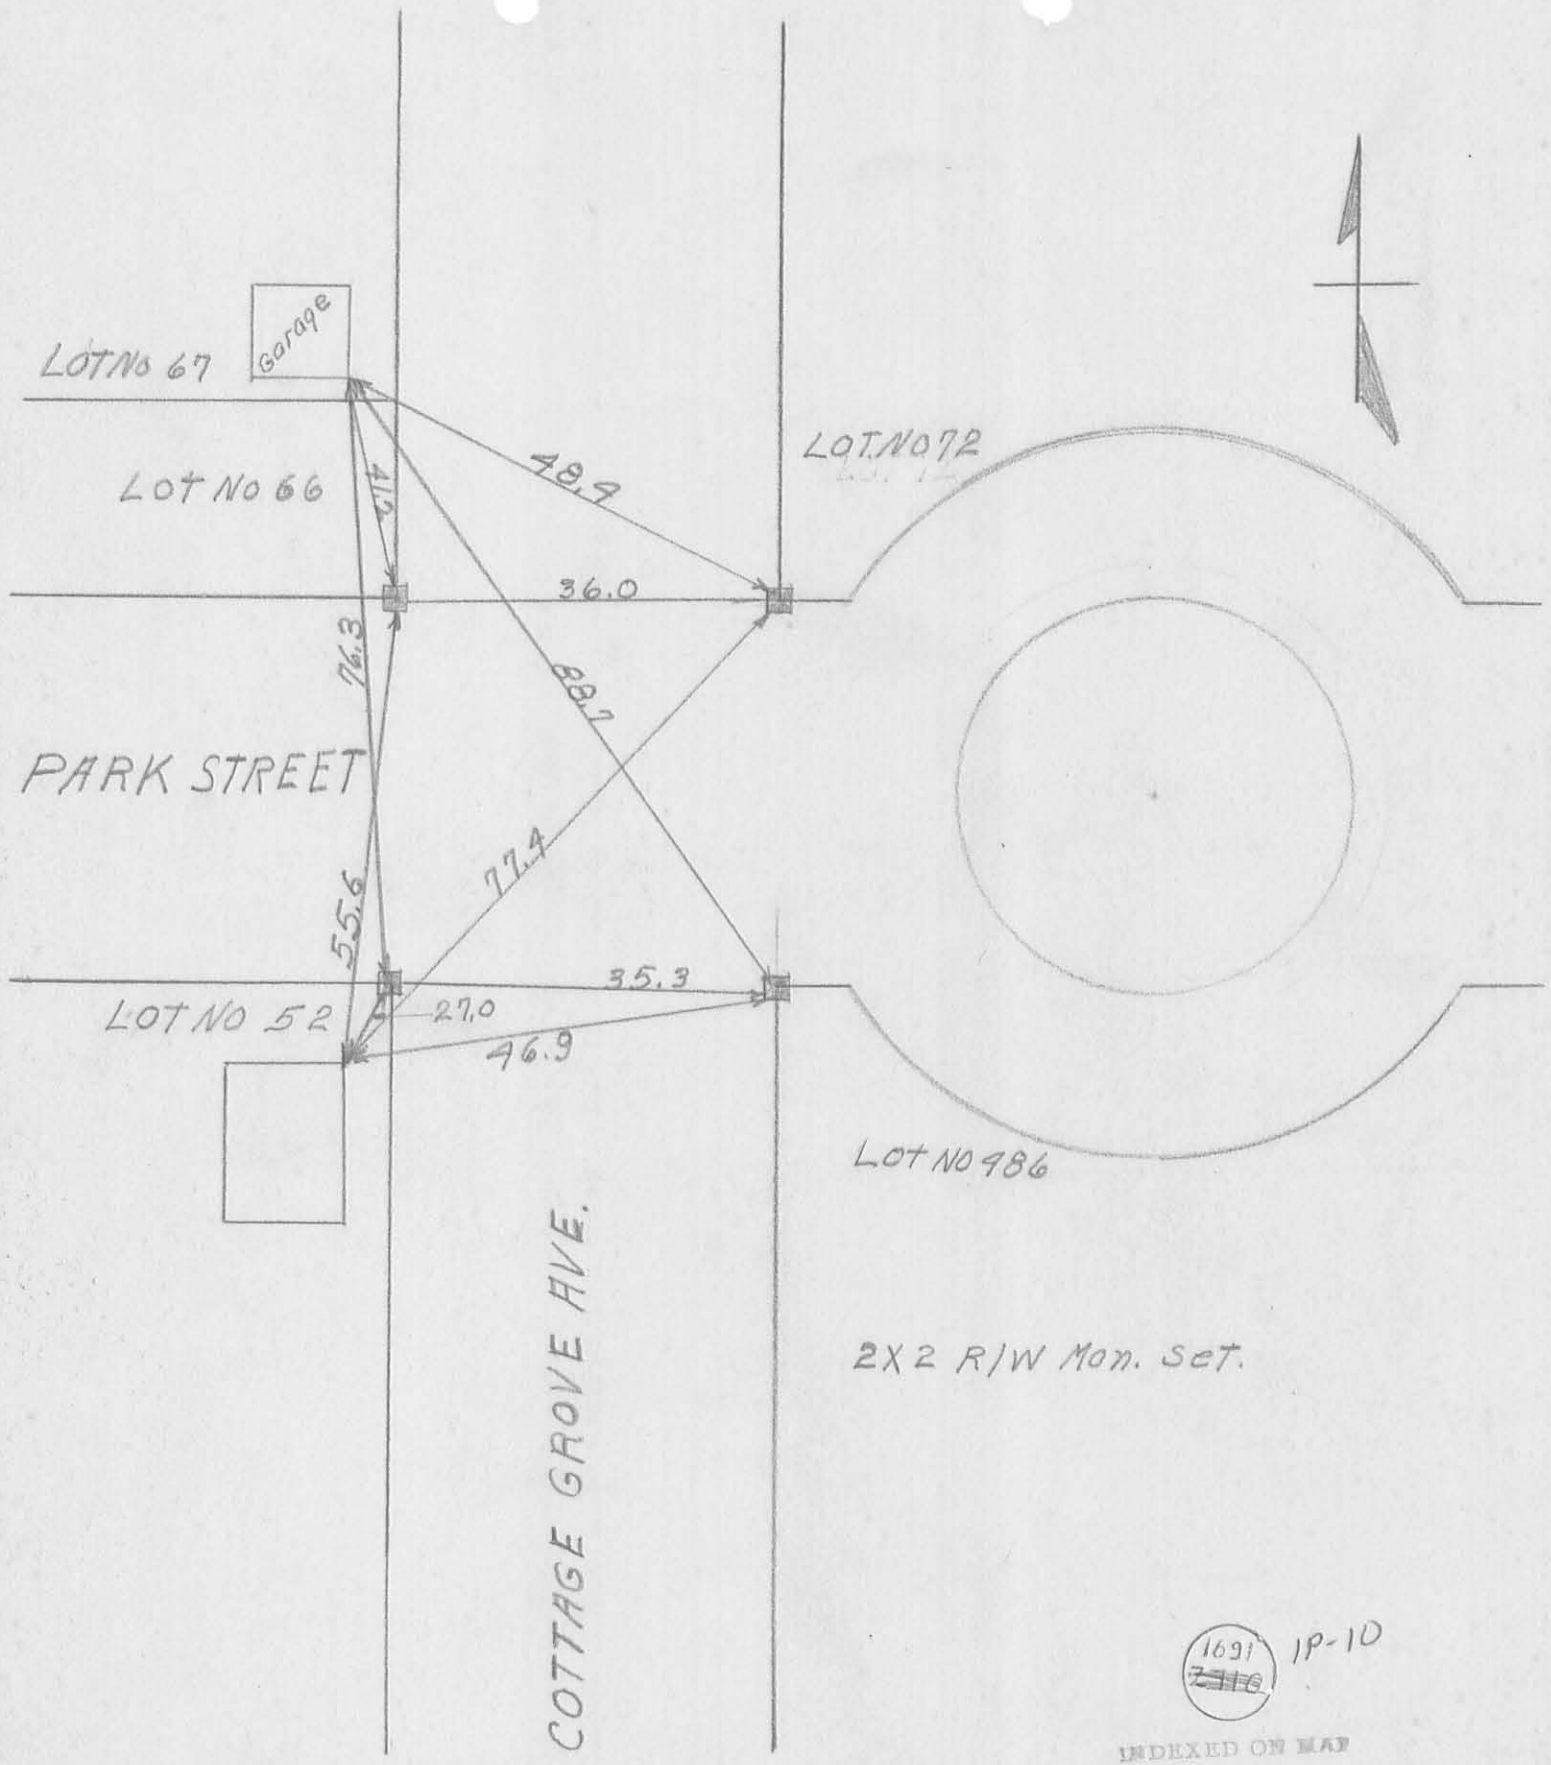


1691 1P-10

INDEXED ON MAP

COTTAGE GROVE AV ^{Plus} PARK ST.

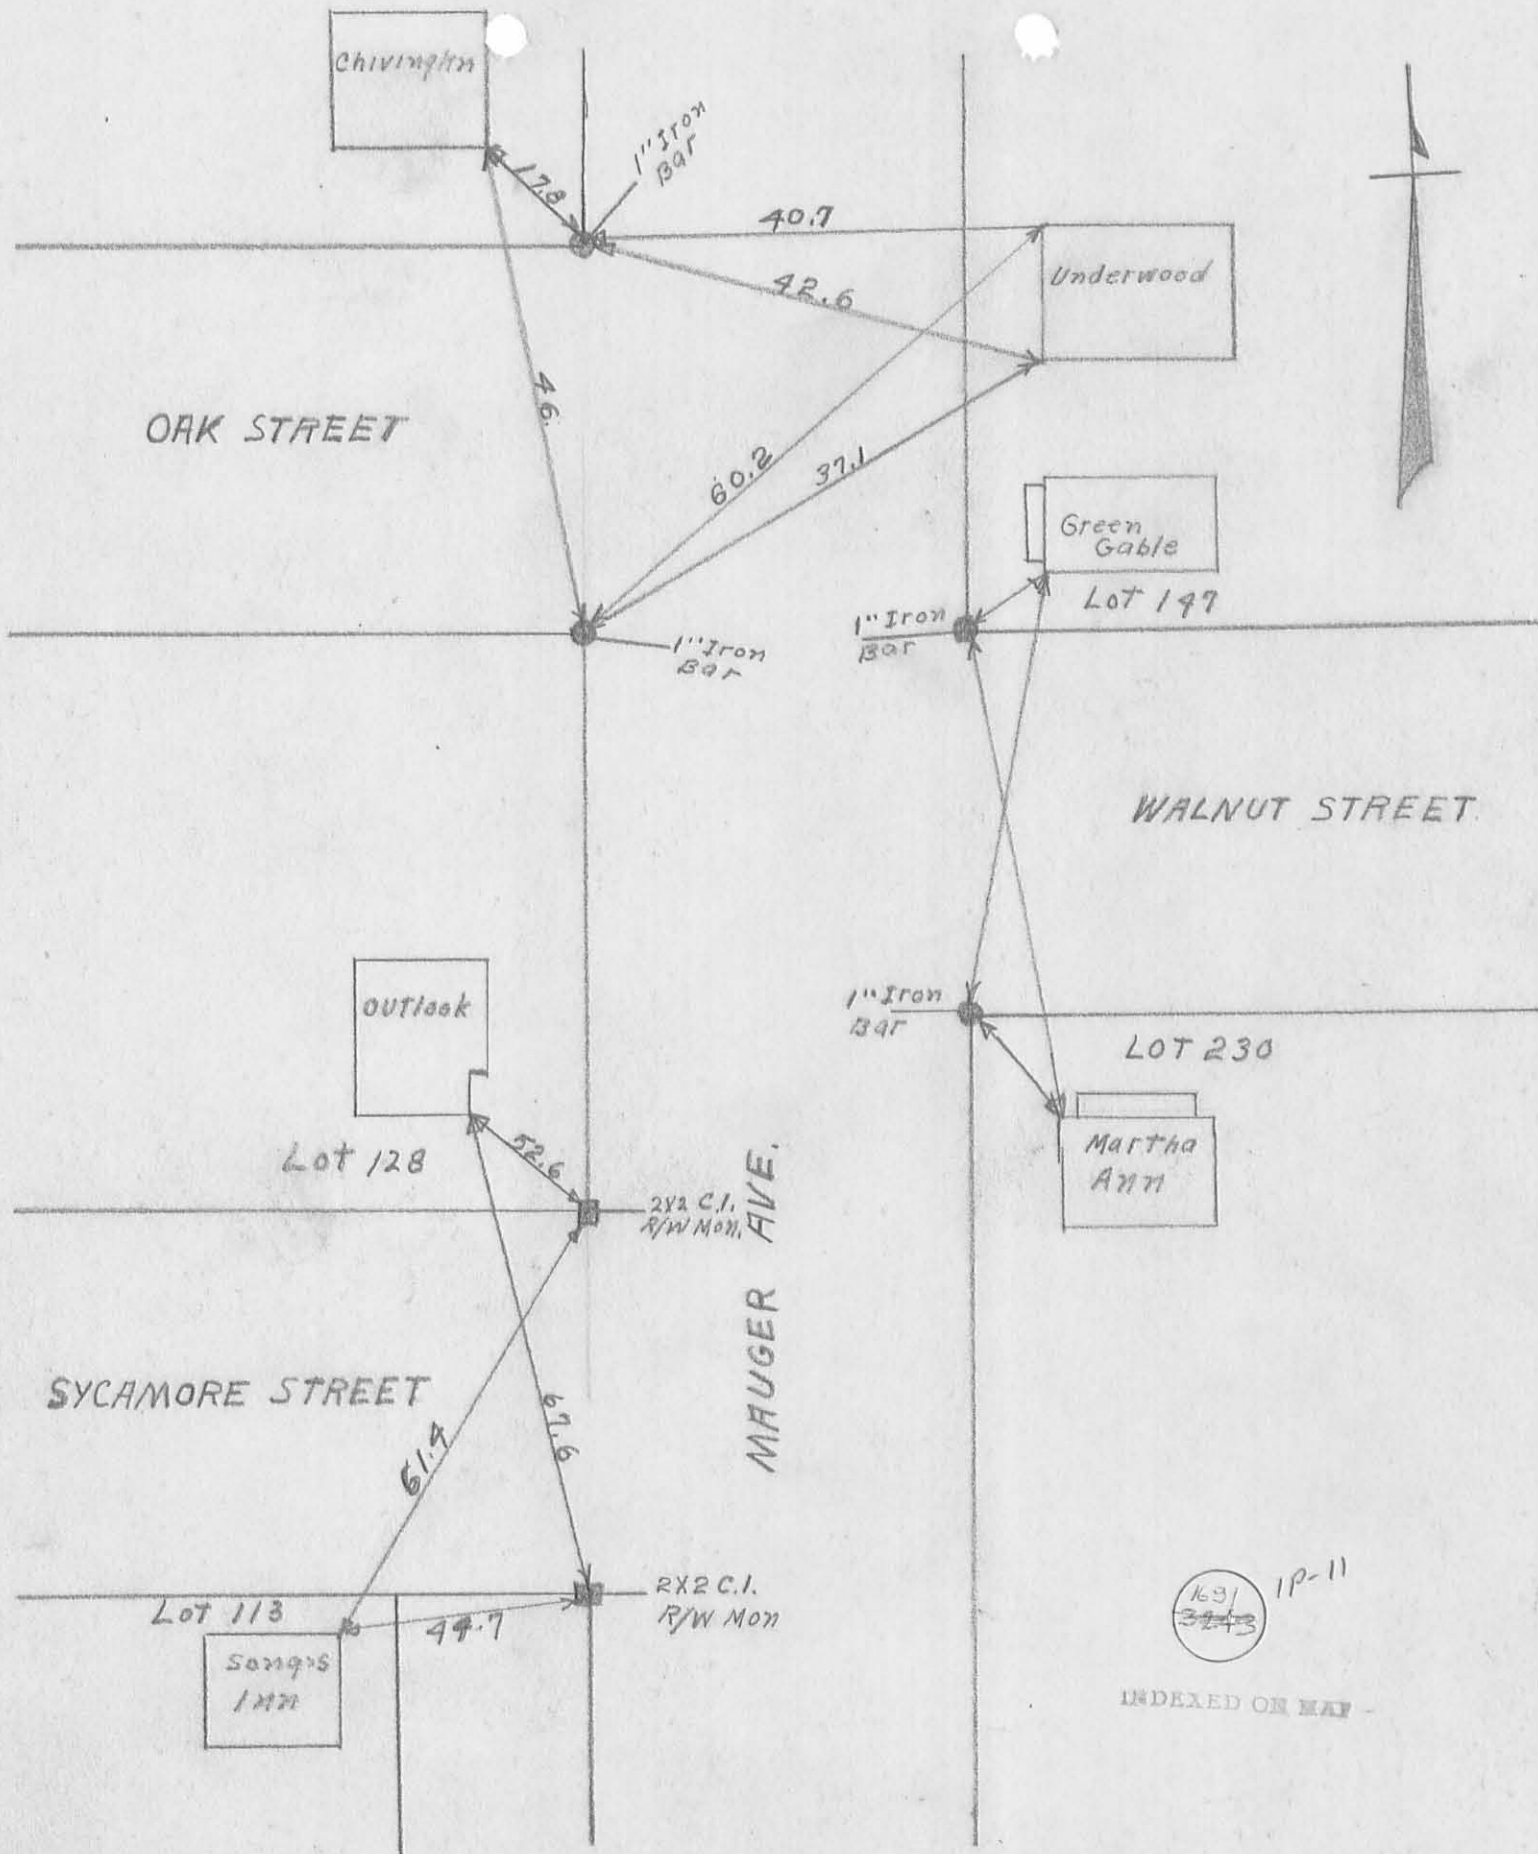

MAUGER AVE. SYCAMORE STREET WALNUT STREET OAK ST.

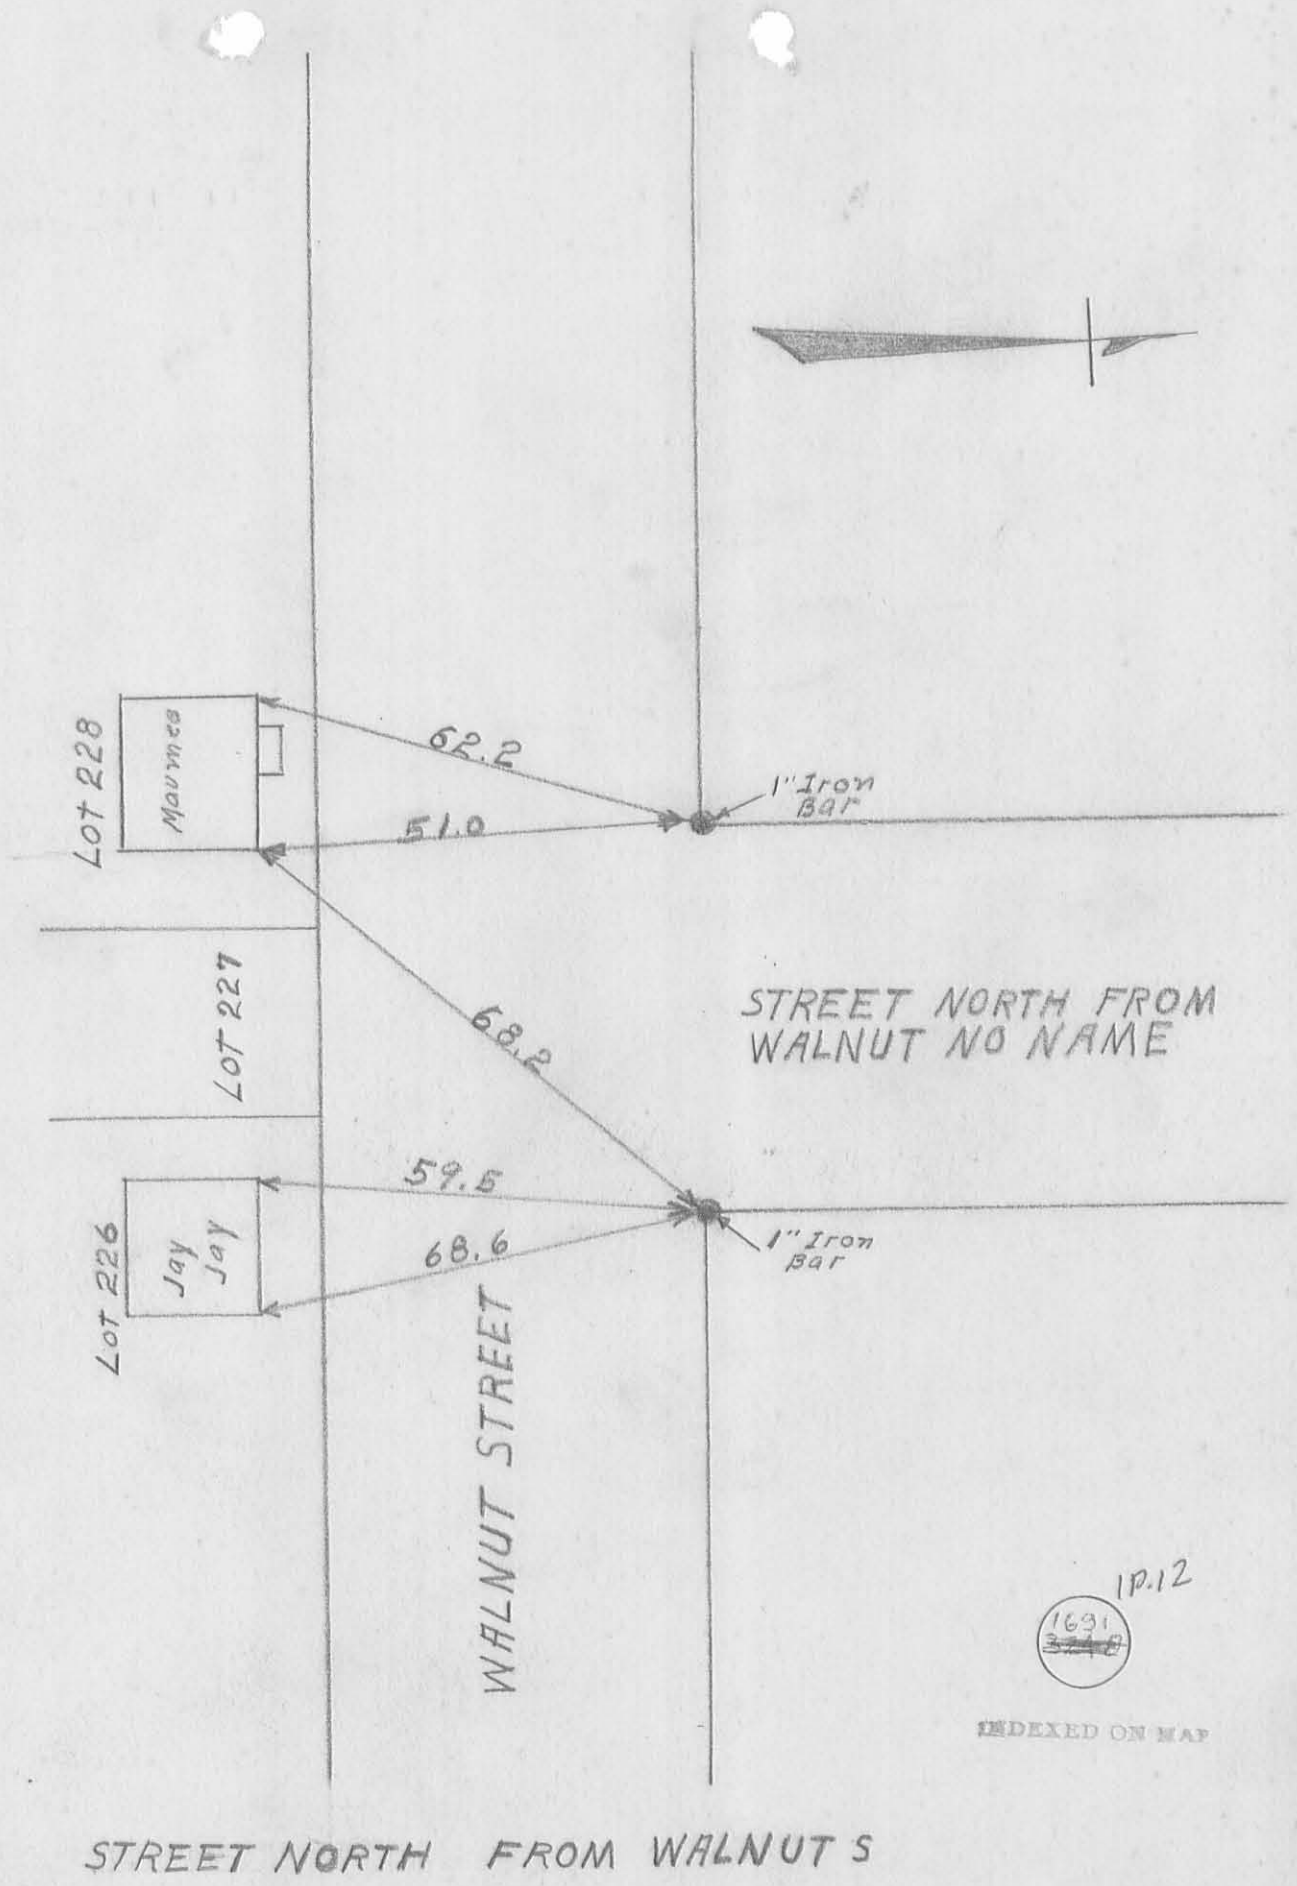

10.12
 1691
 348

INDEXED ON MAP

STREET NORTH FROM WALNUT S