


Campbell Surrey
 Sec. 36 T.6 R.8

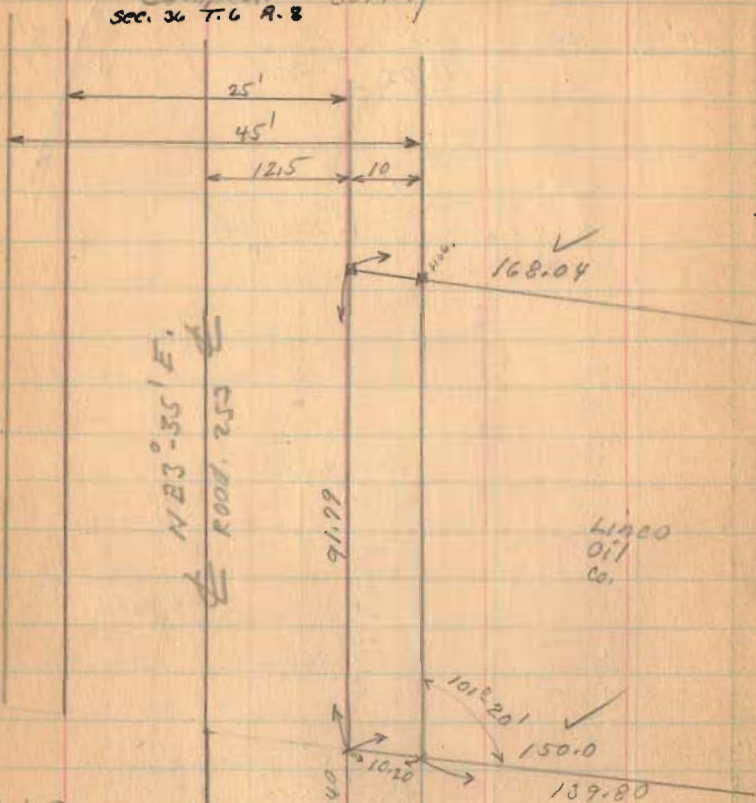

S.H. 168
 Route 32

Road 61

(See Page 18)


135.80
10.20
12.75
158.75
4.65
163.40

Lingo
 Oil
 Co.

Oct. 20, 1936
 clear
 F. Wright
 G. Pusey

state line 19

Tile

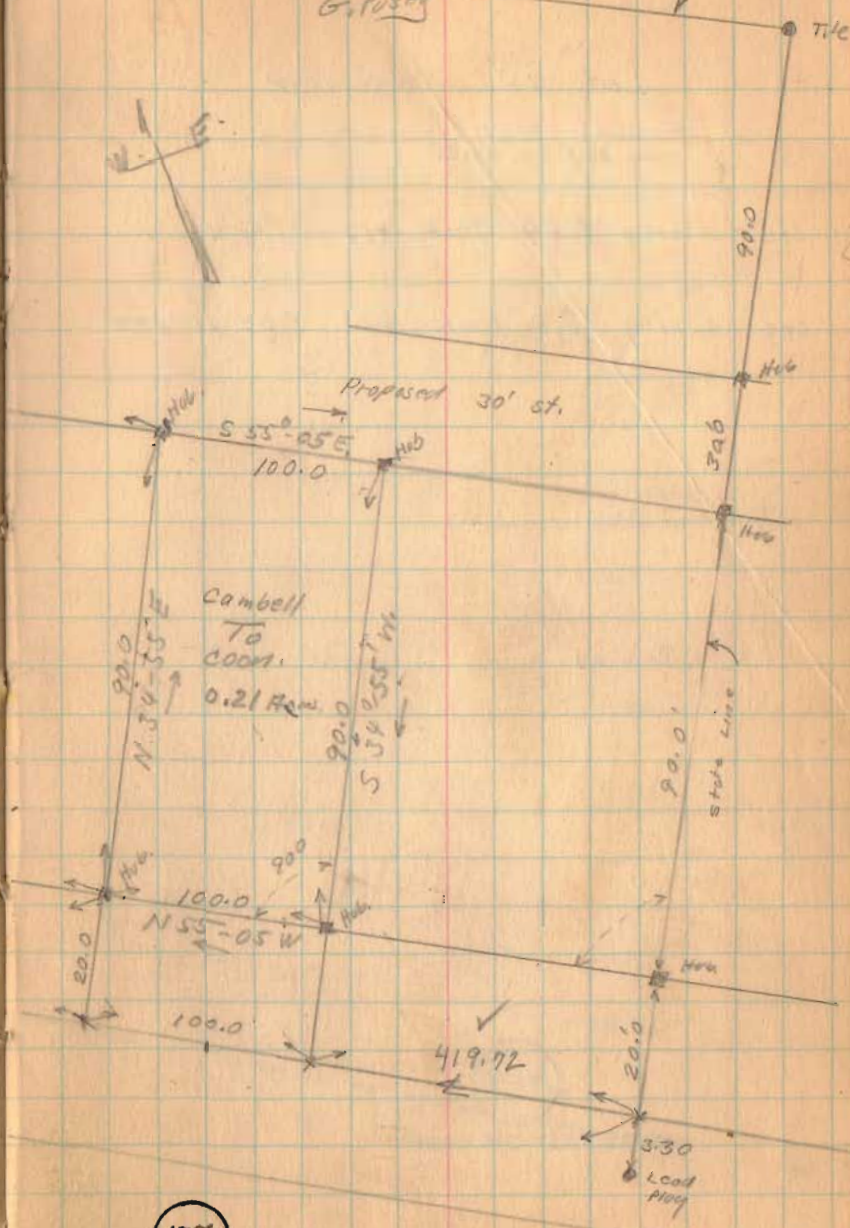

1756

INDEXED ON MAP