


Lot 64 Waterbury
 VMS. ⁹⁹⁴⁶ 10, 121
⁹⁹²⁵
 Washington Trp
 Logan Co.

Found Pipes and set
 pipe as shown on
 sketch.

1-13-33 Clear Cold.
 C.A. Inskip fine day
 Bob Emery

Recorded in Books Page 2
 Logan Co. Records.

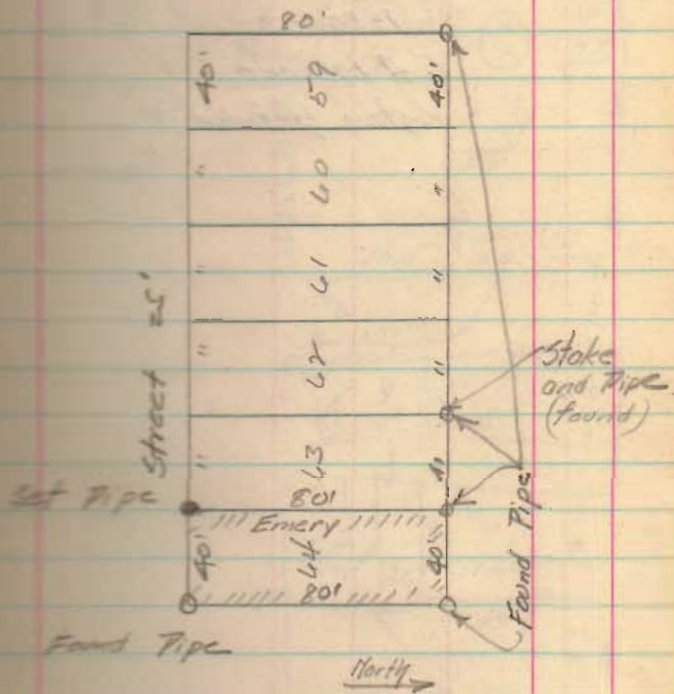

INDEXED ON MAP

2257