


Survey for Harry Grandi
 Lot # 287 Orchard Island
 Washington Twp. Logan Co. Ohio

2x2" hubs set as shown

June 24, 1946

J.H. Inskoop
 C.A. Miller 59
 J.C. Wheeler

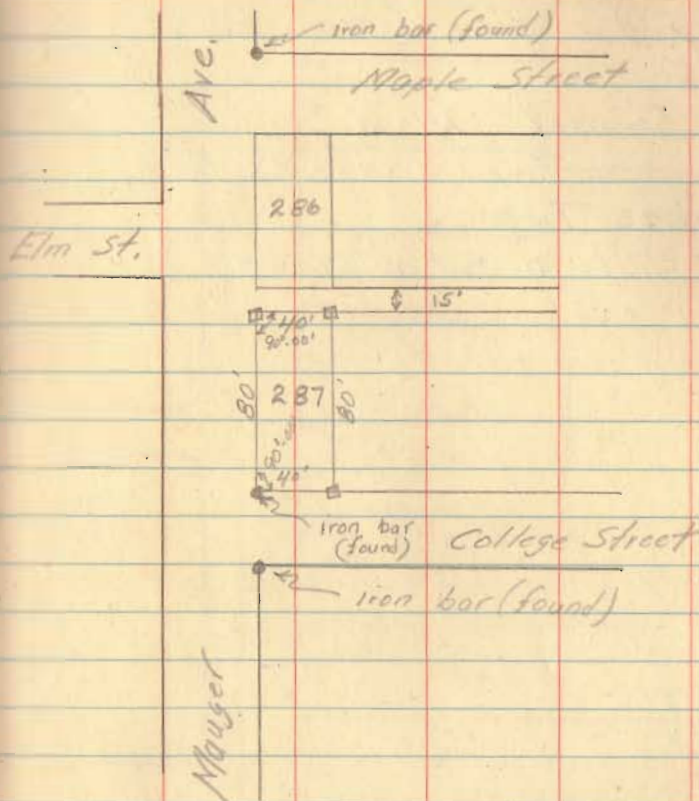

INDEXED ON MAP

2332