

LOT NO. 189 EXTENDED  
ORCHARD ISLAND  
INDIAN LAKE  
LOGAN COUNTY, OHIO

July 18, 1959

The following described real estate situated in Washington Township, Logan County, Ohio and being part of Virginia Military Survey 12276 and more particularly described as follows:


Commencing at an iron pipe in the west line of Forrest Avenue at the southeast corner of lot 189 of Orchard Island as the same is shown and designated on the Logan County Recorders Plat Book B, Volume 2, page 121; thence with the west line of said Forrest Avenue N. 37°-02' W. 49.0 feet to an iron pin, said pin being the beginning point of this description; thence continuing with the west line of Forrest Avenue N. 37°-02' W. 68 feet to the shore line of Indian Lake, passing an iron pipe at 62.0 feet; thence with said shore line southwesterly 81.8 feet; thence S. 37°-02' E. 45 feet to an iron pin, passing an iron pipe at 1.2 feet, said iron pin being N. 37°-02' W. 49.0 feet from the southwest corner of said lot 189; thence N. 52°-49' E. 80.0 feet to the place of beginning.

Containing 0.10 of an acre more or less.

2505 ID

INDEXED ON MAP

INDIAN LAKE

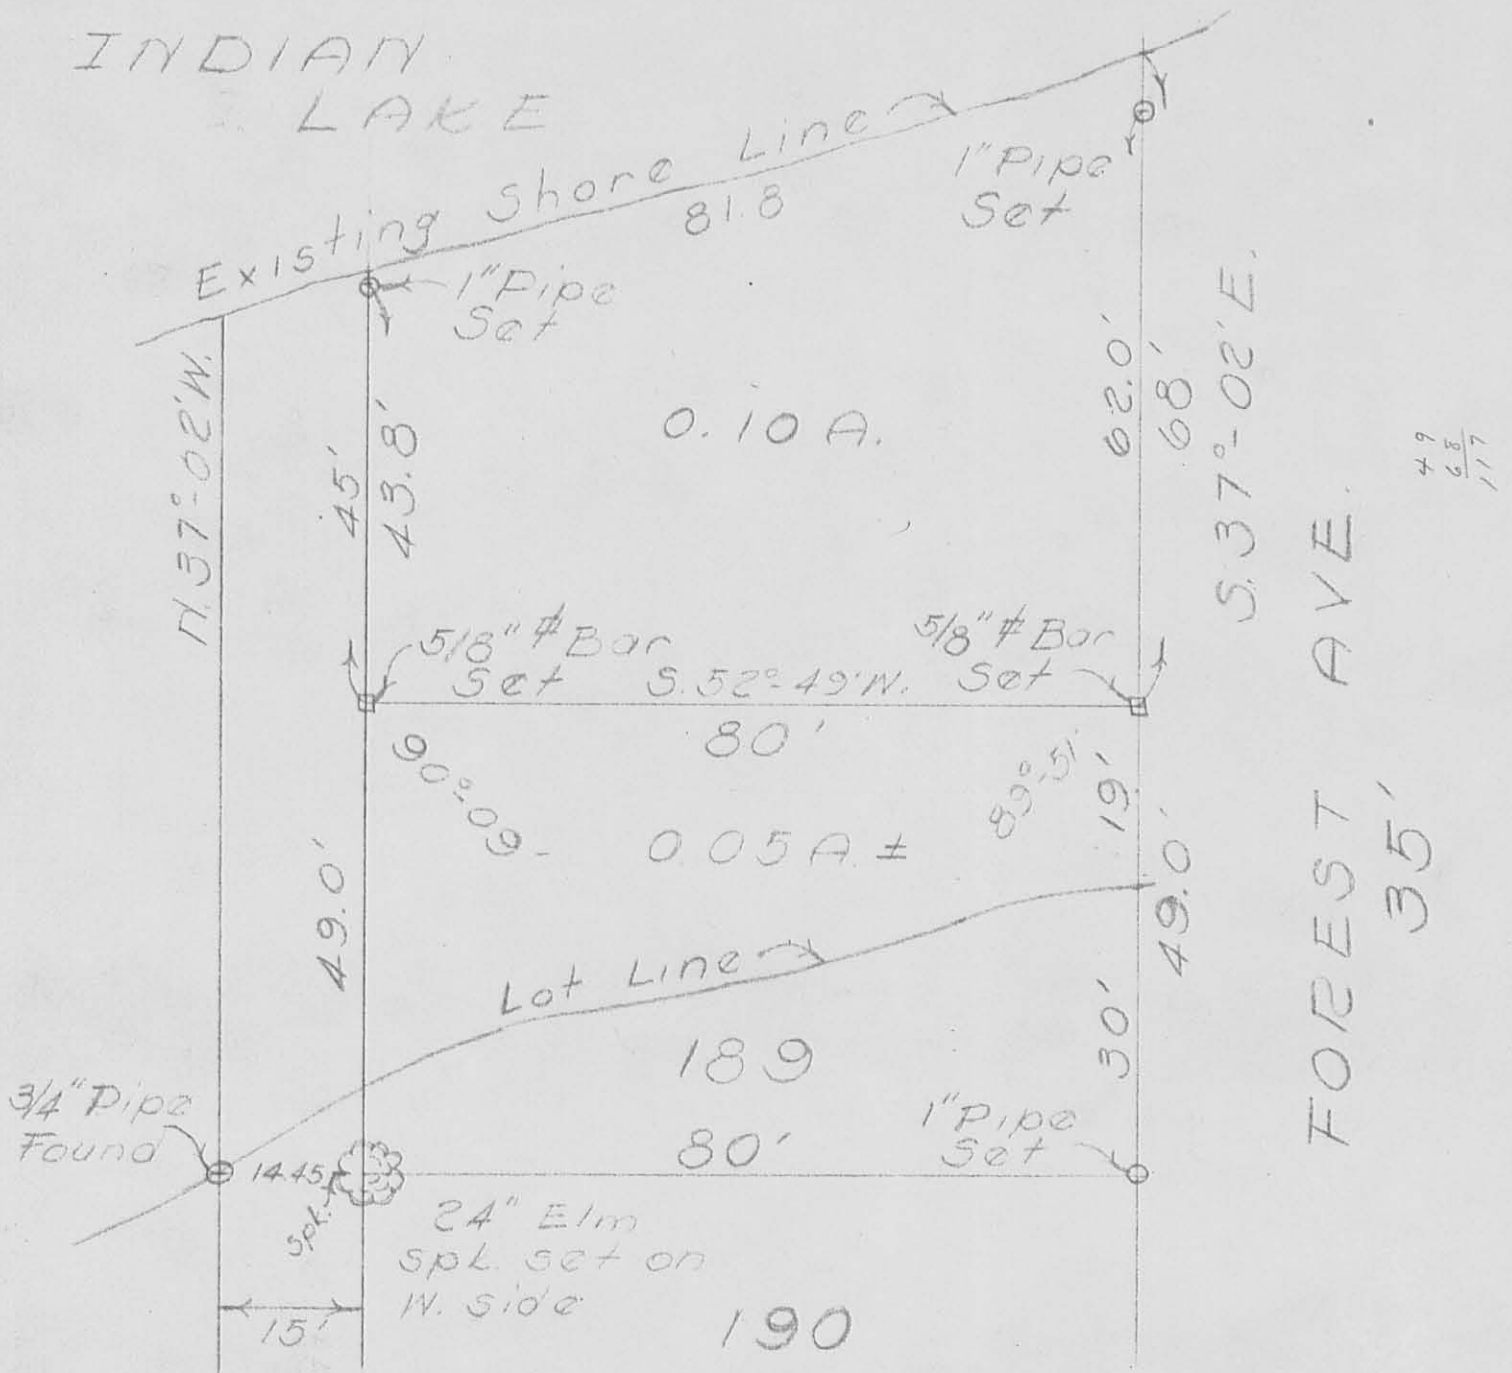

SURVEY OF LOT NO. 189  
 ORCHARD ISLAND  
 INDIAN LAKE  
 WASHINGTON TOWNSHIP  
 LOGAN COUNTY, OHIO

36-6-8  
 12276

*Dan L. Dodson*

Surveyed by Dan L. Dodson  
 Registered Surveyor No. 4270  
 July 18, 1959

INDEXED ON MAP

2505 1P

INDEXED ON MAP