

SCALE: 1" = 30'



LEGEND:

O = 3/4" IRON PIPE FD.


SURVEY OF LOTS 361 AND 362,  
ON ORCHARD ISLAND,  
WASHINGTON TWP, LOGAN CO.,  
OHIO. MAY 4, 1992  
MADE FOR: LARRY LINE



*Leslie H. Geeslin*  
LESLIE H. GEESLIN  
RUSHSVLVANIA, OHIO  
(D.L.G.)

INDEXED ON MAP  
4617 IP

REC'D 6-29-99 Jay

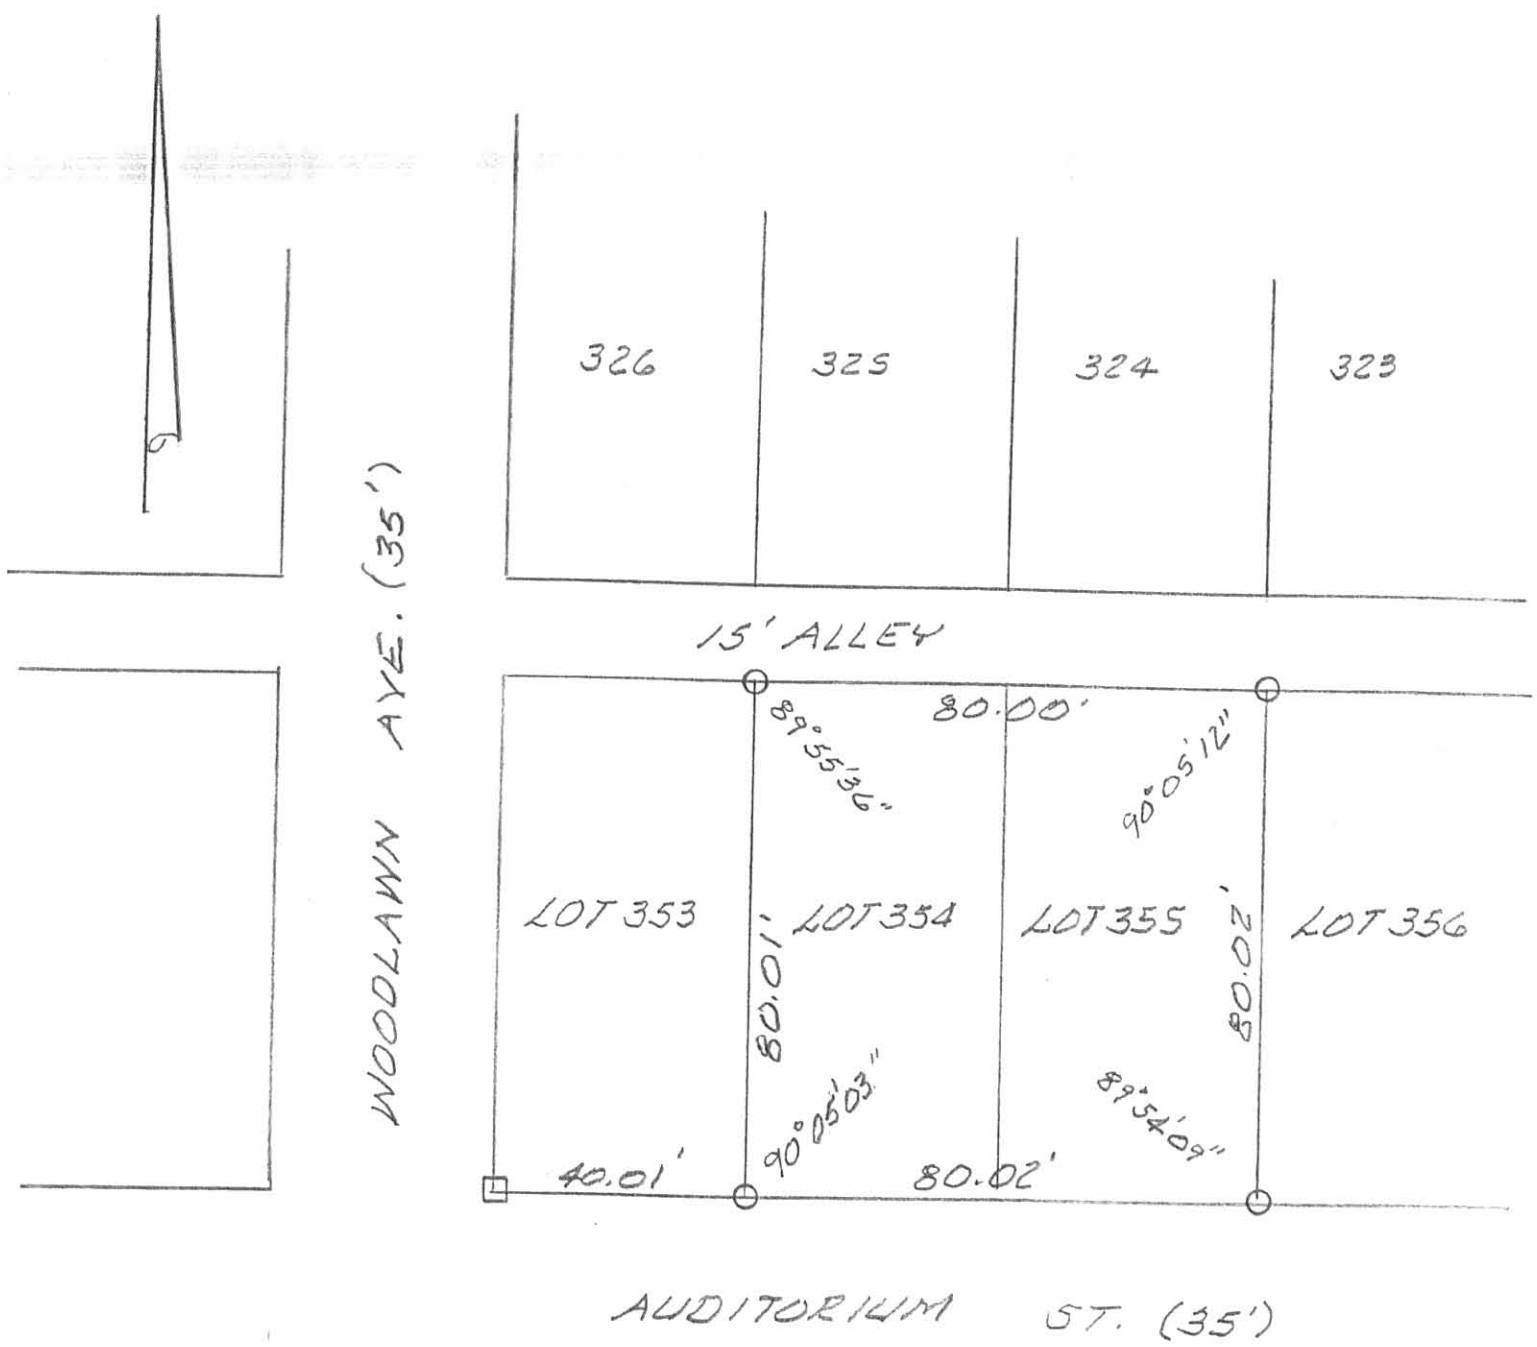

SURVEY OF LOTS 354 & 355 OF  
 ORCHARD ISLAND - PLAT CABINET A  
 SLIDE 219-221, WASHINGTON TWP.,  
 LOGAN COUNTY, OHIO FOR RON  
 FLESHER.

JUNE 18, 1999  
 SCALE: 1" = 30'




*Leslie H. Geeslin*

LESLIE H. GEESLIN  
 RUSHsylvania, OHIO  
 PH 937-468-2793

INDEXED ON MAP  
 4017 2P

Auditorium Street 35'

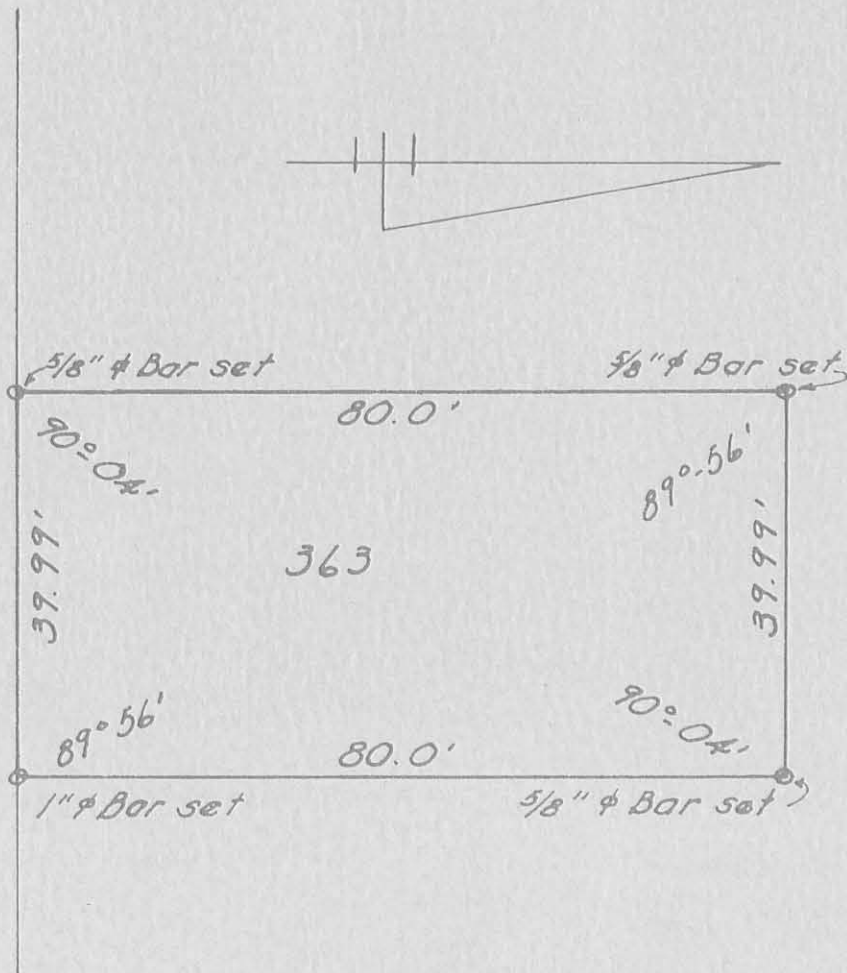

Survey of Lot 363  
Orchard Island  
Indian Lake, Ohio  
August 11, 1965  
Scale 1" = 20'

Reference:  
Plat Bk. D, Vol. 2, Pg 121

4017 3P

INDEXED ON MAP

Dan L. Dodson  
Reg. Surveyor A270  
Bellefontaine, Ohio

Dodson FB 13

Lot 363

Orchard Island

7/12/65

4680

3191

16

16


16

16

Geeslin  
Dicketts

5

7/12/65

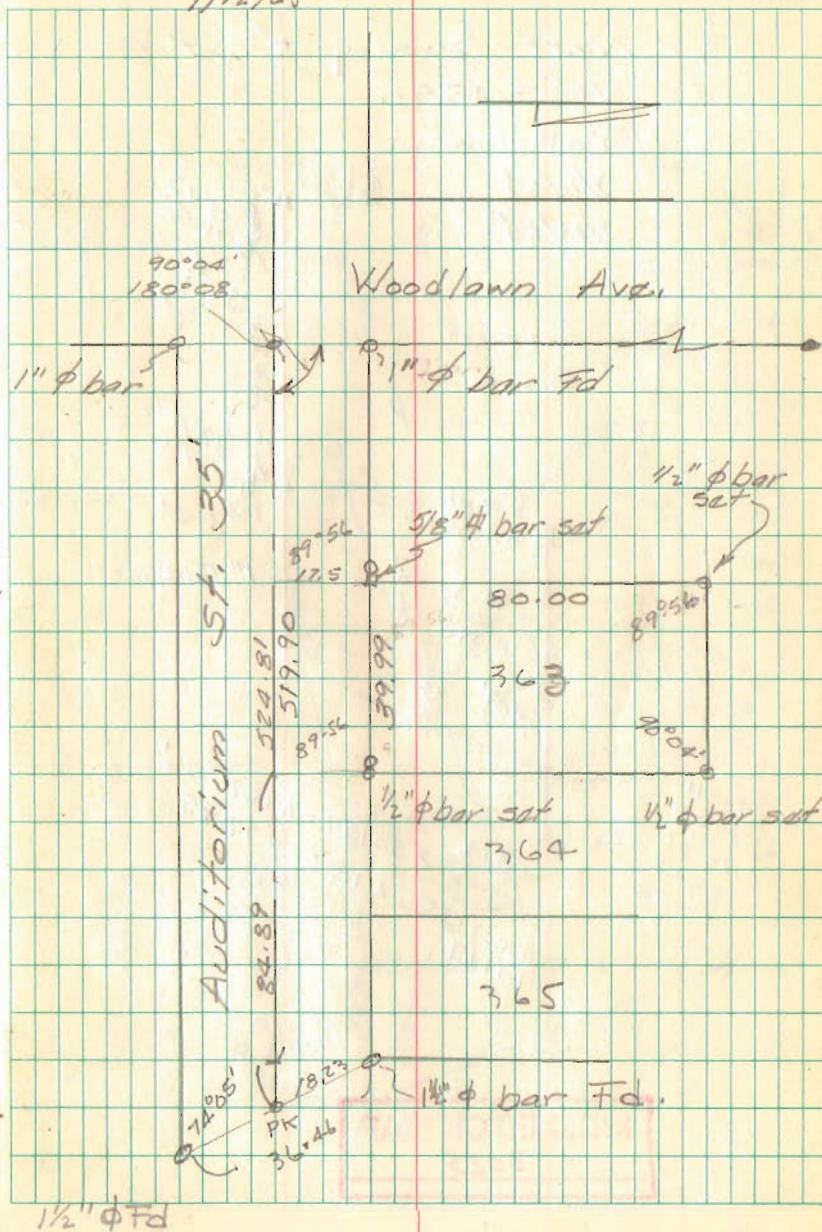

INDEXED ON MAP  
4017

FB 712

Alley Survey  
Orchard Island  
Washington Twp., Logan Co., Ohio

Pt. Description

- A.) Fd. 2" I.D. pipe  
 B.) Fd. 1" dia. iron  
 C.) Fd.  $\frac{5}{8}$ " hexagonal iron -  
 0.23' Lt. of line B-F  
 D.) Set  $\frac{5}{8}$ " dia. cpd. rebar half way  
 between pts. B & F on line B-F.  
 E.) Fd.  $\frac{5}{8}$ " hexagonal iron - 0.05'  
 Lt. of line B-F.  
 F.) Fd. 1" dia. iron  
 G.) Fd.  $1\frac{1}{2}$ " dia. iron  
 H.) Fd.  $\frac{1}{2}$ " I.D. pipe  
 I.) Set  $\frac{5}{8}$ " dia. cpd. rebar on line  
 G-H extended - Set on line half  
 way between pts. A & G.  
 J.) Fd. 1" dia. iron

$$\begin{aligned} \angle A-B-F &= 89^{\circ}-56'-27'' \\ \angle B-F-G &= 90^{\circ}-03'-48'' \\ \angle F-G-A &= 104^{\circ}-18'-58'' \\ \angle G-A-B &= 76^{\circ}-40'-47'' \end{aligned}$$

INDEXED ON MAP

4017


C. Dill

B. Simmons


G. Dappert

Jan. 2004


18

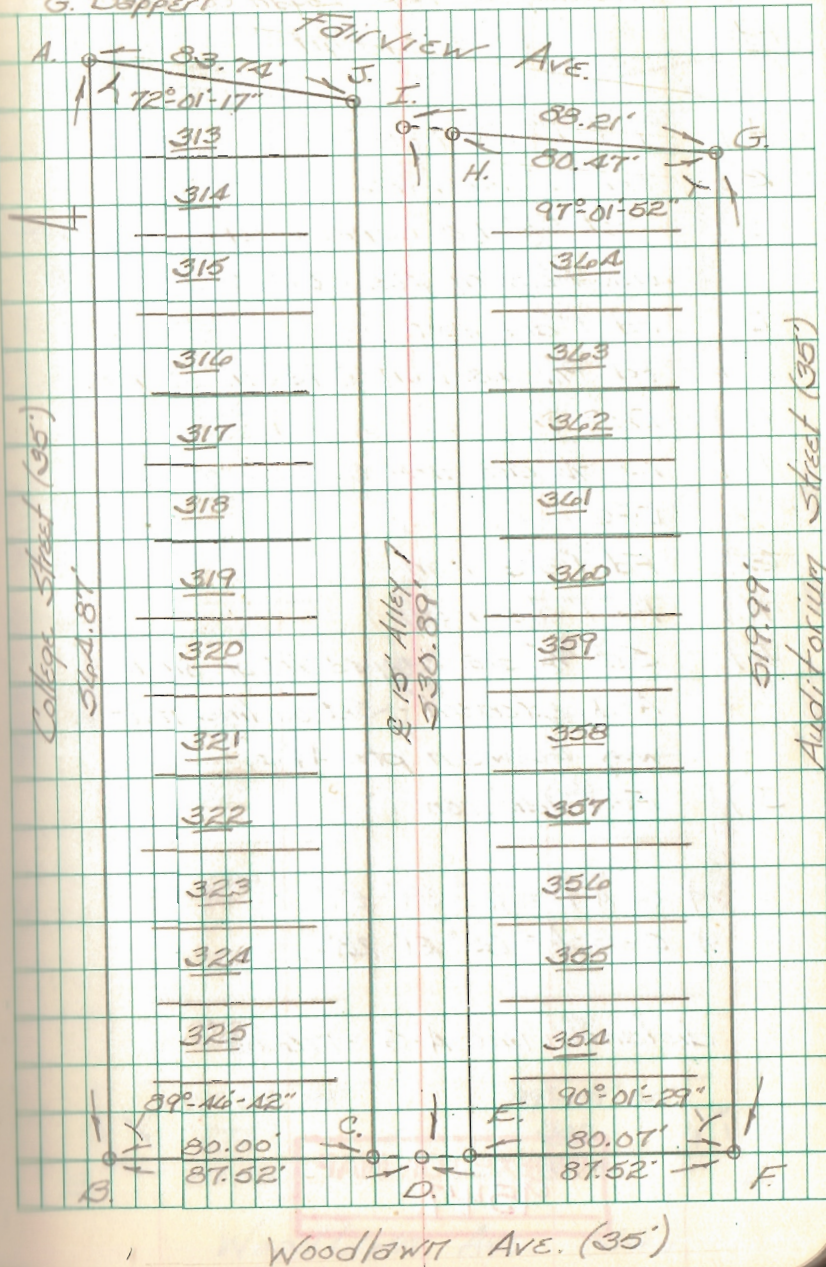


PLAT OF SURVEY IN  
SECTION 36, TOWN 6, RANGE 8 B.M.R.S.  
WASHINGTON TOWNSHIP  
LOGAN COUNTY, OHIO

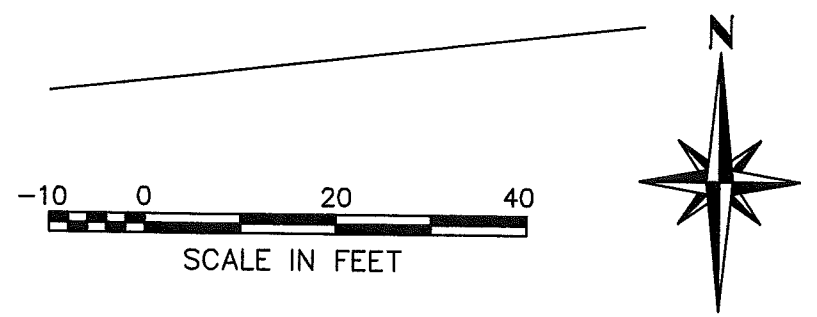

COLLEGE STREET (35')

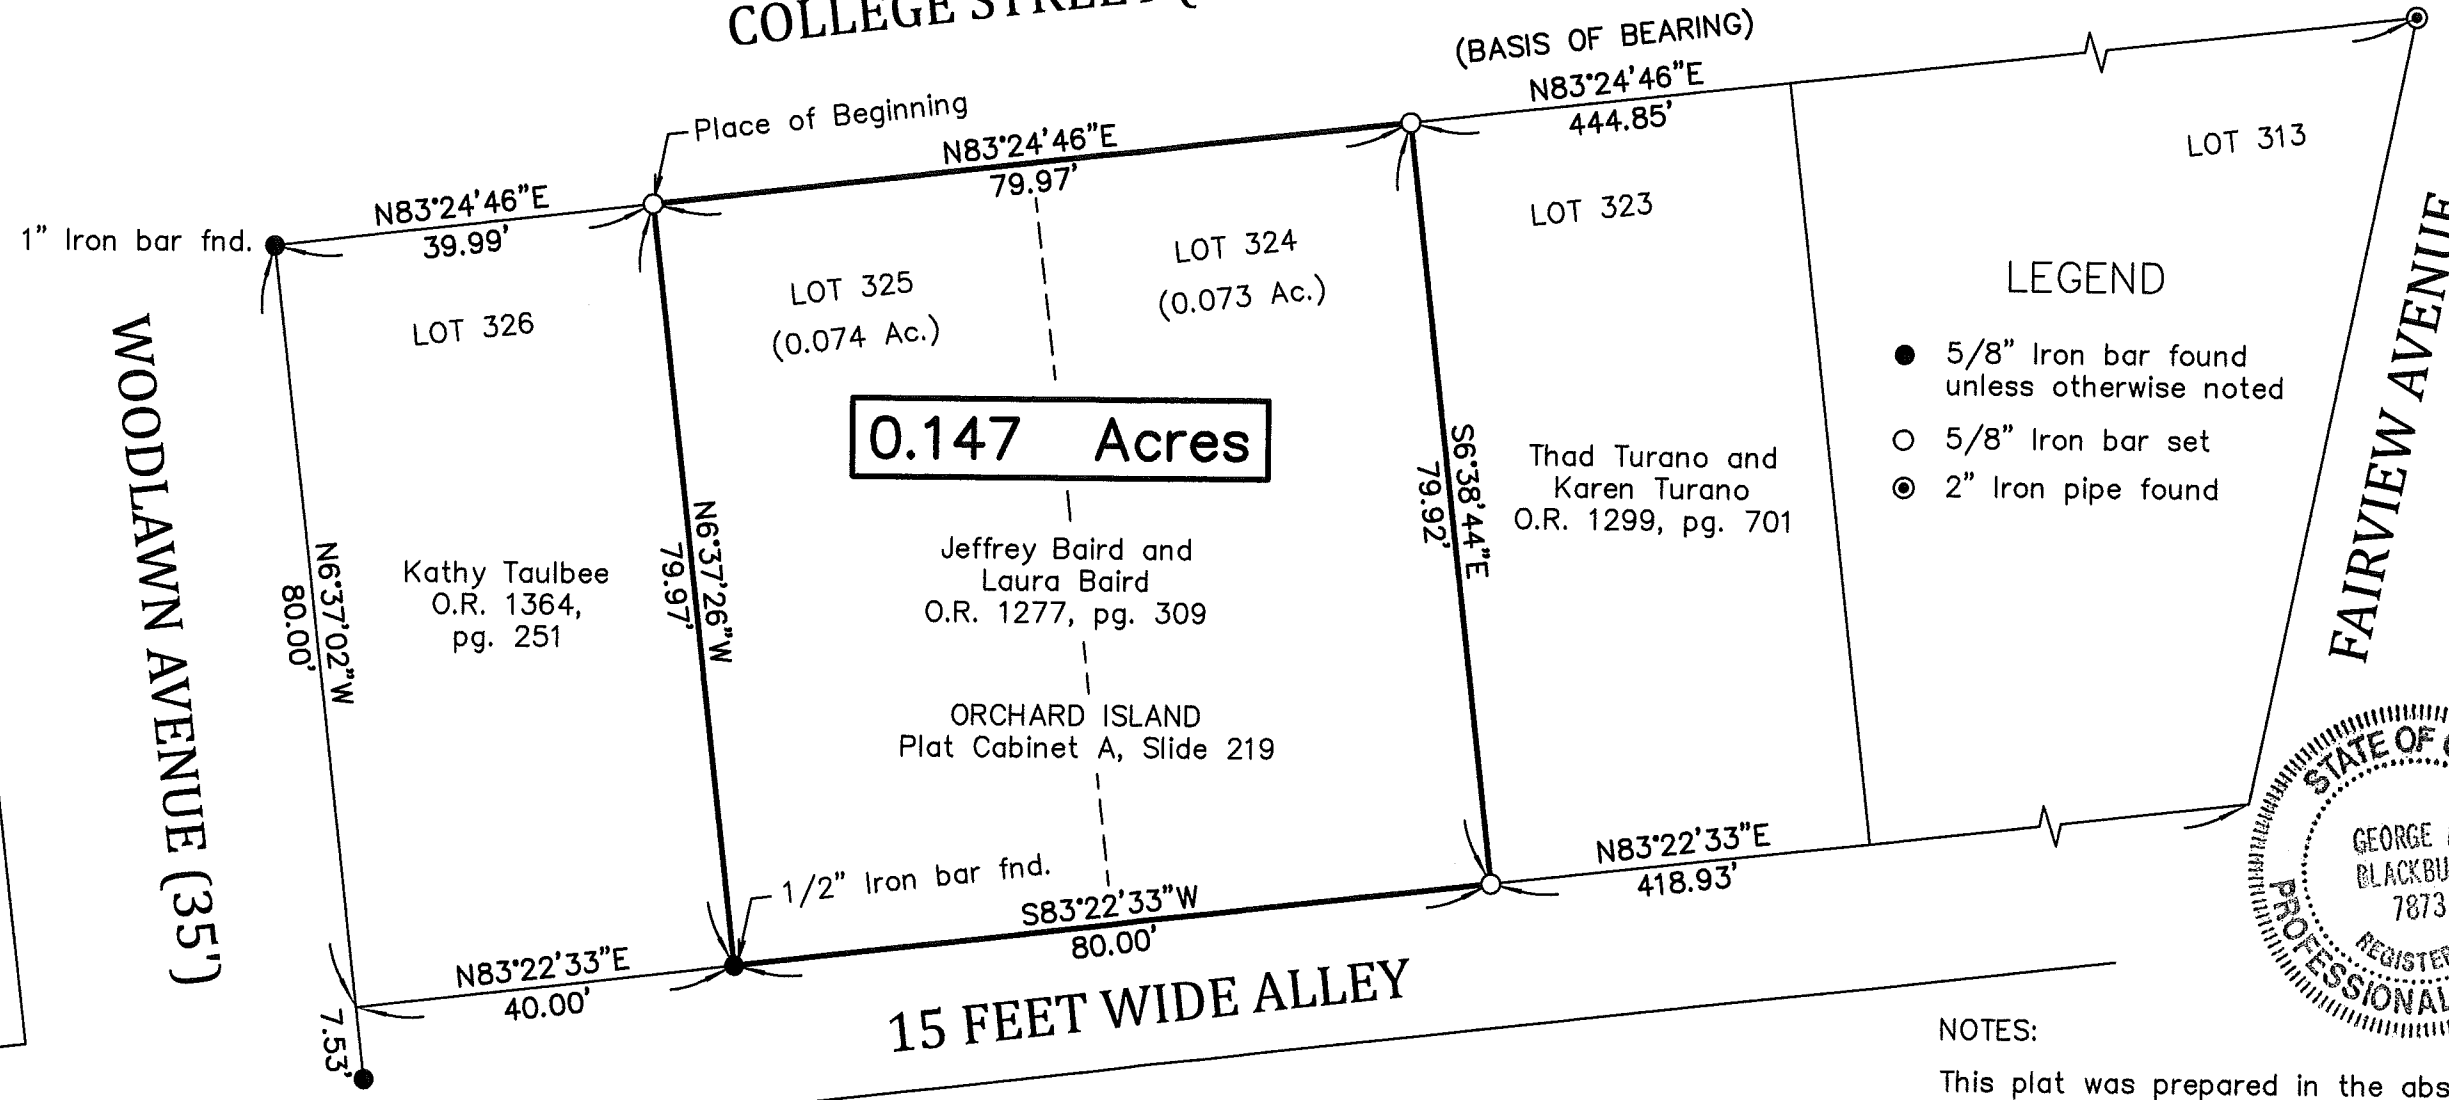

- LEGEND
- 5/8" Iron bar found unless otherwise noted
  - 5/8" Iron bar set
  - ⊙ 2" Iron pipe found

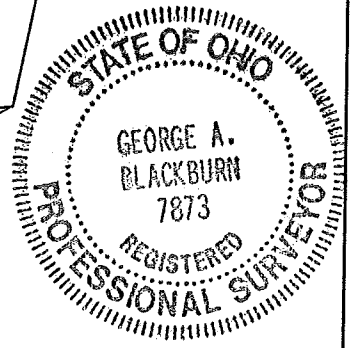

NOTES:  
This plat was prepared in the absence of a complete and accurate title search and does not guarantee title.

I HEREBY CERTIFY THAT THIS PLAT WAS PREPARED FROM AN ACTUAL FIELD SURVEY AND THAT MONUMENTS WERE PLACED AS INDICATED HEREON.

*George A. Blackburn* 2-7-2022  
GEORGE A. BLACKBURN, R.S. 7873

BLACKBURN SURVEYING, LLC  
6879 STATE ROUTE 287  
WEST LIBERTY, OHIO 43357  
(937) 465-0424

DATE: 2/7/2022  
SCALE: 1" = 20'  
FILE: Jeff Baird 2-22

REVISIONS	DATE	BY

PREPARED FOR JEFFREY BAIRD AND LAURA BAIRD

SHEET  
1  
OF 1

INDEXED ON MAP  
4017