

FB 700

Lots, 89-90-91-92

Lewistown, Ohio

Surveyed for Washington  
Township Trustees to locate  
Williams St.

See Inskip F.B. # 13 pg. 31


McKinnon's Add.  
Bk. B, Vol. 2, pg. 30

Original Town  
Bk B Vol. 2 pg. 30  
lots 50x150  
Alleys 10' wide

Dodson  
Gilbert  
Tew's

1958

75

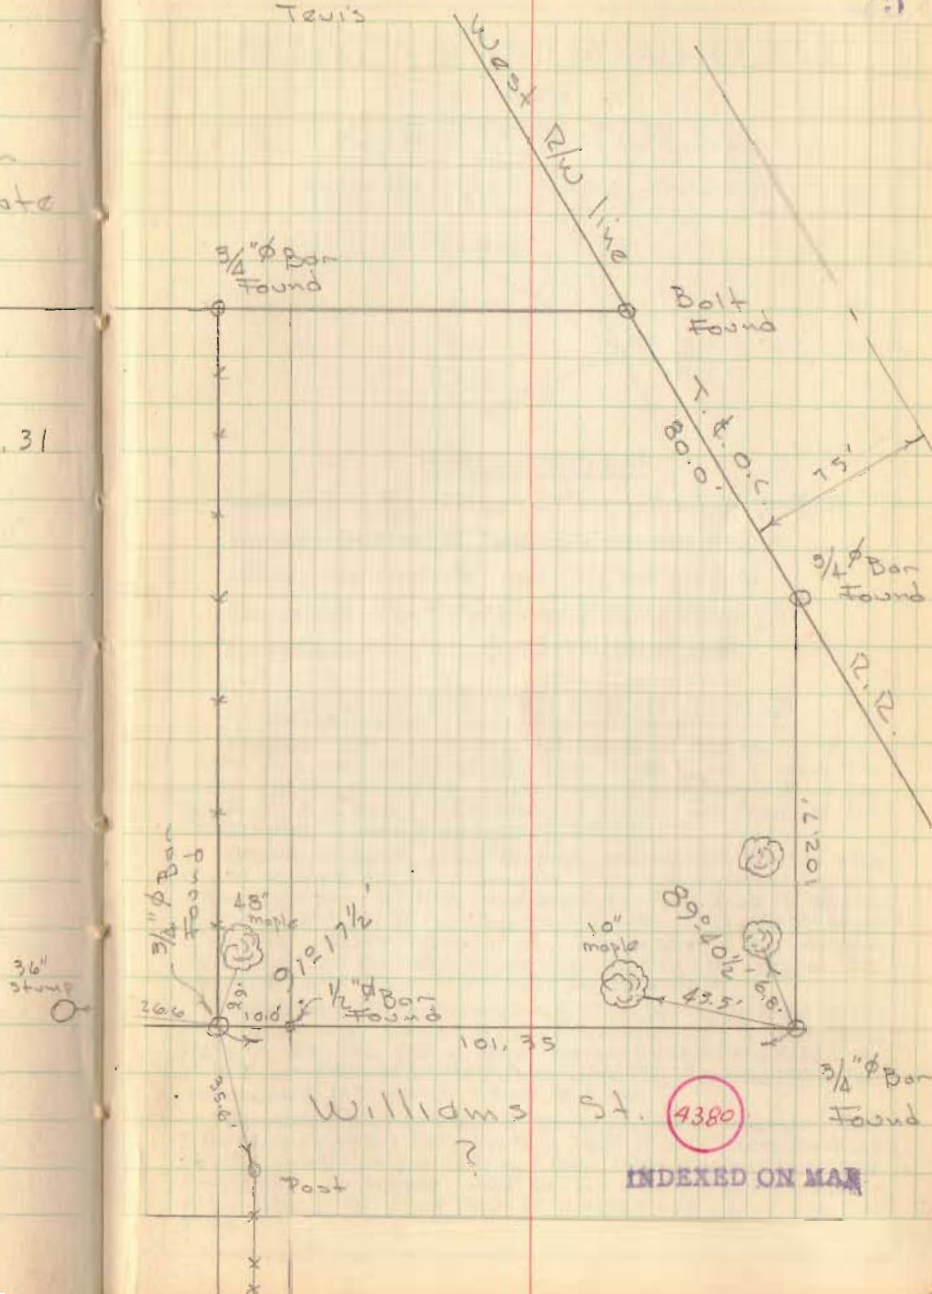

Williams St. 4380

INDEXED ON MAP