

S. 370. 235780 on U.S.R. No. 33

S. H. No. 100 B/W 7

Base Line

Indian Lake Golf Course


Bellevontaine
Development Co.

Washington T.W.D.

⊕ = Transit Points
Scale - 1" = 500'

4389

INDEXED ON MAP

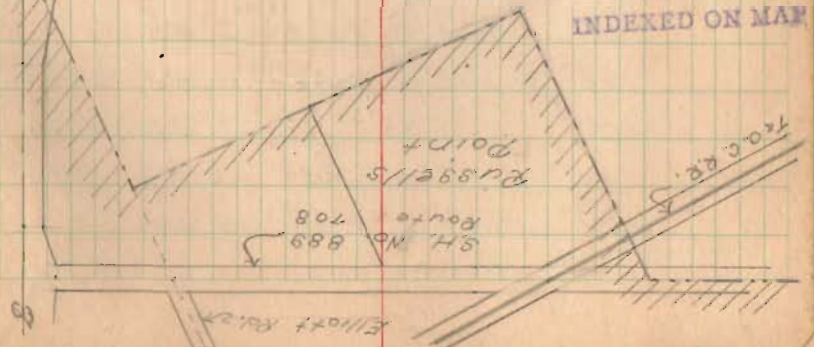

S.H. No. 889
Route 708

Russell's
Point

Elliott Point

K.O.C.R.P.