

December 7, 1968

The following described real estate situated in the Township of Washington, County of Logan, State of Ohio and being a part of Virginia Military Survey No. 9925-9946-10121 and being more particularly described as follows:

Beginning at an iron bar, southeast corner of Lot No. 12 of Smith Allotment No. 3 as recorded in Plat Book 4 Volume D Page 52, Logan County Recorders Office and also being the northeast corner of Albert W. Carder's present 0.25 Acre tract and also being in the west right of way line of Fester Street;

Thence with the west line of Fester Street, S. 6° 00' E. 38.0 feet to an iron bar;

Thence S. 86° 26' W. 72.0 feet to an iron bar set in the west line of Carder's present 0.25 Acre tract;

Thence with said west line of Carder's tract, N. 6° 00' W. 38.00 feet to an iron pipe, northwest corner of Carder's 0.25 Acre tract and also being the southwest corner of Lot No. 12 of Smith Allotment No. 3;

Thence with the south line of Lot No. 12, N. 86° 26' E. 72.0 feet to the place of beginning, containing 0.06 Acres, more or less.

The above described tract being surveyed off the north end of the present 0.25 Acre tract in the name of Albert W. Carder et ux.


I hereby certify that this is a true and accurate description of a survey made by me on December 7, 1968.

Daniel E. Gilbert
Daniel E. Gilbert, P.S.
Reg. Sur. No. 5402
428 N. Madriver St.
Bellefontaine, Ohio 43311



4470 ID
INDEXED ON MAP

EDISON ST. - 30'

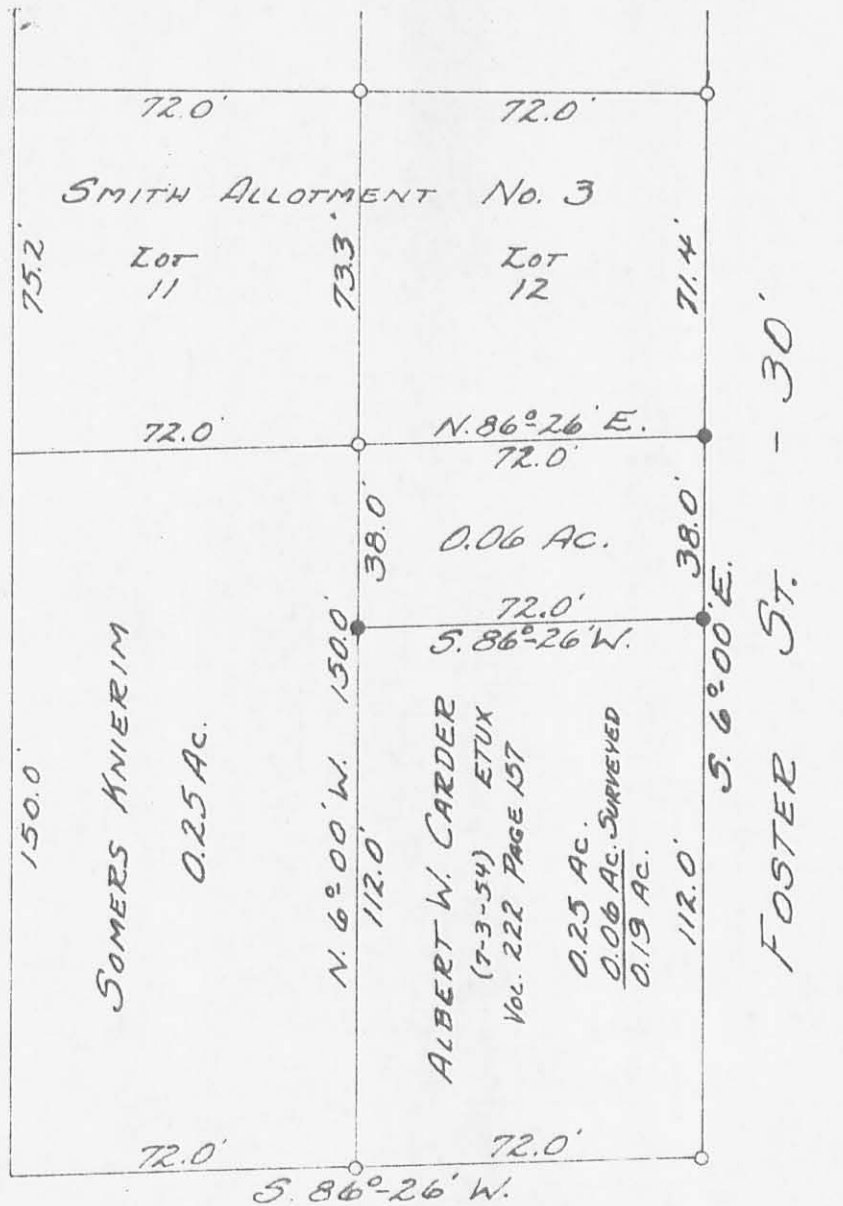

STATE ROUTE No. 366 &
60' R/W.

- - IRON PIPES FOUND.
- - 5/8" φ IRON BARS SET.

SURVEYED AND PLATTED BY:
DANIEL E. GILBERT, P.S.
REG. SUR. NO. 5402
428 N. MADRIVER ST.
BELLEFONTAINE, OHIO 43311



CARDER SURVEY
V.M.S. 9925-9946-10121
WASHINGTON TOWNSHIP
LOGAN COUNTY, OHIO
DECEMBER 7, 1968

SCALE: 1" = 40' (4470) IP