


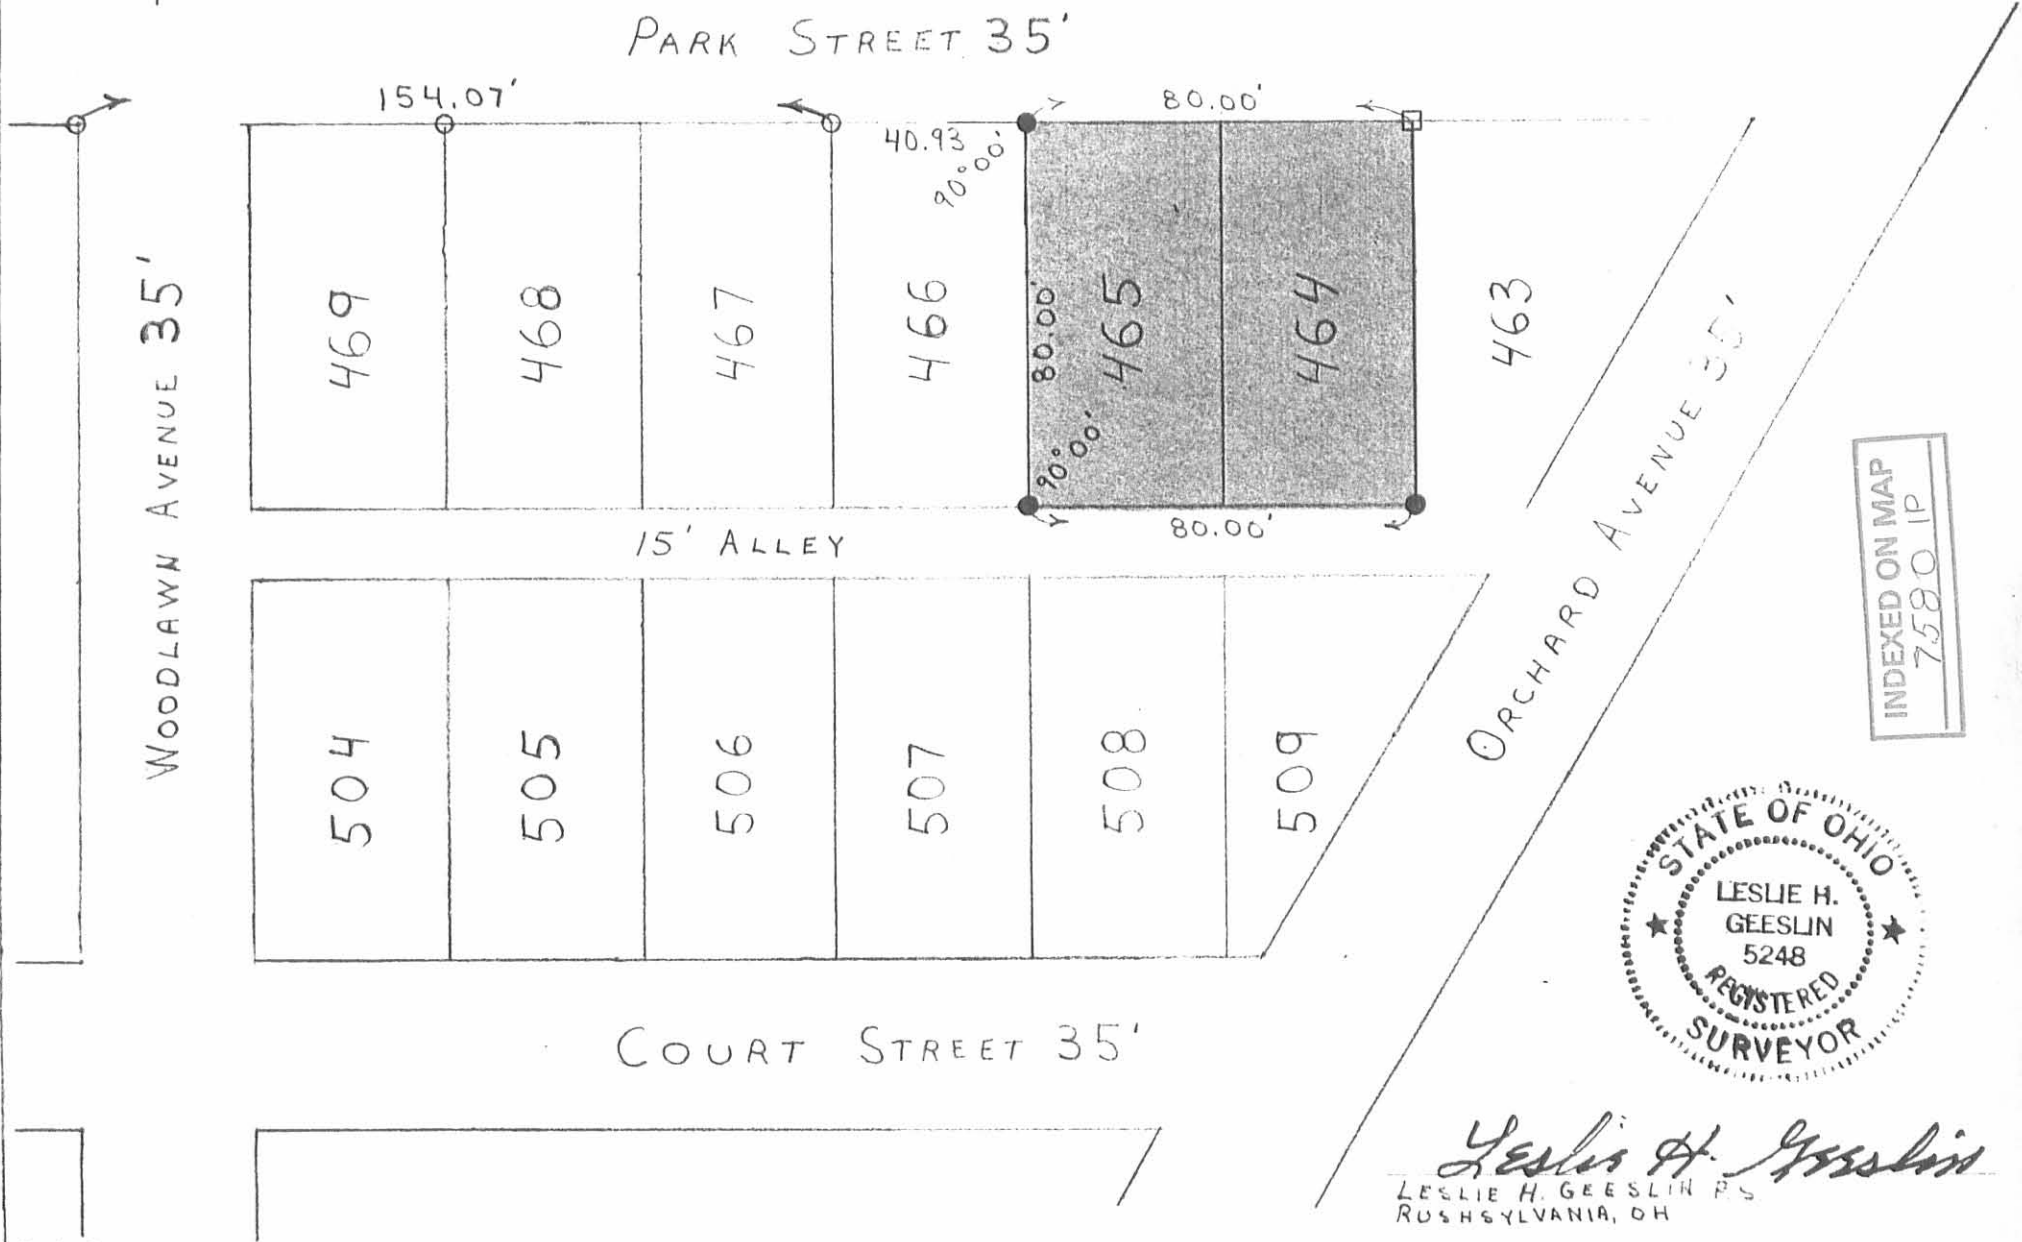

LEGION: □ = CONC. MON. FD.  
 ○ = 1/2" PIPE FD.  
 ● = 5/8" BAR SET

SCALE: 1" = 40'

SURVEY OF LOTS 464 AND 465 IN  
 ORCHARD ISLAND, SEC. 36, T. 6 S., R. 8 E.  
 WASHINGTON TWP., LOGAN CO., OHIO  
 DECEMBER 3, 1986



INDEXED ON MAP  
 7580 IP





*Leslie H. Geeslin*  
 LESLIE H. GEESLIN P.S.  
 RUSHSVLVANIA, OH

7-12-17  
 **APPROVED**

**LEGEND:**


- ⊕ 1-1/4 INCH IRON BAR FOUND
- ⊙ 1-1/2 INCH BAR FOUND
- 1 INCH BAR FOUND
- MAG NAIL SET IN DRILLED HOLE
- 5/8 INCH IRON ROD SET WITH PLASTIC I.D. CAP STAMPED "LSM"

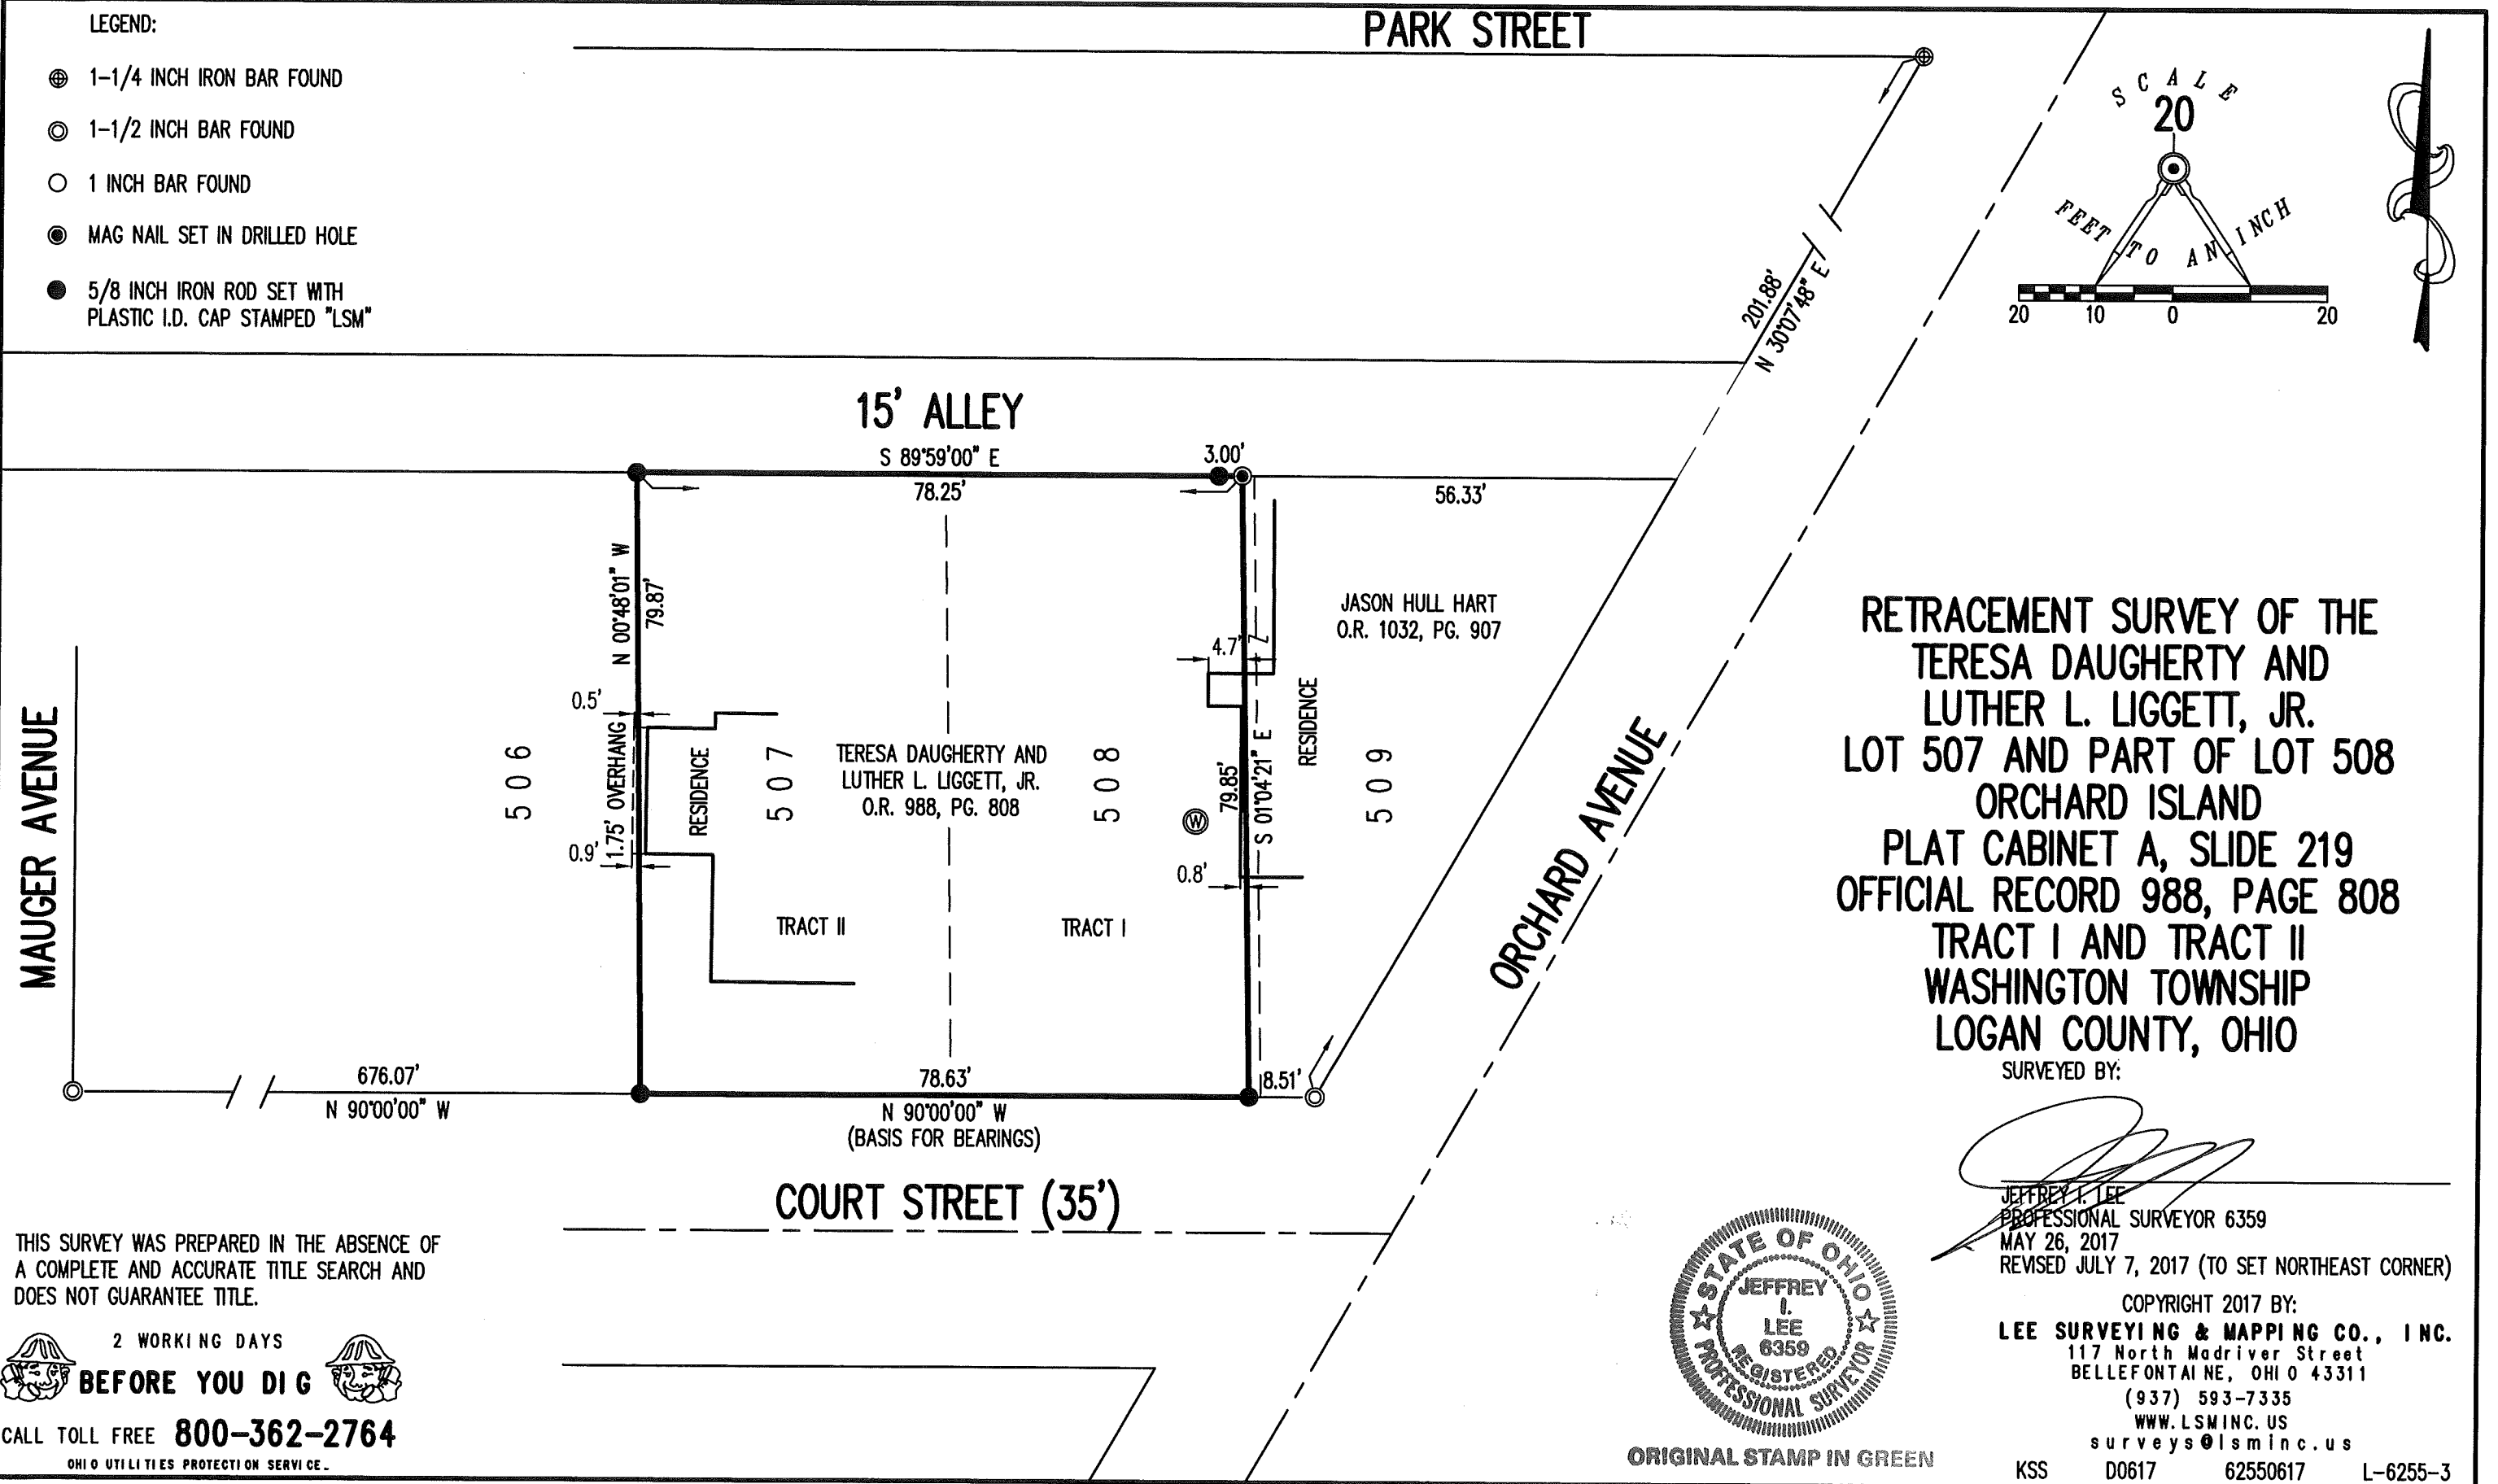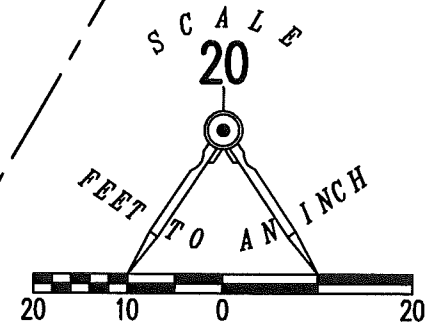

**RETRACEMENT SURVEY OF THE  
 TERESA DAUGHERTY AND  
 LUTHER L. LIGGETT, JR.  
 LOT 507 AND PART OF LOT 508  
 ORCHARD ISLAND  
 PLAT CABINET A, SLIDE 219  
 OFFICIAL RECORD 988, PAGE 808  
 TRACT I AND TRACT II  
 WASHINGTON TOWNSHIP  
 LOGAN COUNTY, OHIO**

SURVEYED BY:

*Jeffrey I. Lee*  
 JEFFREY I. LEE  
 PROFESSIONAL SURVEYOR 6359  
 MAY 26, 2017  
 REVISED JULY 7, 2017 (TO SET NORTHEAST CORNER)

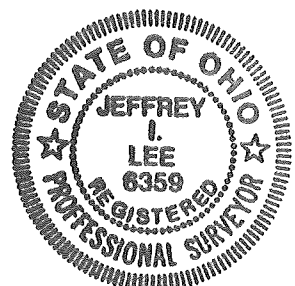

ORIGINAL STAMP IN GREEN

COPYRIGHT 2017 BY:  
**LEE SURVEYING & MAPPING CO., INC.**  
 117 North Madriver Street  
 BELLEFONTAINE, OHIO 43311  
 (937) 593-7335  
 WWW.LSMINC.US  
 surveys@lsminc.us  
 KSS D0617 62550617 L-6255-3

THIS SURVEY WAS PREPARED IN THE ABSENCE OF  
 A COMPLETE AND ACCURATE TITLE SEARCH AND  
 DOES NOT GUARANTEE TITLE.

2 WORKING DAYS  
**BEFORE YOU DIG**  
 CALL TOLL FREE **800-362-2764**  
 OHIO UTILITIES PROTECTION SERVICE.

INDEXED ON MAP  
 7580