


SCALE: 1" = 20'



LEGEND:

- ⊙ = 3/4 INCH IRON PIPE FOUND
- ⊖ = 1/2 INCH IRON PIPE FOUND
- = 5/8 INCH IRON BAR FOUND
- = 5/8 INCH IRON BAR SET

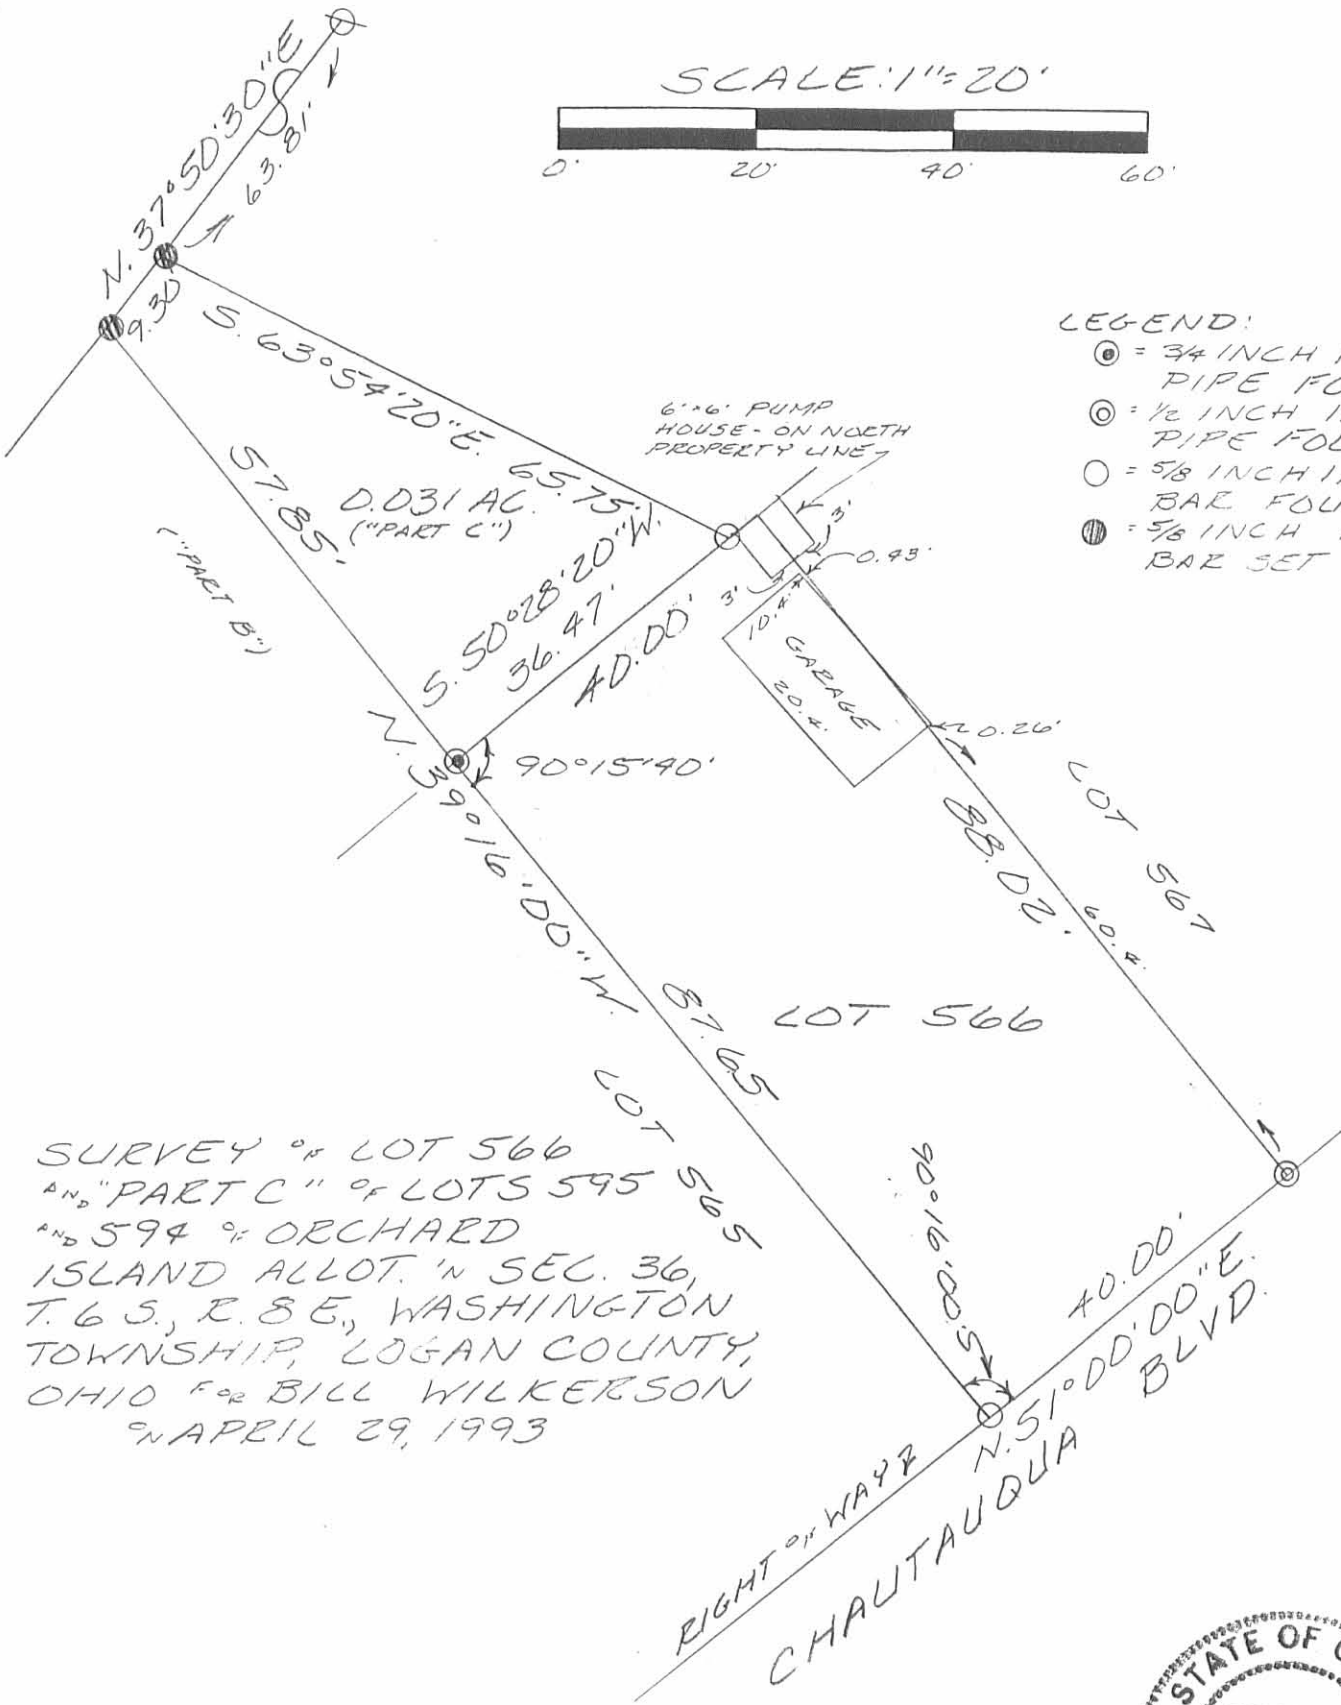

SURVEY OF LOT 566
 AND "PART C" OF LOTS 595
 AND 594 OF ORCHARD
 ISLAND ALLOT. 'N SEC. 36,
 T. 6 S., R. 8 E., WASHINGTON
 TOWNSHIP, LOGAN COUNTY,
 OHIO FOR BILL WILKERSON
 9 APRIL 29, 1993



Leslie H. Geeslin
 LESLIE H. GEESLIN
 RUSHSVLVANIA, OH
 (513) 468-2793

INDEXED ON MAP
 8795 IP