


CA Inskeep
FL Howell
Realtors
Survey of Lots
West Liberty Ohio

4/3/47

(See Book 11 Page 29) for location
of Center St
335-336-337 for
Milton W. Stout

- A $\frac{3}{4}$ " pipe (set) 60' N S line ^{Dickerson} SE cor Lot 337
B sq head bolt (set) S line and middle Lot 336
C $\frac{3}{4}$ " ϕ bar (set) SW cor Lot 336
D about 10' x 10' sq rigger head (found) ^{McGellan} Lot 337
E carriage bolt (set) N line and middle Lot 336
F carriage bolt (set) old foundation
stone removed if cor Lot 336
Occupation ok

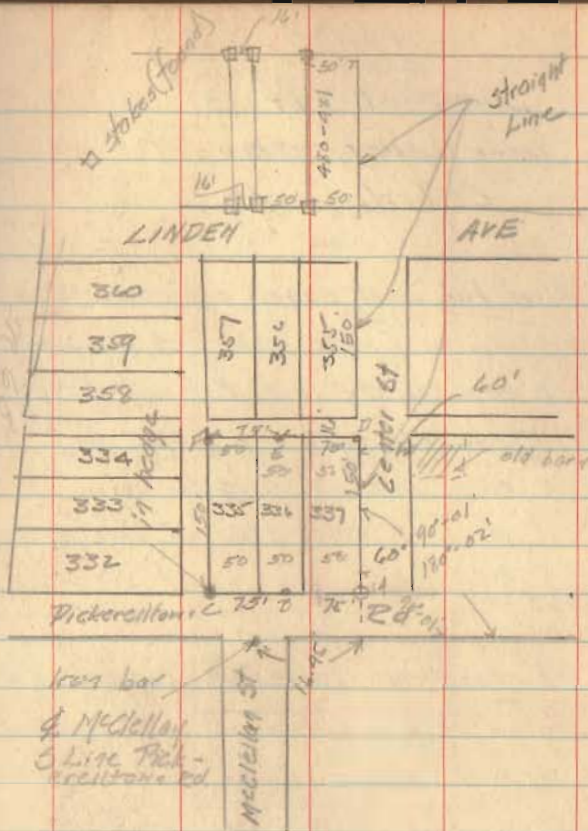

Straight Line NE cor Lot 331 SE corner 451
SE cor 337

INDEXED ON MAP

2343