


RUNKLE ST. 60'

FUSON ST. 70'
(VACATED)

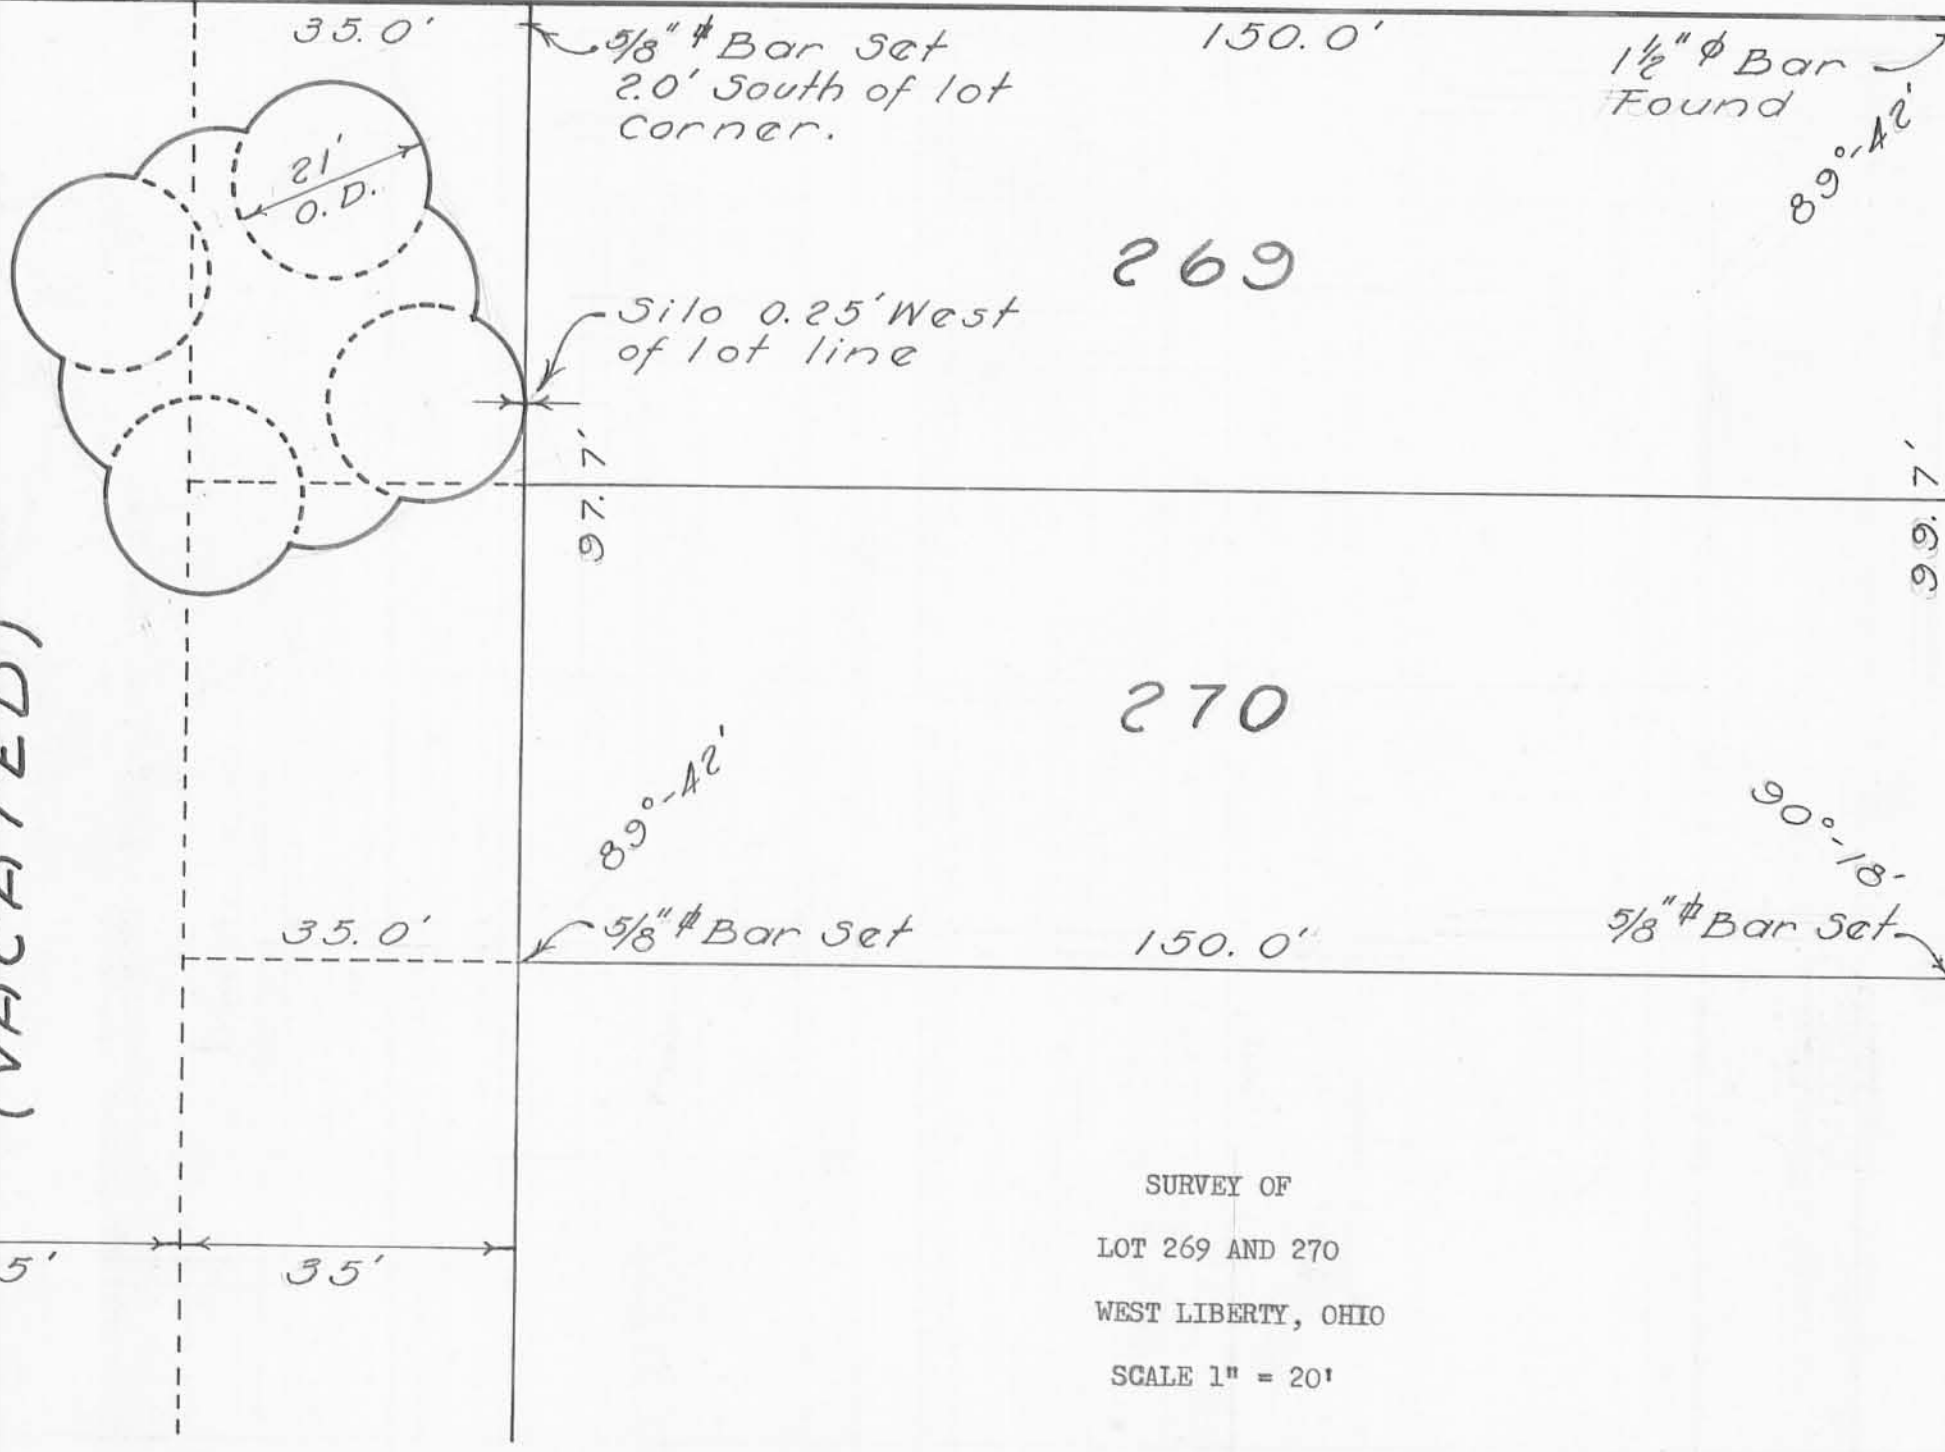

SURVEY OF
 LOT 269 AND 270
 WEST LIBERTY, OHIO
 SCALE 1" = 20'

Dan L. Dodson
 Surveyed by Dan L. Dodson
 Registered Surveyor No. 4270
 July 31, 1959

