


LOT 621

Book FW-27
Page 111

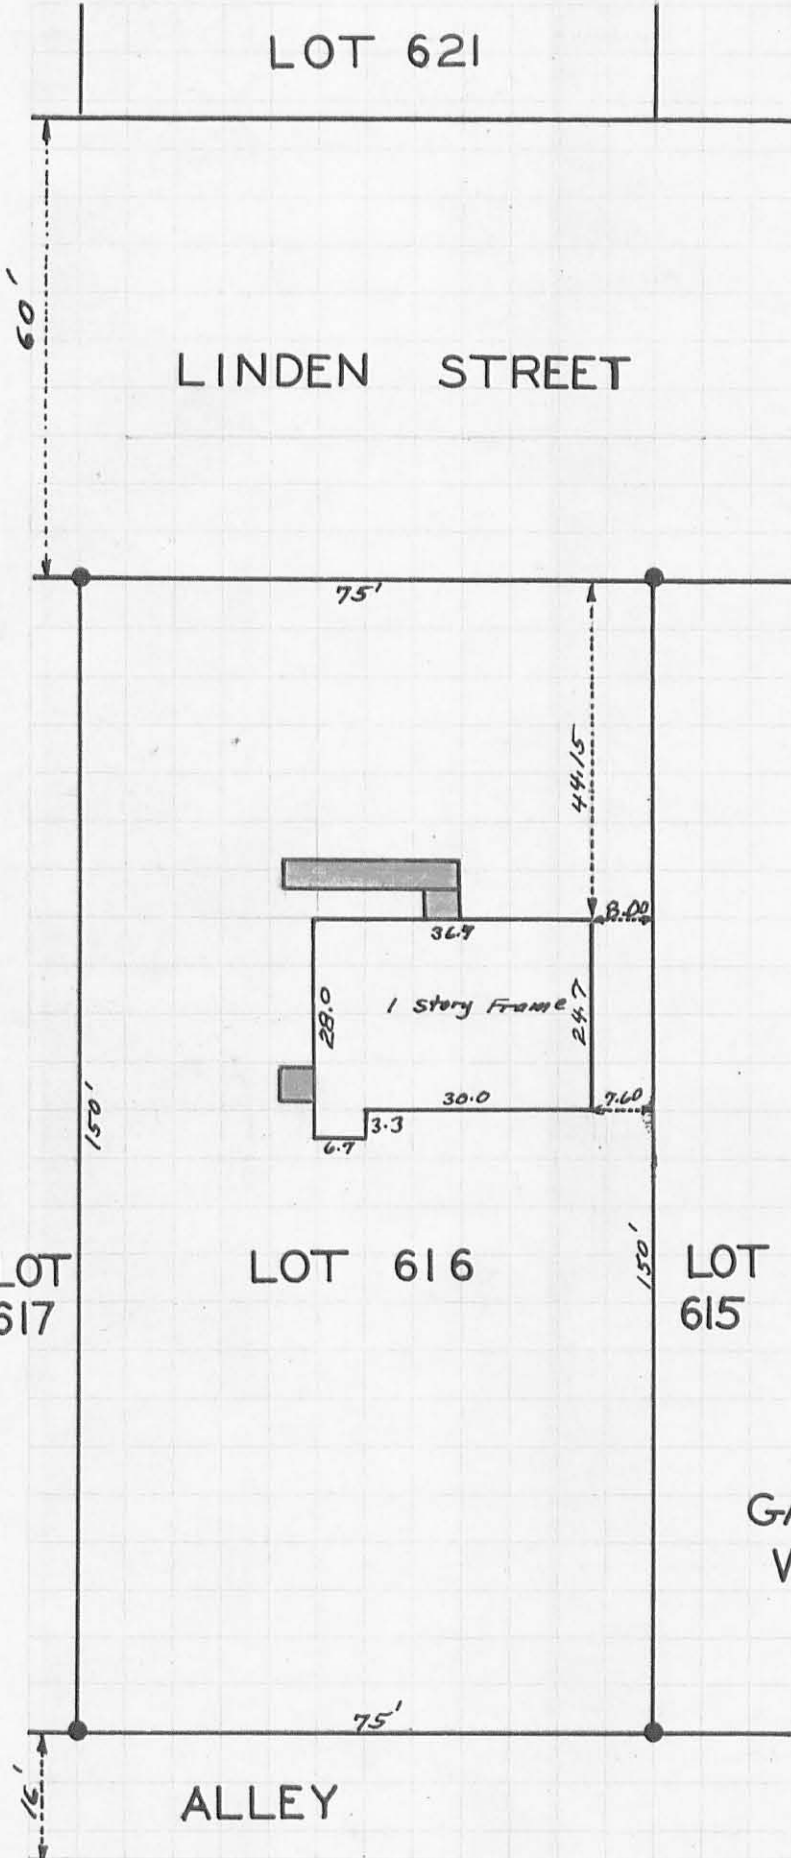

● Irons

I find no encroachments on
Lot 616 October 29, 1955

Foster F. Wright.
Foster F. Wright

254-3 IP

INDEXED ON MAP

ELMORE SURVEY
LOT 616
GARDEN ACRES ALLOTMENT
WEST LIBERTY OHIO
OCTOBER 29 1955
FOSTER F. WRIGHT
1"=25'