

Peele - Unterweger Survey West Liberty Part Lots 3 - 4 May 1963

The following described being in The Village of West Liberty, Liberty Township, Logan County, Ohio and being part of Lot Number 3 and part of Lot Number 2.

Beginning at an iron at the south side of East Baird Street at the N.E. corner of Lot Number 3. Thence with the south side of East Baird Street West 34.70 feet to an iron.

Thence turning ninty degrees to the left and measuring south 52.80 feet to an iron in the east side of Lot Number 2. The last described line passing the south line of Lot Number 3 and the north line of Lot Number 2 at 50.00 feet.

Thence with the east side of Lot Number 2 and the east side of Lot Number 3 N. 33 - 16 E. 63.15 feet to the place of beginning. The last described line passing the N.E. corner of Lot Number 2 and the S.E. corner of Lot Number 3 at 3.35 feet.

The above described being a tract off of the east end of Lot Number 3 and a triangular tract out of the N.E. corner of Lot Number 2 .

cc
Logan County Engineer

~~3554~~

3554

10-1



Peele - Unterweger Survey West Liberty May 1963

0.07 Acre

The following described land in The Village of West Liberty, Liberty Township, Logan County, Ohio and being in Section 27 Town 5 Range 13.

Beginning at an iron in the south side of East Baird Street at the N.E. corner of Lot Number 3. Thence with the east end of Lot Number 3 and the east end of Lot Number 2 S. 33 - 16 W. 63.15 feet to an iron said iron being the true beginning point of this survey.

Thence with the east end of lot Number 2 and the east end of Lot Number 1 again S. 33 - 16 W. 115.10 feet to an iron in the north side of George Trick's tract.

Thence with the north side of said George Trick tract S. 89 - 24 E. 63.10 feet to an iron.

Thence turning 91 - 36 to the left and measuring north 97.00 feet to the place of beginning.

The above described contains 0.07 of one acre and being out of the S.W. corner of a 0.25 acre tract now in the name of Delpha Peele.


cc
Logan County Engineer.

3554

ID 2



BAIRD STREET

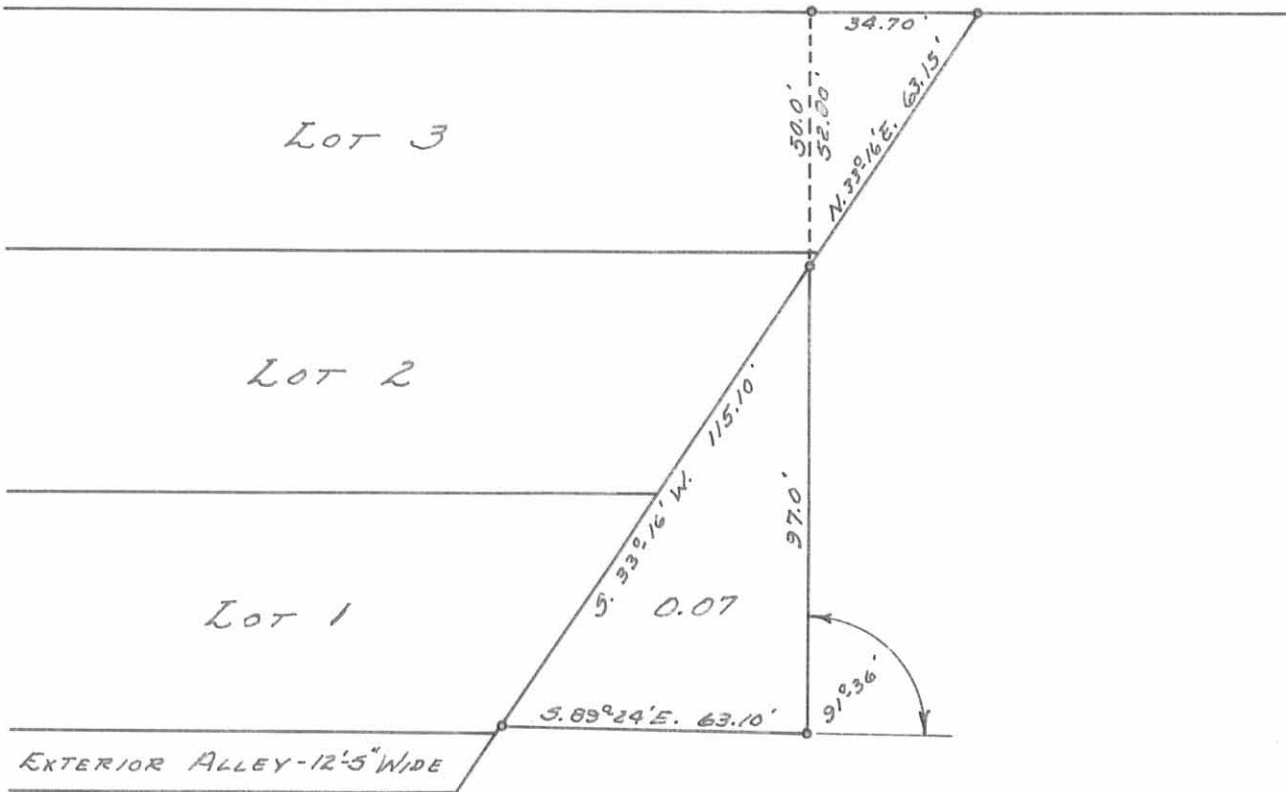

PEELE-UNTERWEGER SURVEY
 SECTION 25 TOWN 5 RANGE 13
 VILLAGE OF WEST LIBERTY
 LIBERTY TOWNSHIP, LOGAN COUNTY, OHIO
 PART OF LOTS NO. 2 & 3 AND 0.07 AC. TRACT
 SURVEYED BY F. F. WRIGHT - MAY, 1963
 DRAWN BY DANIEL E. GILBERT - SEPT. 7, 1963
 SCALE: 1" = 40'

3554 IP

INDEXED ON MAP