


Alley West Liberty

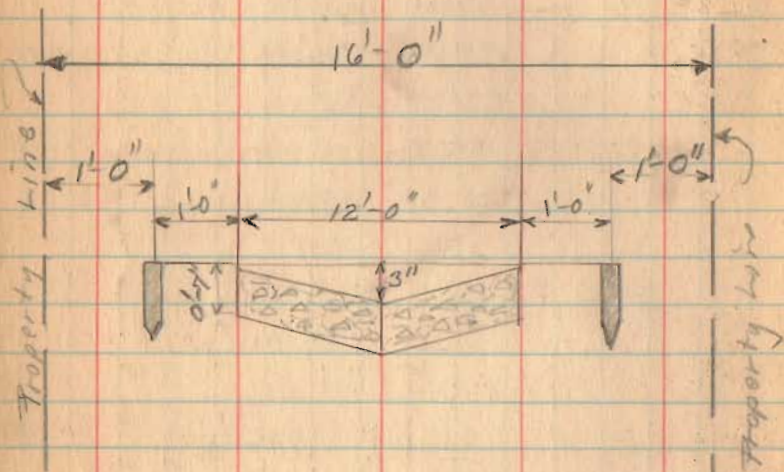

As staked.
Proposed X-sec.

INDEXED ON MAP

4436

4-28-33

48

