

Hostetler Apartments Survey
for William Hostetler

The following described real estate situated in the Village of West Liberty, Township of Liberty, County of Logan, State of Ohio and being a part of Section 27, Town 5, Range 13 and being more particularly described as follows:

Beginning at an iron bar in the apparent centerline of Sidney Street, said iron bar being N. 70° 30' E. 218.55 feet from an iron bar at the centerline of Reynolds Street and said iron bar also being the northeast corner to Emmett J. Hartzler's present 0.38 Acre tract;

Thence with the apparent centerline of Sidney Street, N. 70° 30' E. 291.00 feet to a R. R. Spike, passing through iron bars at 75.00 feet and 225.00 feet, said R. R. Spike being the northwest corner to Beulah M. Kauffman's present 0.17 Acre tract;


Thence with Kauffman's west line, S. 18° 07' E. 118.99 feet to an iron bar, said iron bar being in the north line of Mary Prater's present 22.48 Acre tract, said north line also being the south line of a tail race as shown on a survey made by F. F. Wright in March 1943, passing through an iron bar at 15.00 feet;

Thence with the north line of Prater's land and said south line of the tail race, S. 73° 35.3' W. 283.80 feet to an iron bar, said iron bar being the southeast corner to Emmet J. Hartzler's present 0.38 Acre tract;


Thence with Hartzler's east line, N. 18° 07' W. 110.55 feet to the place of beginning, passing through an iron bar at 95.55 feet, containing 0.747 Acres, more or less.

I hereby certify that this is the same land as described in Deed Volume 313 pages 190 through 197, except that portion of said tail race as is located south of the Liberty Township Trustees property on Sidney Street.

I hereby certify that this is a true and accurate description of a survey made by me on November 17, 1973

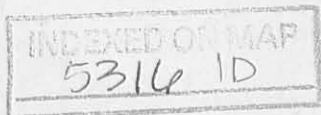

Daniel E. Gilbert
Daniel E. Gilbert, P.S.
Reg. Sur. No. 5402
1041 N. Main St.
Bellefontaine, Ohio 43111

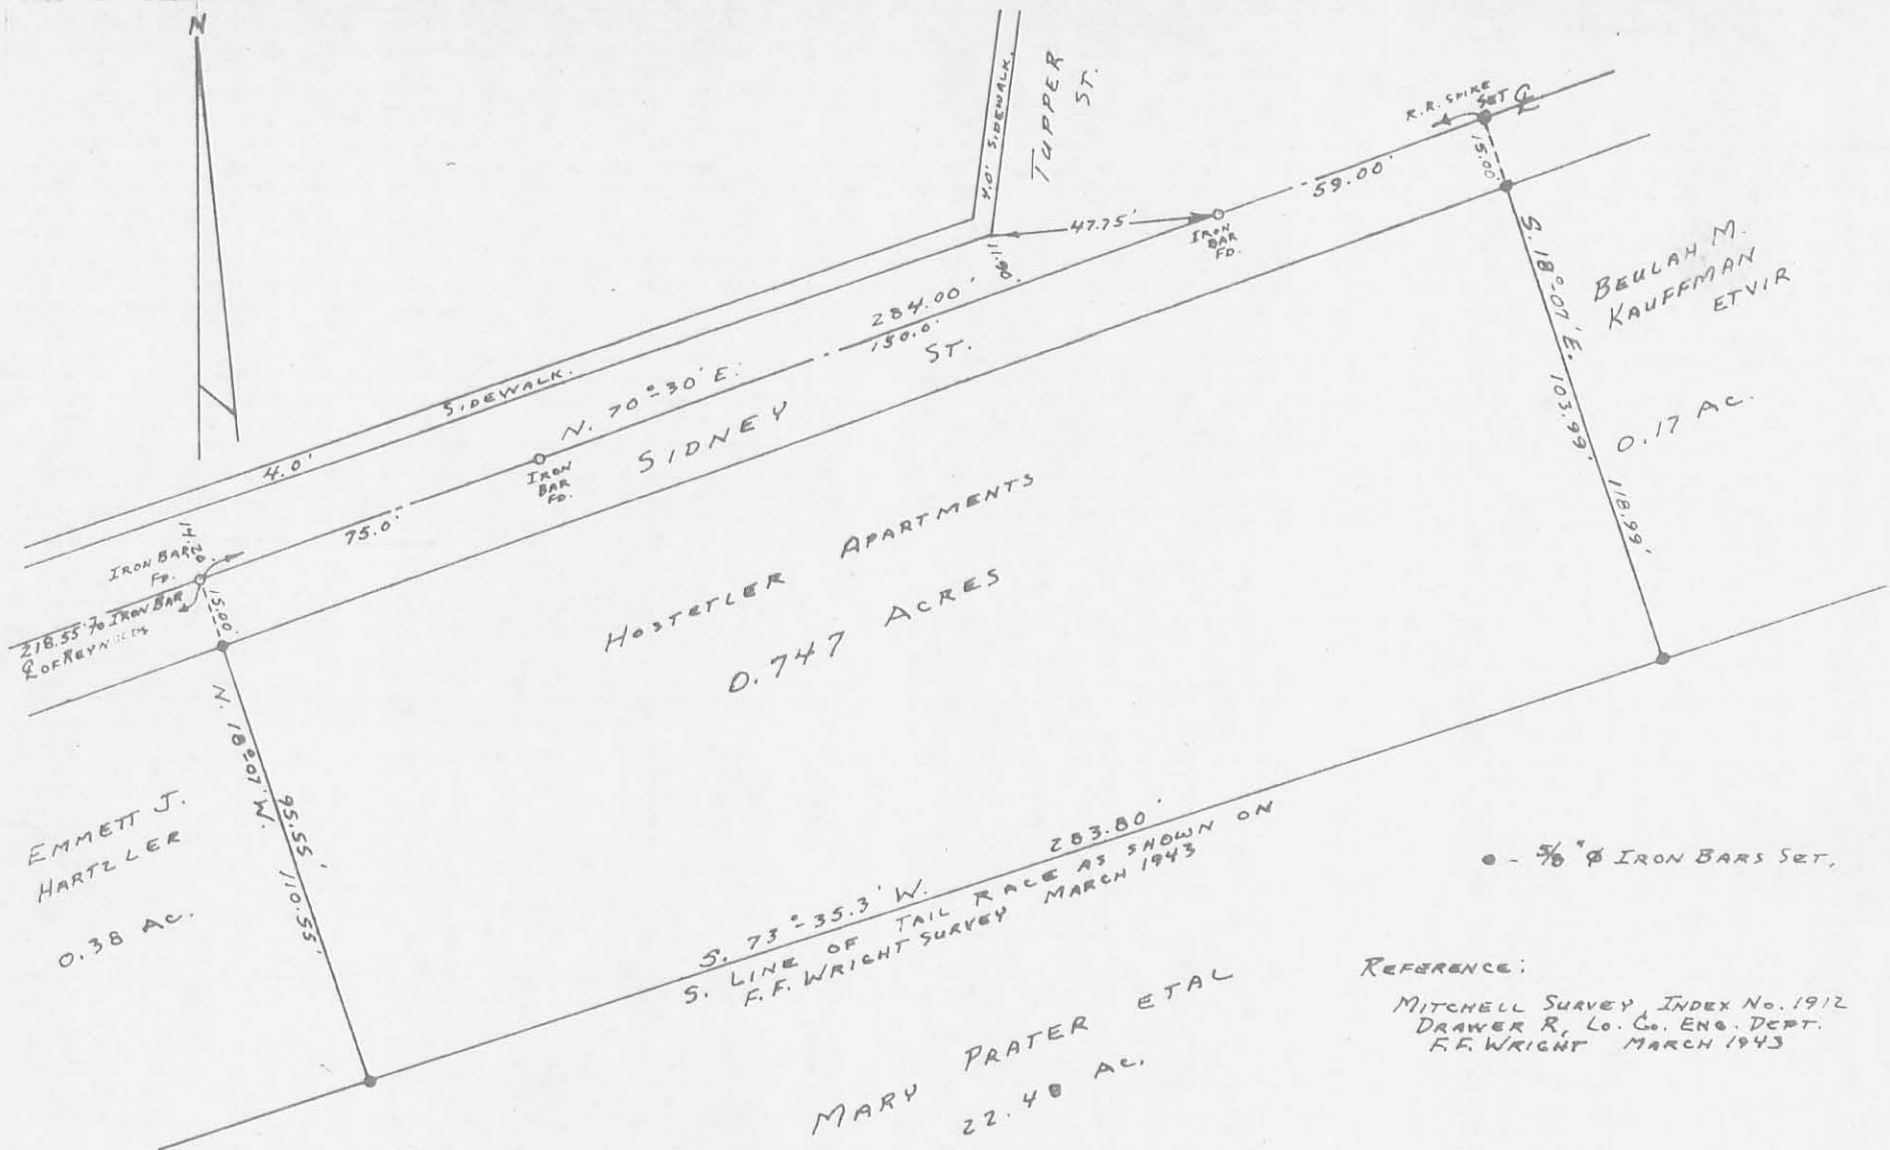

SURVEYED AND PLATTED BY:
 DANIEL E. GILBERT, P.S.
 REG. SUR. No. 5402
 1041 N. MAIN ST.
 BELLEFONTAINE, OHIO 43311

5316 IP
 INDEXED ON MAP

REFERENCE:
 MITCHELL SURVEY, INDEX No. 1912
 DRAWER R, LO. CO. ENG. DEPT.
 F.F. WRIGHT MARCH 1943

HOSTETLER APARTMENTS SURVEY
 SECTION 27 T. 5 R. 13
 VILLAGE OF WEST LIBERTY
 LIBERTY TOWNSHIP
 LOGAN COUNTY, OHIO
 NOVEMBER 17, 1973

SCALE: 1" = 40'