

BAILEY SURVEY

The following described real estate situated in the Village of West Liberty, Township of Liberty, County of Logan, State of Ohio and being a part of Section No. 27, T.5, R.13, B.M.R.S. and being more particularly described as follows:

Beginning at a P. K. Nail in the centerline of old C. H. No. 5 at Station No. 3 + 61.3 (F. B. No. 509 Page 49), said P. K. Nail being the northeast corner to Bailey Park (so called) as described in Deed Volume 147 Page 549 (1-28-1933)(Note: The centerline of old C. H. No. 5 at this point is not the centerline of U. S. R. No. 68 as shown on the right of way plan);

Thence with the centerline of old C. H. No. 5, N. 1° 35' E. 68.10 feet to a P. K. Nail set at Station No. 4 + 29.4 (F. B. No. 509 Page 49), this P. K. Nail being on the tangent centerline of U. S. R. No. 68;

Thence with the tangent centerline of U. S. R. No. 68, N. 17° 30' E. 99.71 feet to a point on the extension of the south line of Madalene O. Snyder's south line;


Thence with the south line of Madalene O. Snyder's present 0.62 Acre tract, N. 86° 59' W. 178.60 feet to a point in the centerline of C. H. No. 189, passing through an iron bar at Snyder's southeast corner at 30.98 feet and an iron bar at Snyder's southwest corner at 140.48 feet;


Thence with the centerline of C. H. No. 189, S. 14° 19' E. 184.79 feet to a P. K. Nail set at the northwest corner to said Bailey Park;

Thence with the north line of said Bailey Park, N. 86° 19' E. 101.00 feet to the place of beginning, containing 0.527 Acres, more or less, passing through iron bars at 14.05 feet and 80.95 feet.

I hereby certify that this is a true and accurate description of a survey made by me on October 18, 1980.

Daniel E. Gilbert
Daniel E. Gilbert, P.S.
Reg. Sur. No. 5402
1041 N. Main St.
Bellefontaine, Ohio 43311

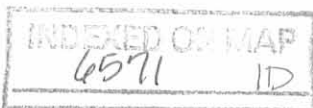

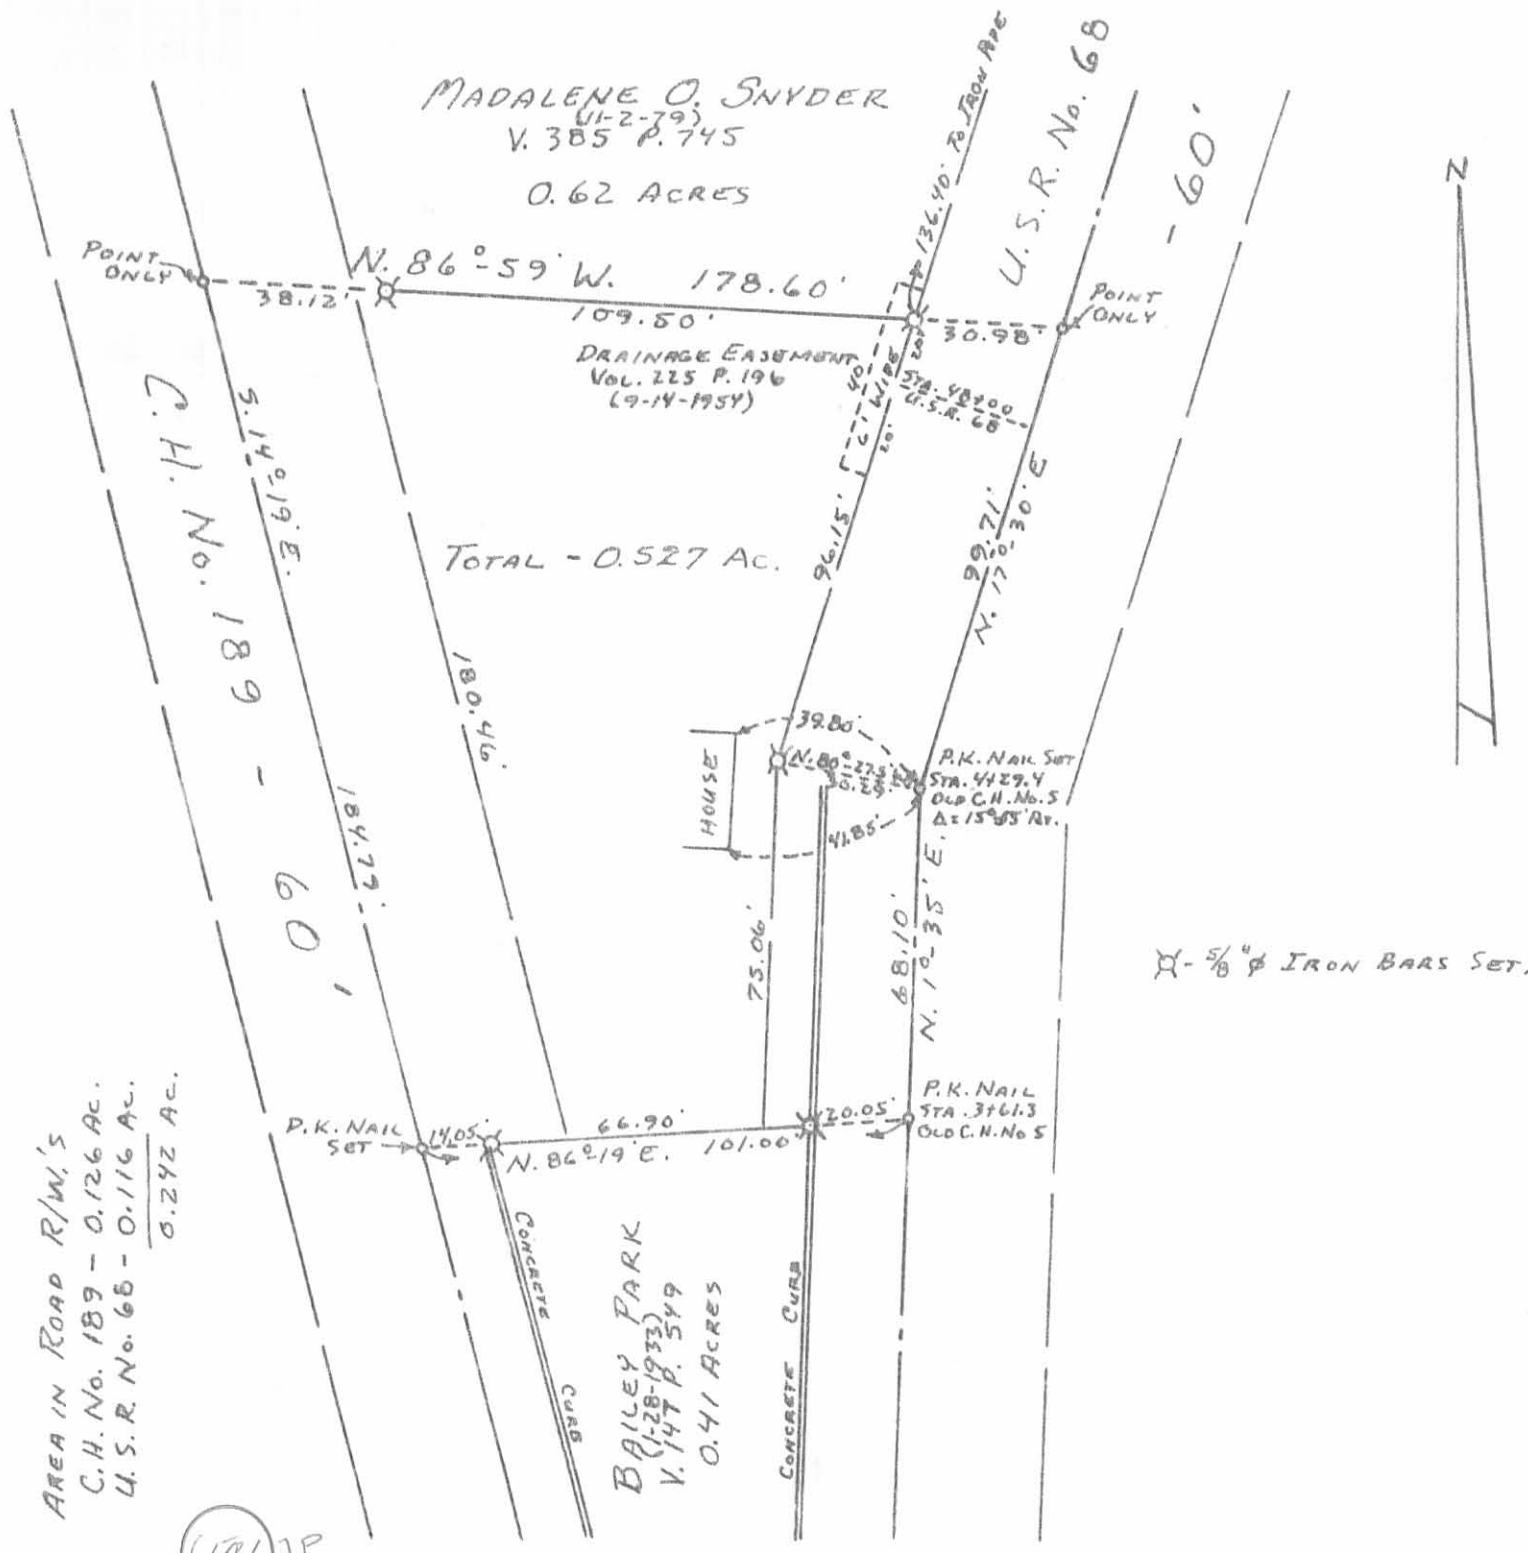

SURVEYED AND PLATTED BY:
 DANIEL E. GILBERT, P.S.
 REG. SUR. NO. 5402
 1041 N. MAIN ST.
 BELLEFONTAINE, OHIO 43311

BAILEY SURVEY
 SECTION 27 T.5 R.13 B.M.R.S.
 VILLAGE OF WEST LIBERTY
 LIBERTY TOWNSHIP
 LOGAN COUNTY, OHIO
 OCTOBER 18, 1980

SCALE: 1" = 40'