

MAP ROOM.

E. COLUMBUS ST. - 70'

N. 88°-00' E. 376.75

Basis of Bearing

1" Iron Bar Fd.

1" Iron Bar Fd.

LIBERTY ST.

- 60'

ALLEY

256

255

254

16.50'

50.00'

50.00'

50.00'

30.00'

90°-22'

89°-38'

89°-36'

35.00'

WASHINGTON ST. - 60'

N

150.85'

150.88'

159.15'

89°-40'

90°-20'

90°-20'

16.50'

50.00'

50.00'

80.00'

ALLEY


● - P. K. Nails Set.

○ - 5/8" x 30" Rebars Set.

Thoman Survey
Lot No. 255
Village of West Liberty
Liberty Township
Logan County, Ohio
February 6, 1990

Scale: 1" = 40'

INDEXED ON MAP
7993 1P

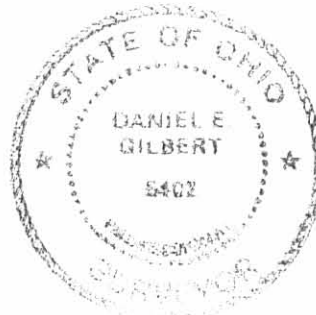


Daniel E. Gilbert

Daniel E. Gilbert, P.S.
Reg. Sur. No. 5402
400 N. Park St.
Bellefontaine, Ohio 43311

090-010

MS 97-74
RUTSCHILLING

(15)

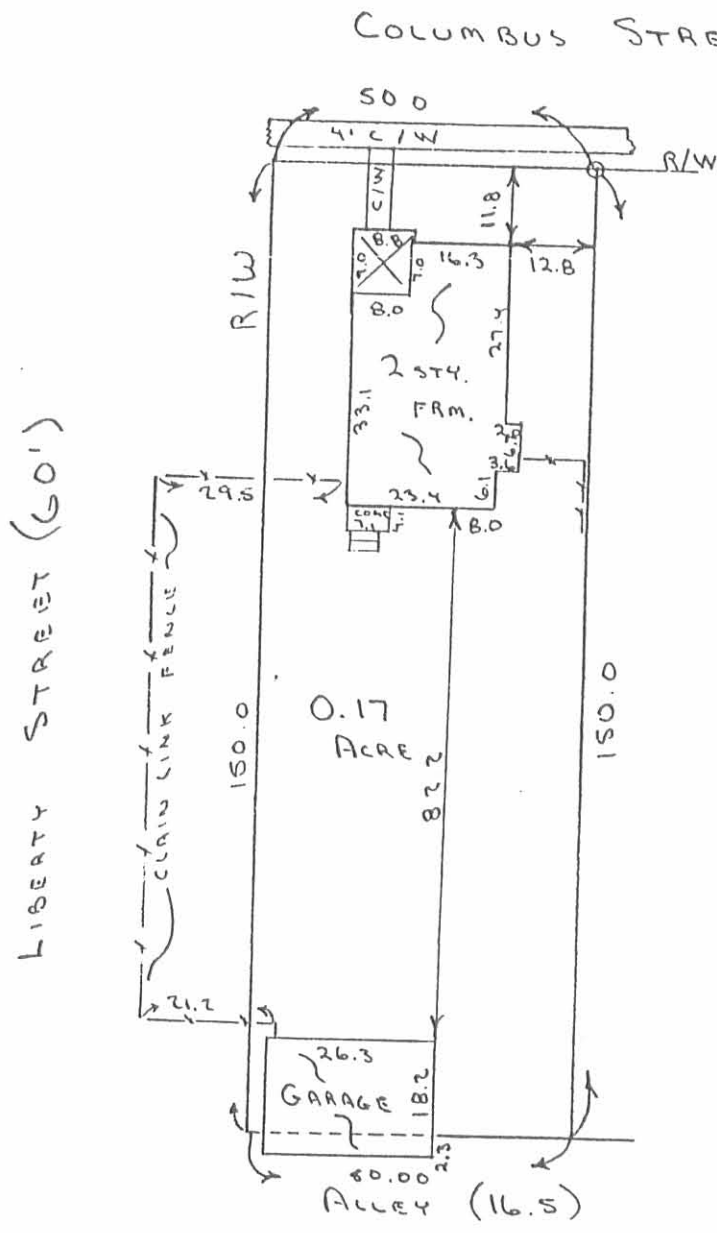

SCALE: 1" = 30'

LEGEND:

O = 5/8" IRON BAR PD

PROPERTY ADDRESS:

301 E. COLUMBUS ST.
WEST LIBERTY, OHIO

MORTGAGE SURVEY OF A
0.17 ACRE TRACT IN THE
VILLAGE OF WEST LIBERTY,
LIBERTY TWP., LOGAN CO.,
OHIO. JULY 21, 1997

FOR MORTGAGE PURPOSES ONLY

I hereby certify to Lawyers Title Insurance Co. that on July 21, 1997 I made an accurate survey of the premises shown hereon and that there are no easements or encroachment visible on the ground other than those shown hereon. This is a mortgage location survey prepared in accordance with Chapter 4733-38 of the Administrative Code. It is not a boundary survey pursuant to Chapter 4733-37 of said code. This mortgage survey is not to be used by the property owner to establish property lines.



I received a copy of this survey this ____ day of ____ 19__.

Borrower

Leslie H. Greslin
LESLIE H. GRESLIN
RUSHSVLAVANIA, OHIO
PH: (937) 468-2793
(D.L.G.)

INDEXED ON MAP
7993 2P