


NOTE:
 Shaded Area (19.42' E-W x 50.00' N-S) on Lot No. 78, occupied by Gary J. Weatherby, D. Vol. No. 394 P. 324 (11-4-1981), but is a part of the Village of West Mansfield's part of Lot No. 78, D. Vol. No. 159 P. 533 (1-31-1939). No deed of record showing a transfer of this part out of said villages tract.

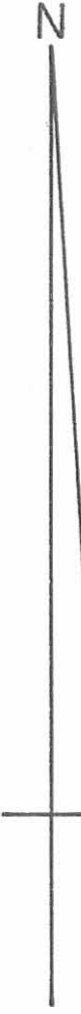

Scale: 1" = 40'

SYMBOLS:
 ○ - P. K. Nails Set.
 ● - 5/8" x 30" Rebars Set. (Capped).
 ○ - 3/4" Iron Pipes Fd.

Reference:
 D. Dean's Addition (7-29-1881).
 Plat Cabinet A, Slide 188.
 Lots No. 73-78 (50' x 209.42').



Survey of Water Tank Tower Site -East Part of Lots No. 77-78, Village of West Mansfield, V.M.S. No. 775-6155, Bokescreek Township, Logan County, Ohio.

SCALE: 1" = 40'	APPROVED BY:	DRAWN BY: DEG
DATE: 10-12-2002		REVISED:

Daniel E. Gilbert
 Daniel E. Gilbert, P.S.
 Reg. Sur. No. 5402

DRAWING NUMBER: 2002-025

INDEXED ON MAP
 7551 1P