


COUNTY LINE SURVEY

1876 By F.J. Sager

(195)
INDEXED ON MAP

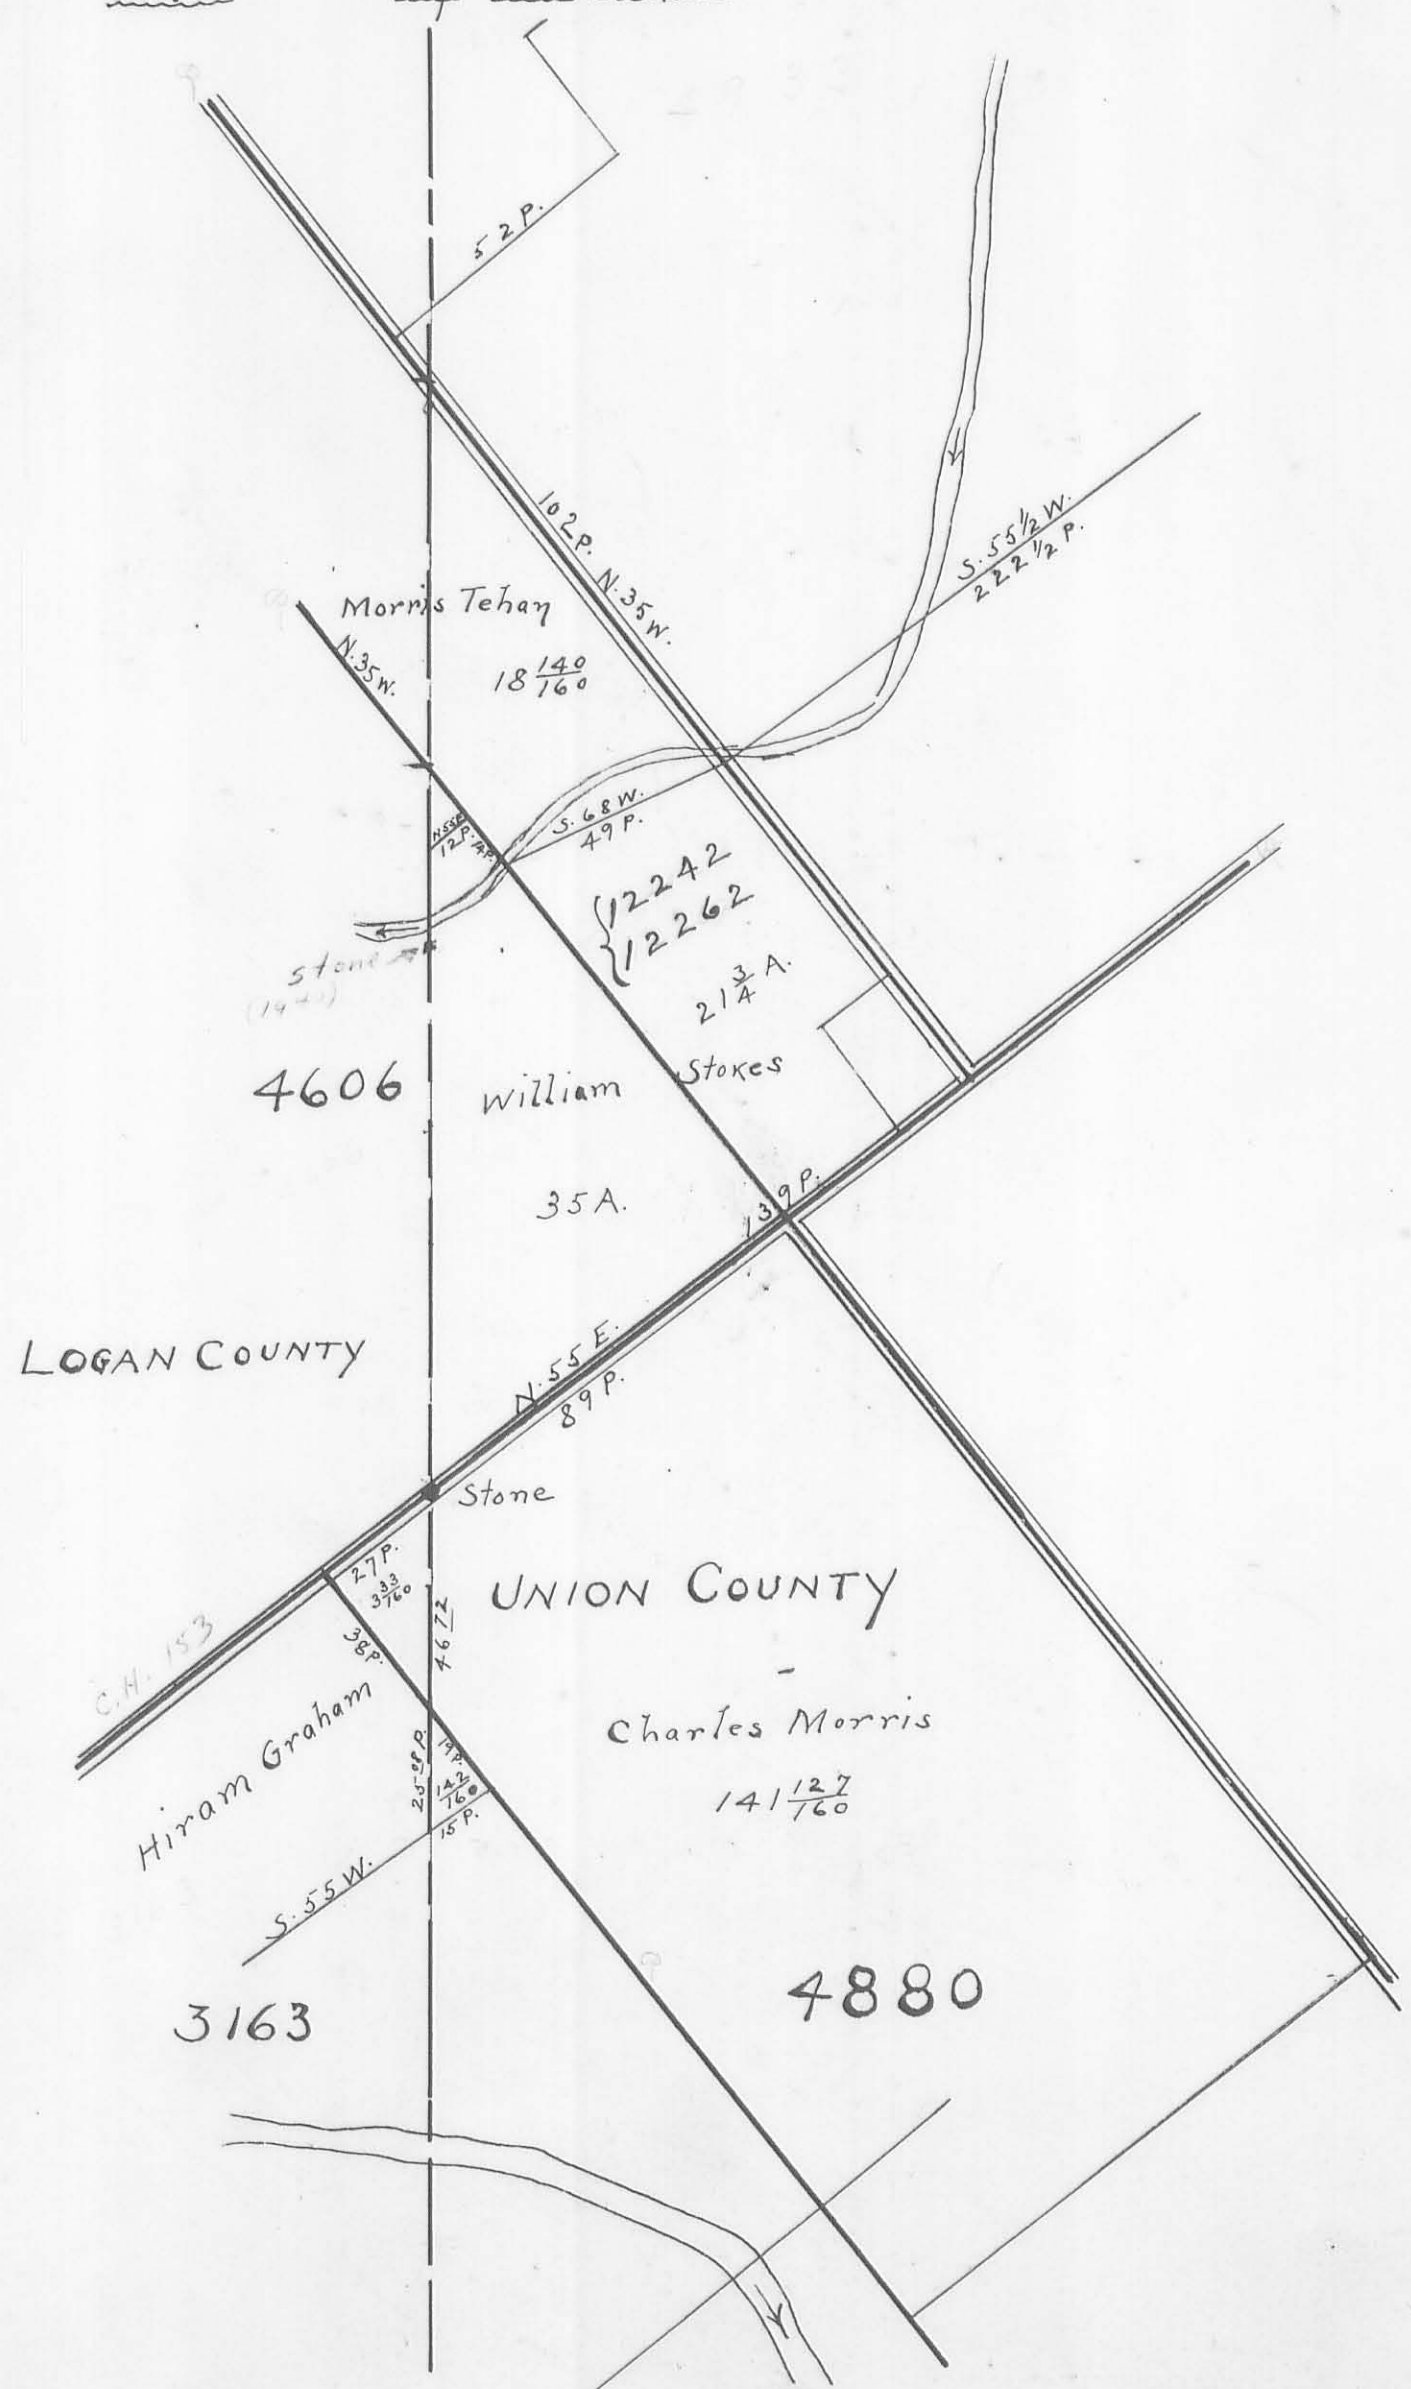

4606

12242
12262

William Stokes

35A.

LOGAN COUNTY

UNION COUNTY

Charles Morris

141 127/160

3163

4880

C.H. 153

Hiram Graham

4672

38 P.

27 P.

33 3/8

33 3/8

