

Road #148
Time

| | May 9, 30 | May 12, 30 | May 13, 30 |
|---------------|-----------|------------|------------|
| J.S. Crane | | | |
| A.M. Renick | 1 | 1 | 1/2 |
| Harold Taylor | 1 | 1 | 1/2 |
| Clair Stubbs | X | 1/2 | X |
| Alfred Grubbs | | 1/2 | |

| | 90/35 | 240 | 240 |
|--------------------|-------|-----|-----|
| Lunches | | | |
| Livery A.M. Renick | | | |


Time filed to May 13 inc.

1309
INDEXED ON MAP


Zane Top.

Road # 148


32

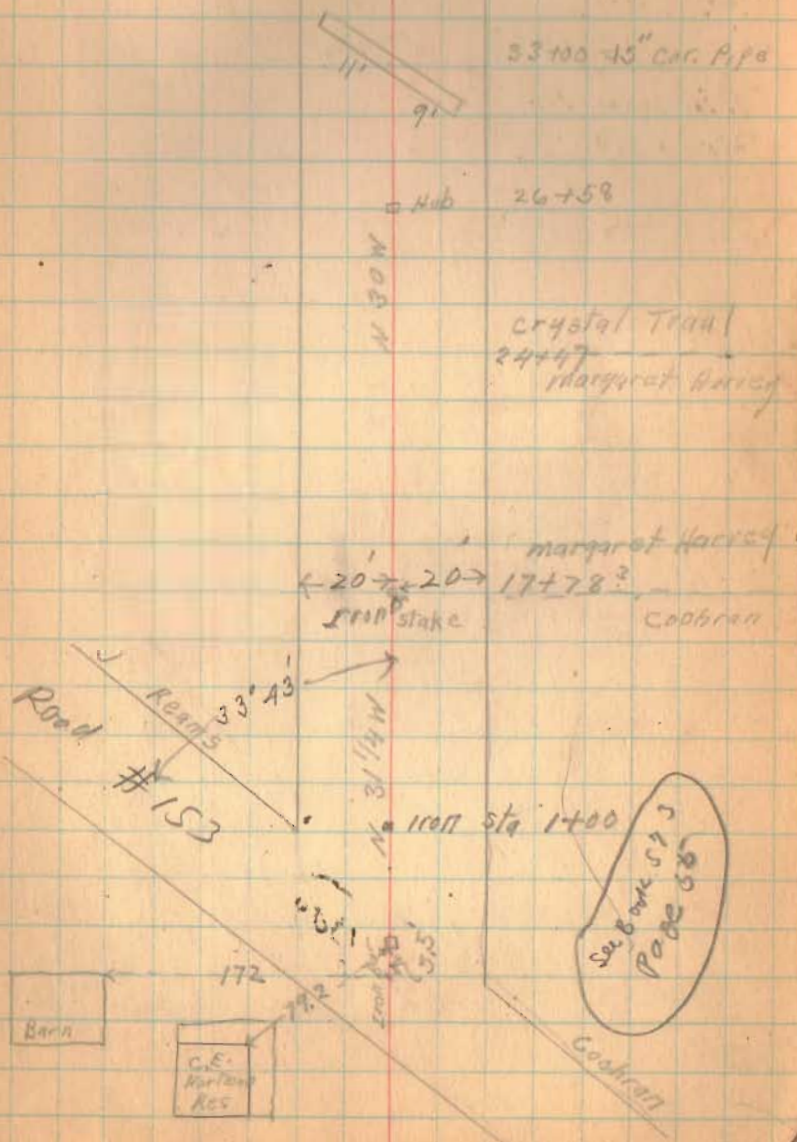

1/2
5/6
4

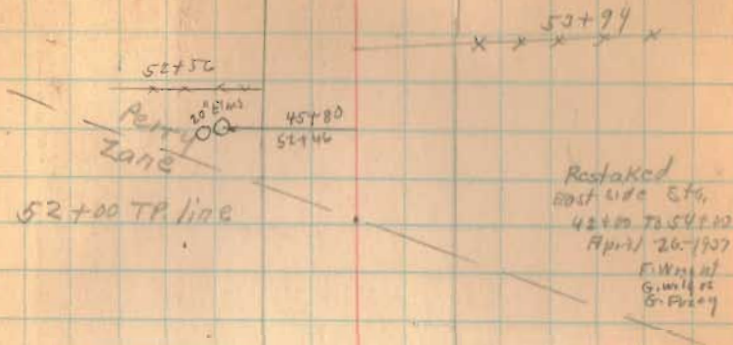

C.S. Hockett Trustee
 49+71
 J. Reams

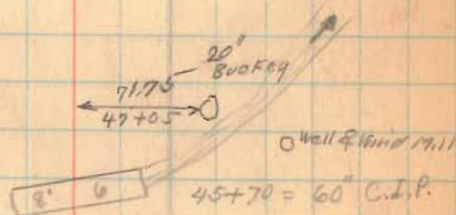

1309
 INDEXED ON MAP

