

S.H. 607 Monroe^{9th} zone Twp.
State Route 287

MacCree Pike

Free Turnpike Record No. 5 Page 479

60' From {Lodden To {George Smith Corner
 {Road No. 1 {Road No. 28

West Middleburg Pike

Free Turnpike Record No. 5 Page 393^{9th} 394

60' Page 394

50' Johnson Pike Road 28 To
Church Corner
Road Record 5 Page 452

← Old County Road No. 15 from
West Liberty To Union Chapel Church.

Union Chapel church To Middleburg
old Co. Road No. 41

↙ Middleburg To S.H. 235 old
County Road No. 119

(1467)
INDEXED ON MAP

S.H. 607

Stakes Placed 30' from E for 60' Road.
Numbered stakes Placed 2-4-6-8-10 etc.
Distances to Buildings for Map purposes
only, Not intended for actual distances
to hold E. Measurements placed as
shown turned 90° with transit and
measured accurate,

1467
INDEXED ON MAP.

Monument 1700 (All monuments
both sides unless noted)
30' from E


See Plan L-25 for S.H. 607

See Plan L-14 for S.H. 595
S. 15-22 E.


N 75-11 E
D 89-27
(Plan L-14)

Dec. 11-1931
Rainy

13

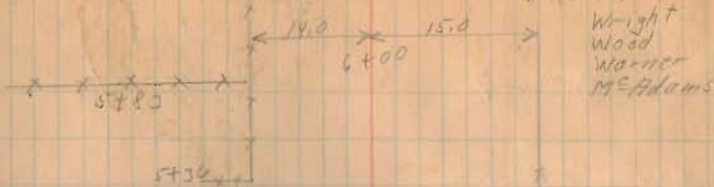

Drill 5733

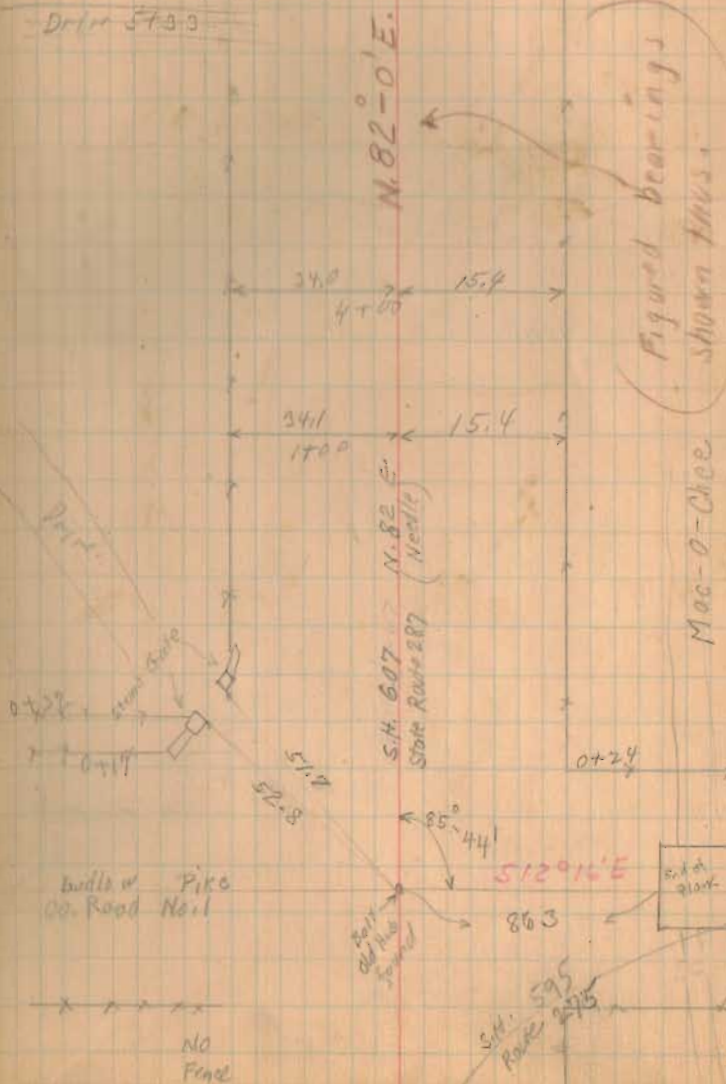

S.H. 607

22+00 Mon.

17+00 Mon.


12+00 Mon.

7+00 Movement

1467
INDEXED ON MAP

DEC-12-1931
Clear - (Fog AM)
Wright
McKinnon
Warr
McAdams
Wood

14

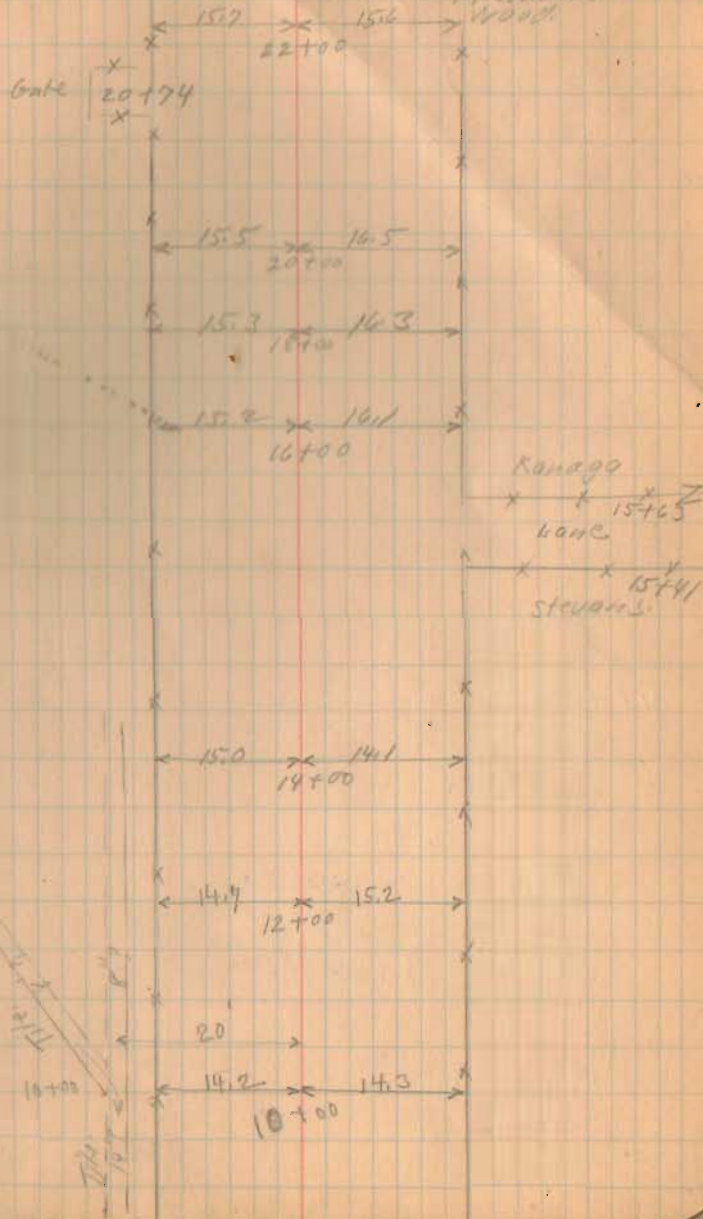

S.H. 609


31+00 Mon.

1867
INDEXED ON MAP

27+00 Mon.

12-12-51

15

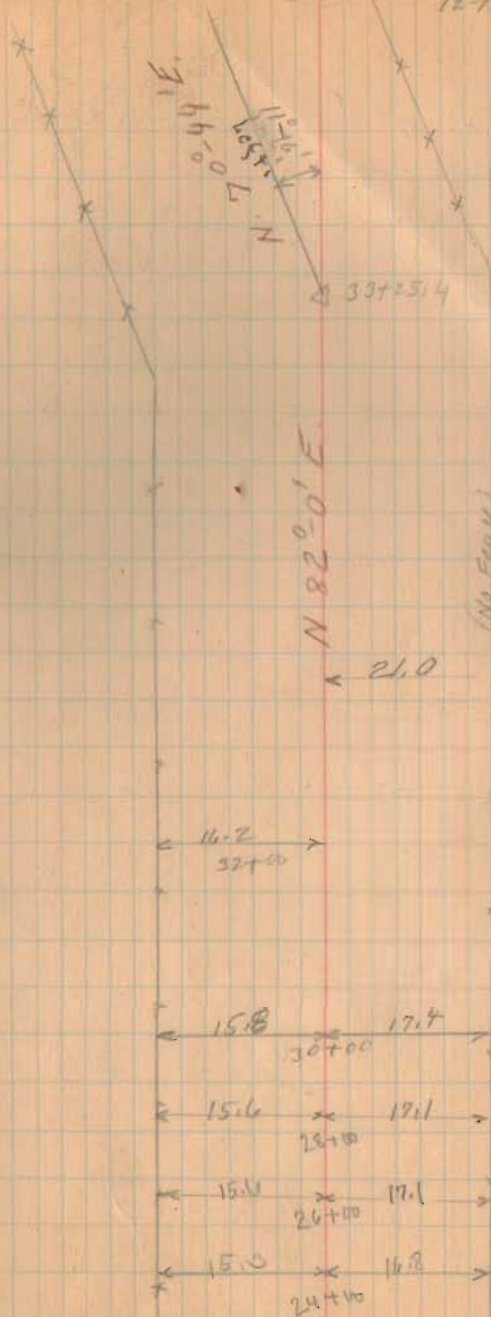

Δ 11°-16' left.
 P.L. 33+25.4
 R. - 954.93
 D - 6°
 T. - 94.19
 E. - 4.63
 L. - 187.79 (Hrc.)
 P.C. - 32+31.21
 P.T. 34+19



ETWIN

No. Fence

(Lane)

Heater

31+92
Kanaga


S.H. 607
45+00 Mon.

40+00 Mon.

1467
INDEXED ON MAP

35+00 Mon.

16

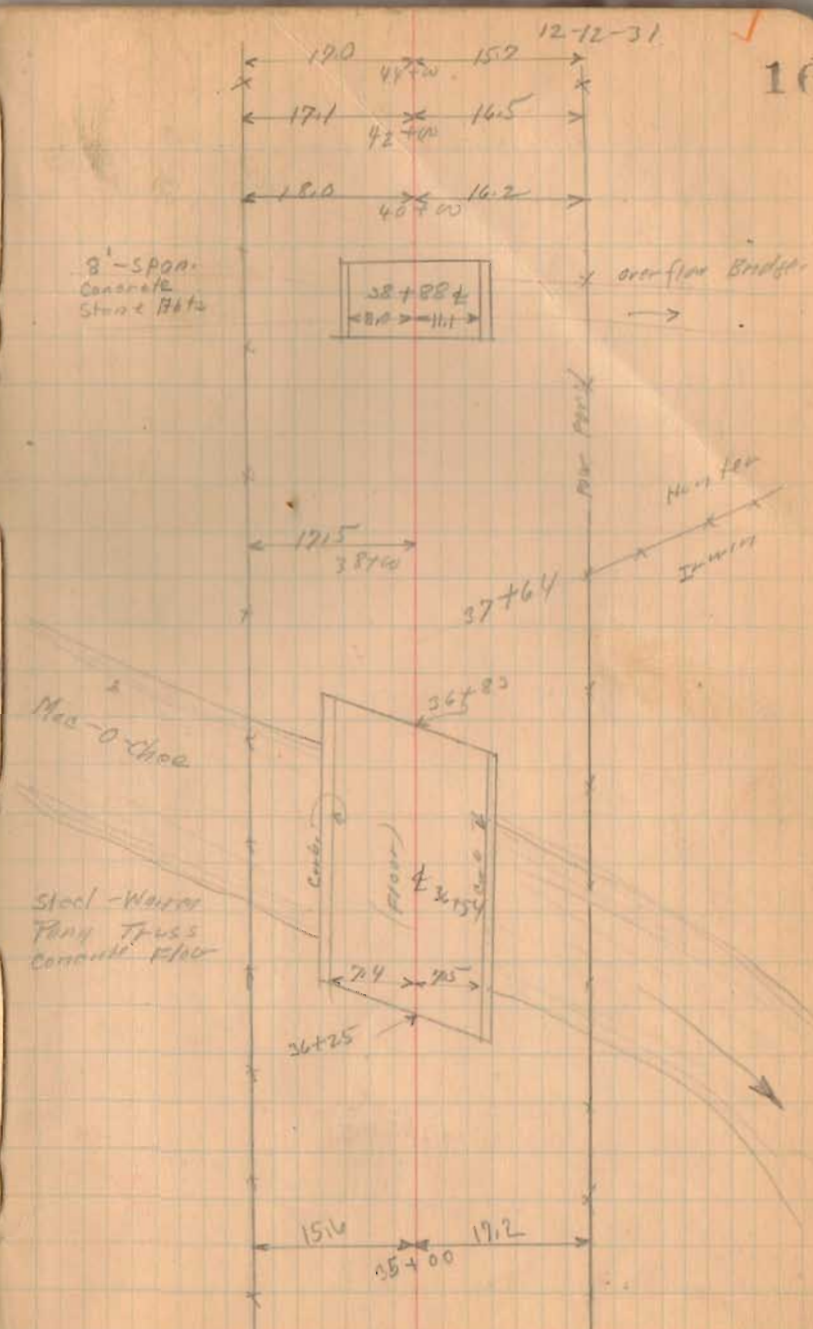


S.H. 607

50+00 Mon

1467
INDEXED ON MAP

DR # 14-1931
Windy Cloudy
Winged
MSPK
Winged
Winged
MSPK
17
8-21' LAY.
53+46 (No Curve)
Started.

Stuck in
52+12
Co. Road No 166
E 52+12

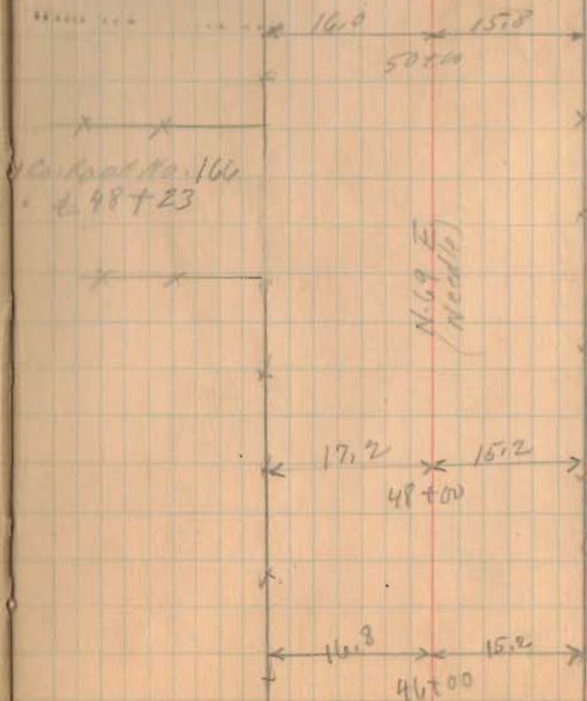

S.H. 607

65+00 Mon


60+50 Mon

1467
INDEXED ON MAP

56+00 Mon

12-14-31

18

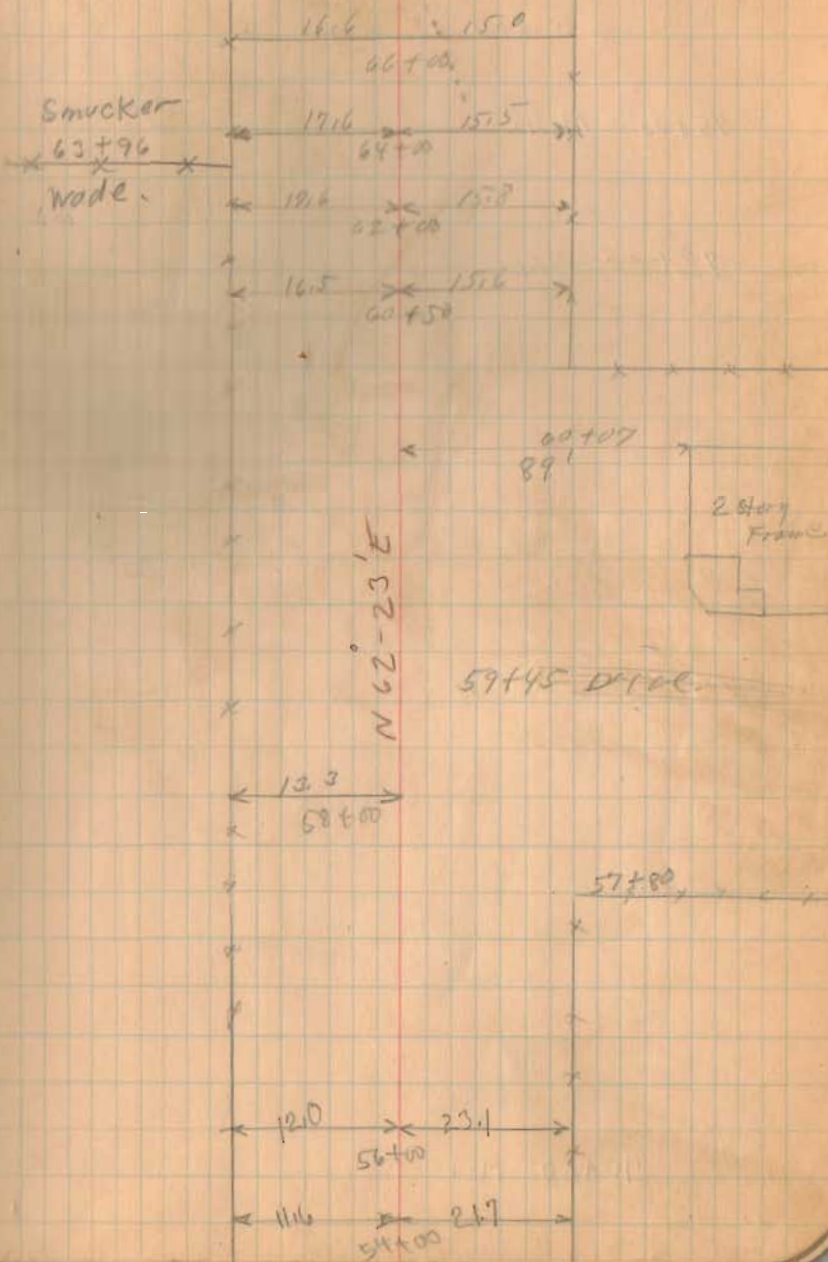

C.H. 400


75+00 Mon.

72+00 Mon.

6467
INDEXED ON MAP

70+00 Mon.

19

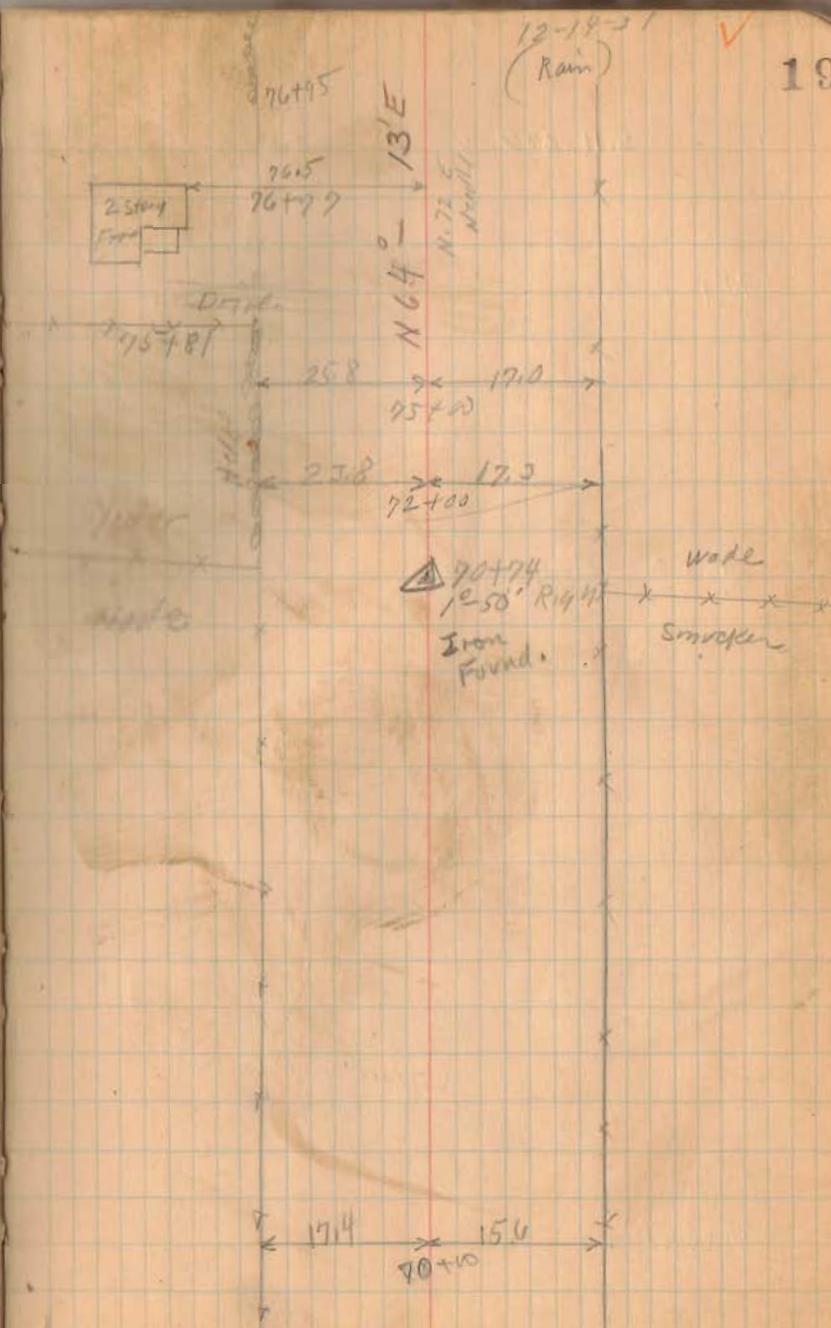

5.11.617

90+00 Mon.

85+00 Mon.

INDEXED ON MAP


80+00 Mon.

12-11-31

20

Davis


Yoder

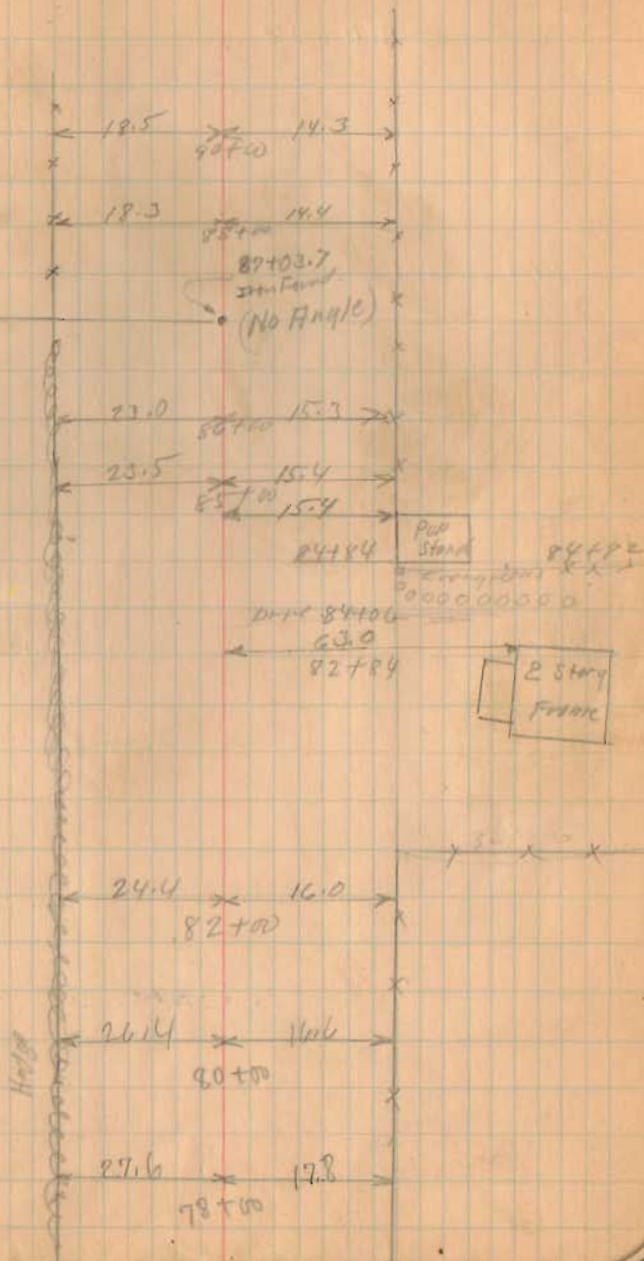

S. H. 607

97+00 Mon.

1467
INDEXED ON MAP

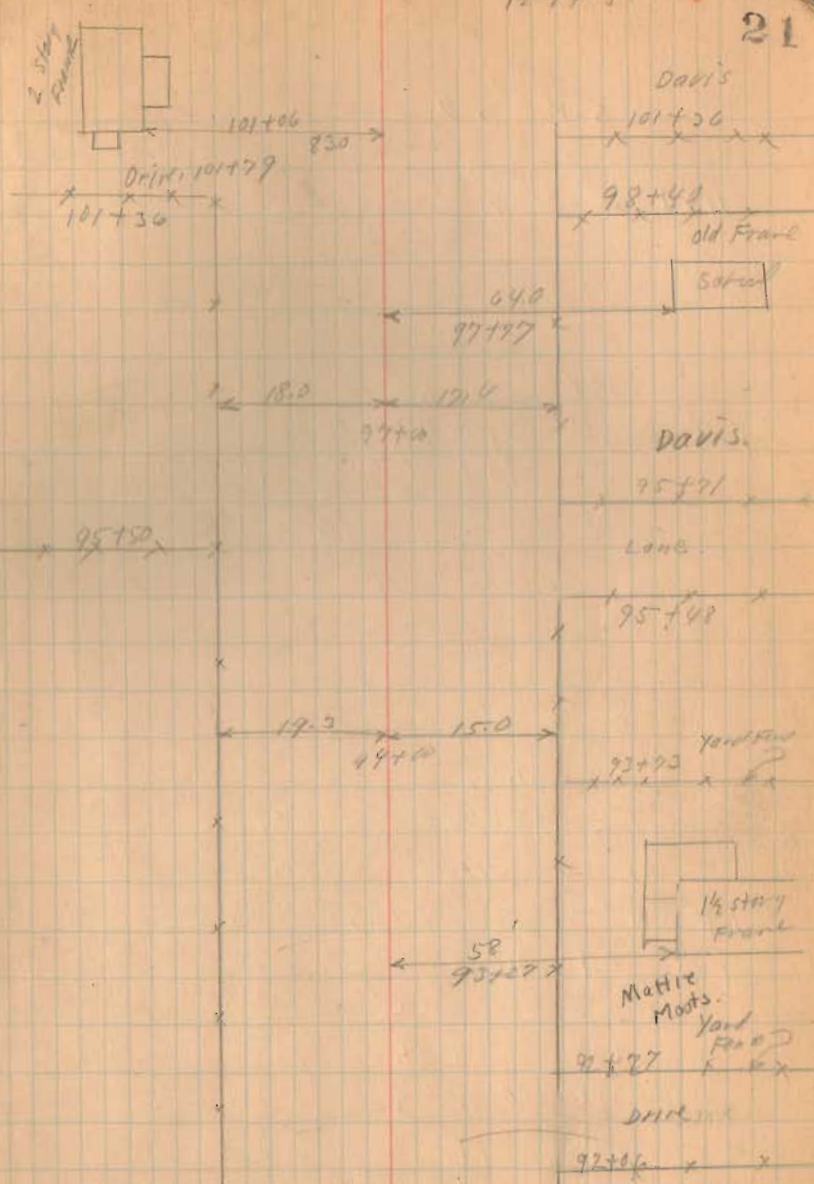

S.H. 607

113+00 Mon.


108+09¹³ (P.T.) Mon.

101+54²⁵ (P.C.) Mon.

1467
INDEXED ON MAP

12-14-31

22

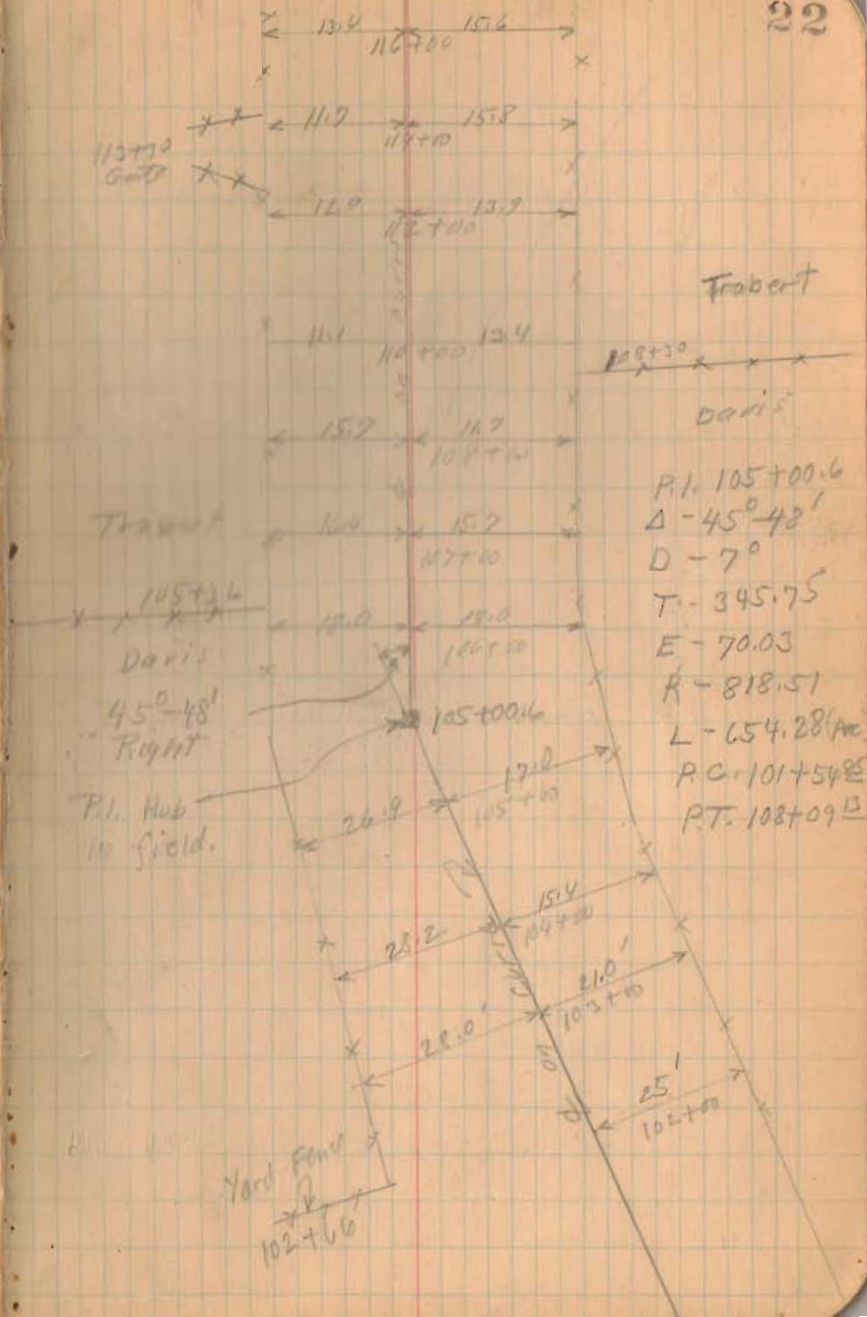


S.H. 607

125+05 Mon.
(90° from Back side)

120+00 Mon.

1467
INDEXED ON MAP

118 Mon.

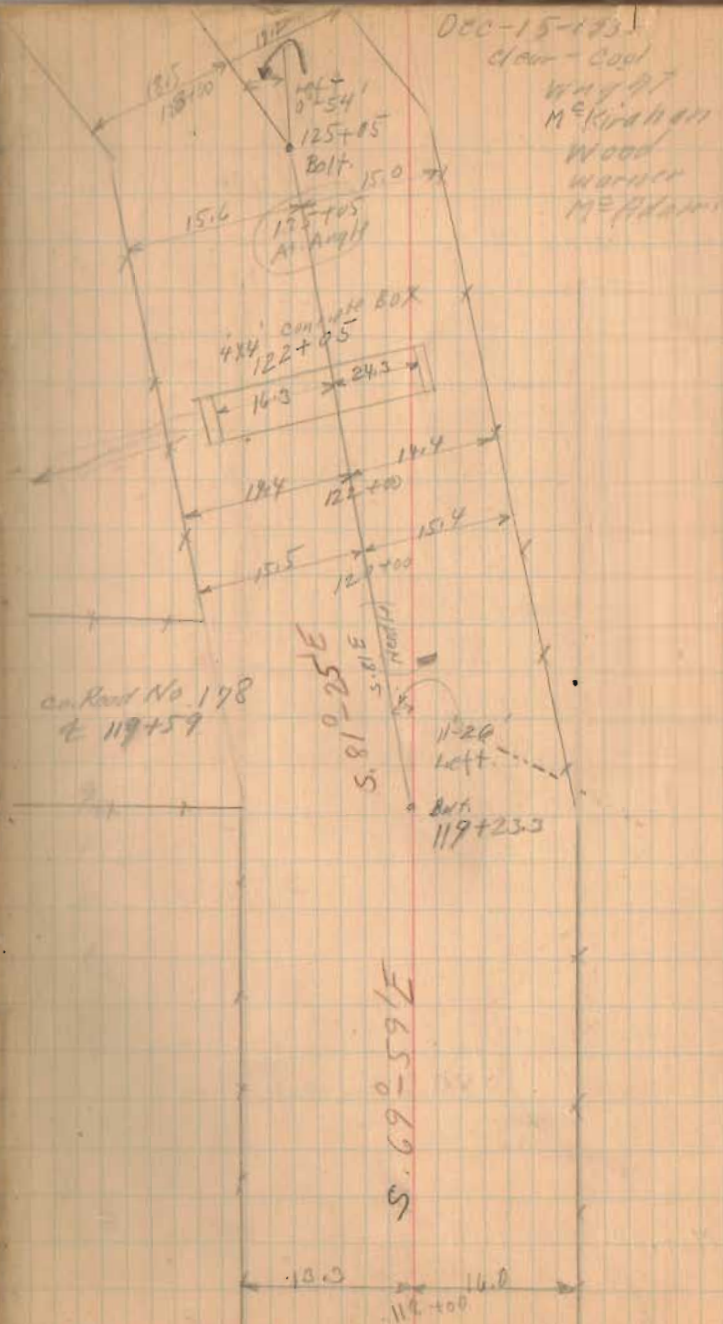

S.H. 607

145+00 Mon.

140+00 Mon.

134+00 Mon.

1467


INDEXED ON MAP

131+00 Mon. 131+00 Mon.

12-15-51

24

Angle Noded
140+00
To S.H. 607
+ Grid
for check.

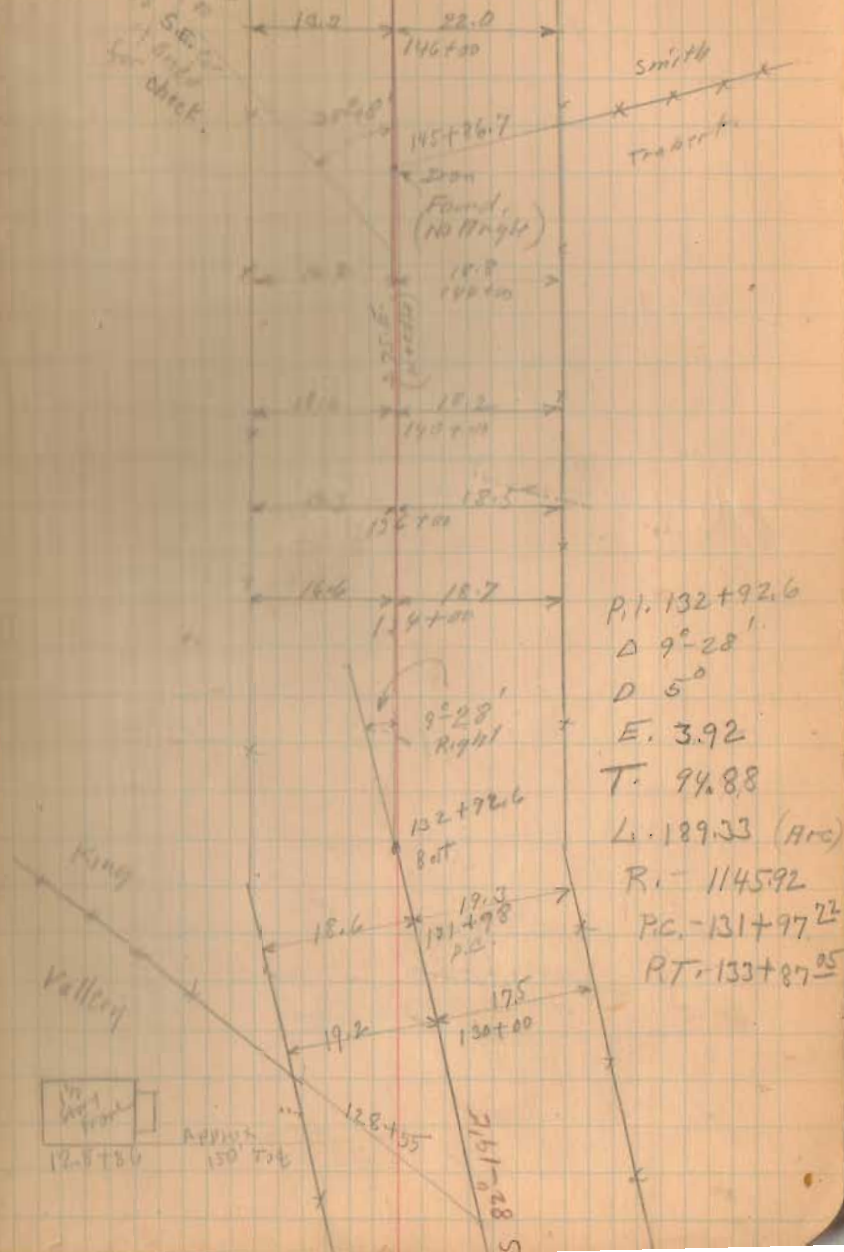


S.H. 607

Note:-

(Snake Bend Run as shown.
E of Road taken and angle
Noted. No monuments from
145+00 To 154+00)

1467

INDEXED ON MAP

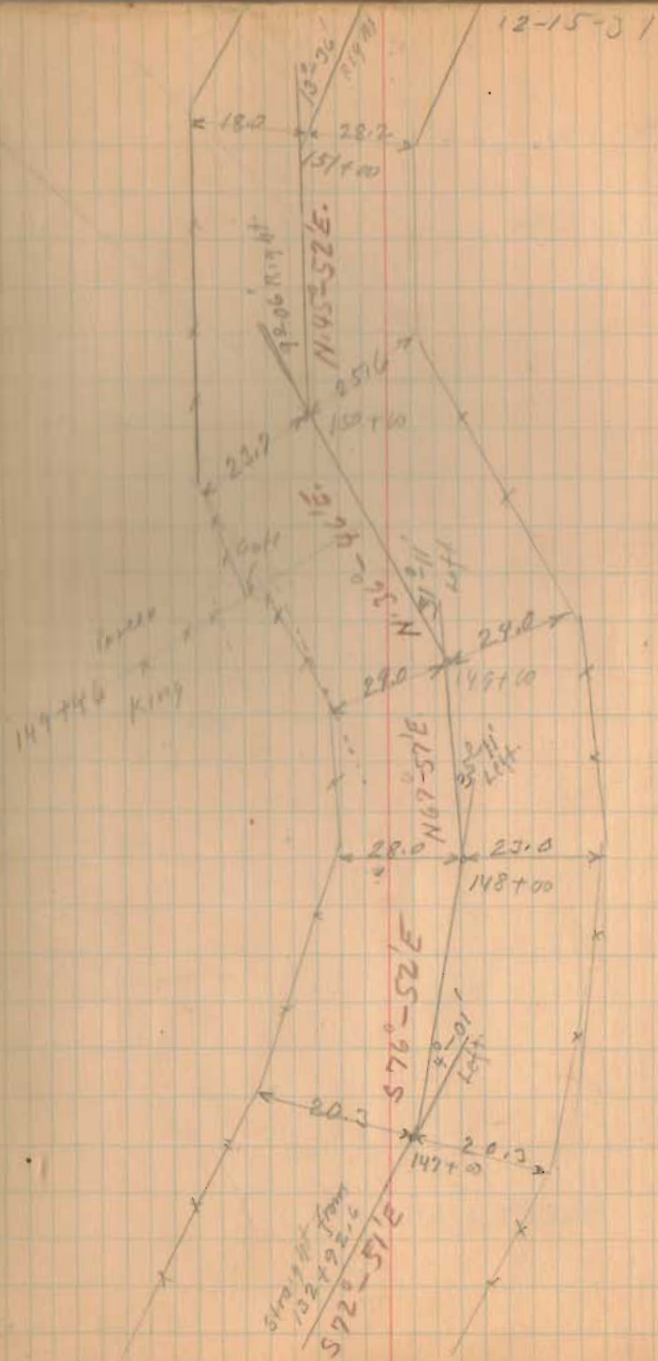


S. H. 607

154+00 Man.
(90° from Fore sight.)

(1467)
INDEXED ON MAP

26

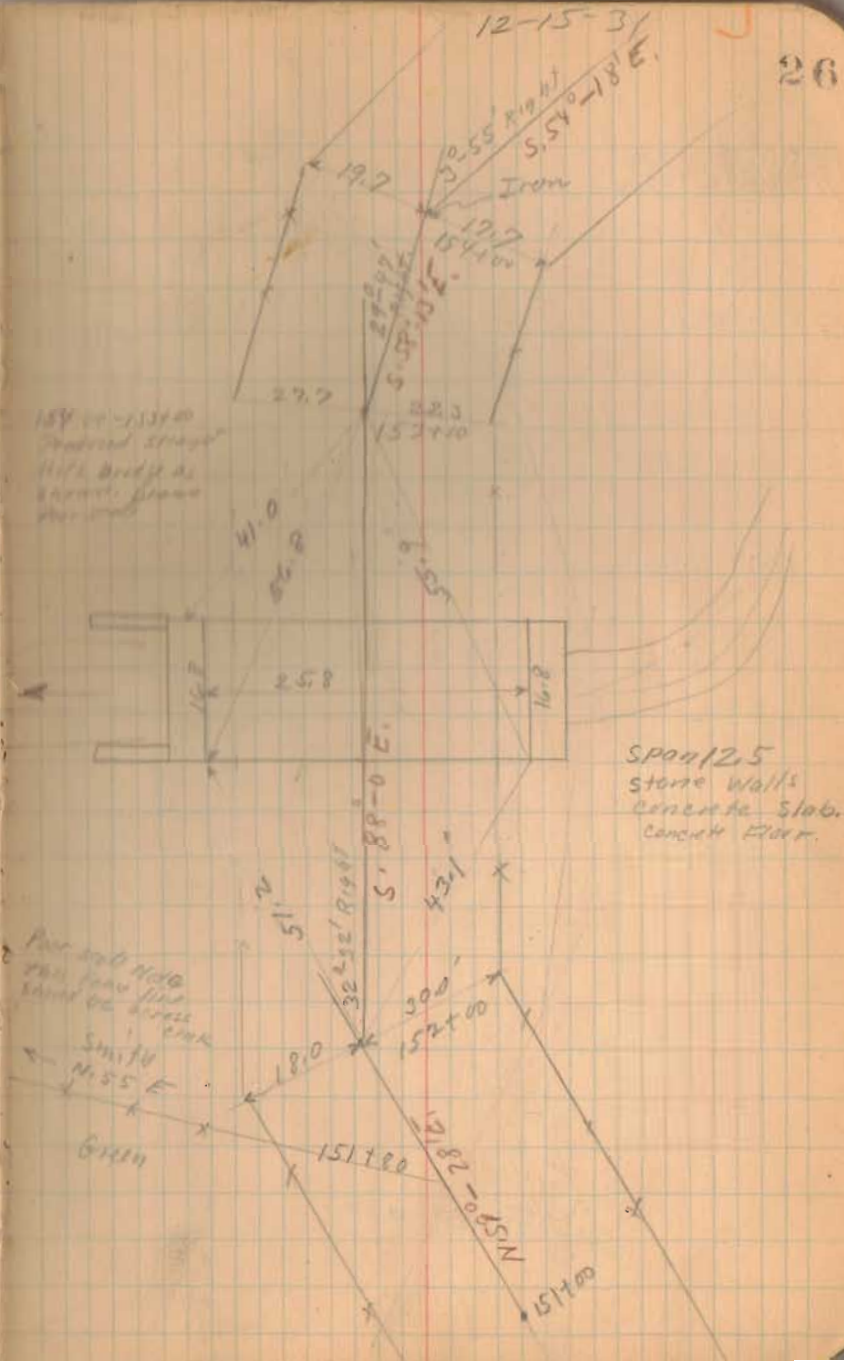


173+00 Mon. S.H. 607
 169+00 Mon.
 166+00 Mon.

161+00 Mon.

158+00 Mon.

(1467)
 INDEXED ON MAP

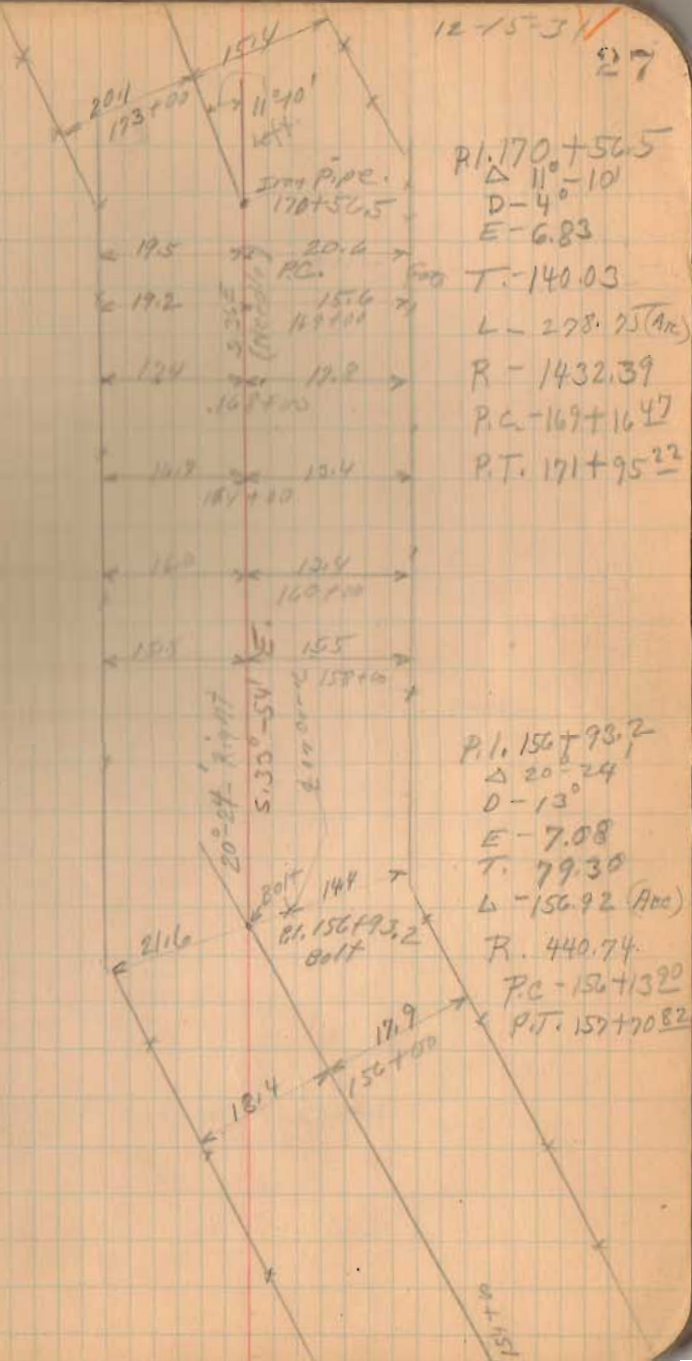

S.H. 607

211+00 Mon

210+00 Mon

206+00 Mon

202+00 Mon

197+00 Mon


194+00 Mon

1467

INDEXED ON MAP

12-14-31

30

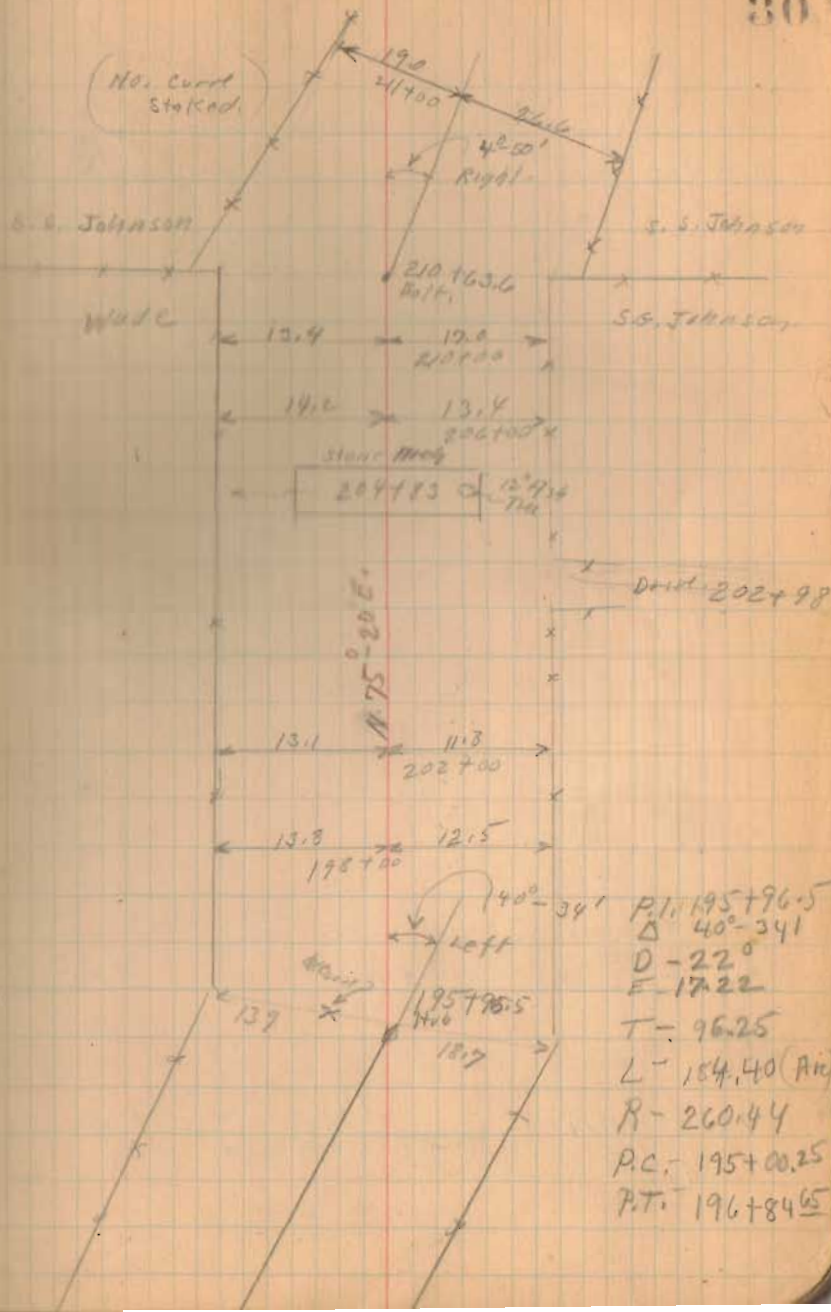

S.H. 607

245+00 Mon.

240+00 Mon.

234+00 Mon.

229+00 Mon.

1467
INDEXED ON MAP

Dec-17-1931

Clear

32

P.L. 243+56.5

$\Delta - 30^{\circ} 36'$

T = 104.50

E = 14.04

L = 204.00 (Arc)

D = 15°

R = 381.97

P.C. 242+52

P.T. 244+90

Thompson

Thompson


Thompson

Thompson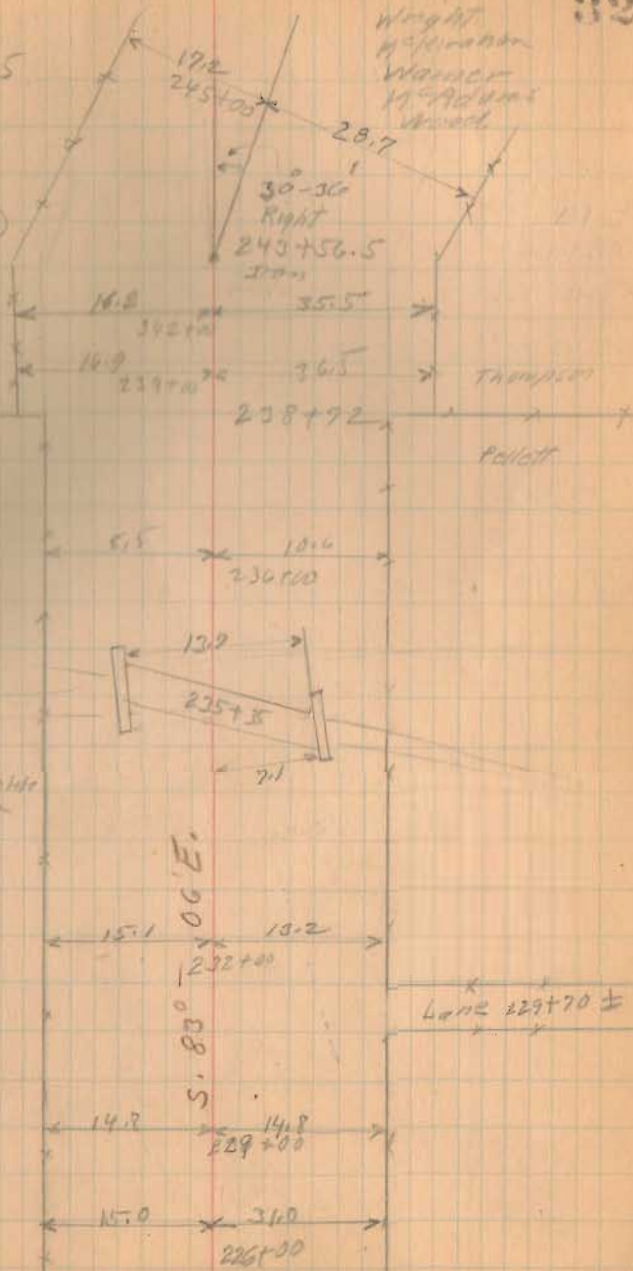

Stone Hbl.
Found with
concrete. Concrete
Slab 13' x 20'
on 2" steel

Line 229+70 ±

S.H. 607

256+00 Mon.

254+50 Mon.


253+00 Mon.

1467
INDEXED ON MAP

250+00 Mon.

12-17-31

33

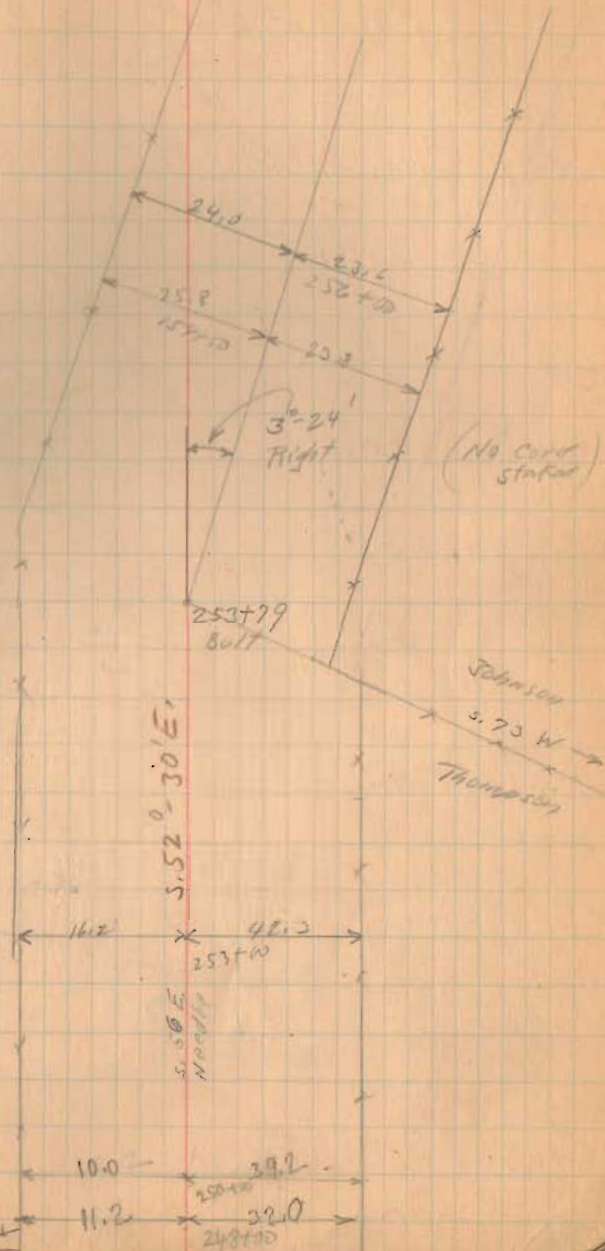

Out 246+95

S.H. 607

291700 Mon

286700 Mon

281700 Mon

276700 Mon


271700 Mon

267700 Mon


1467
INDEXED ON MAP

12-17-31

35

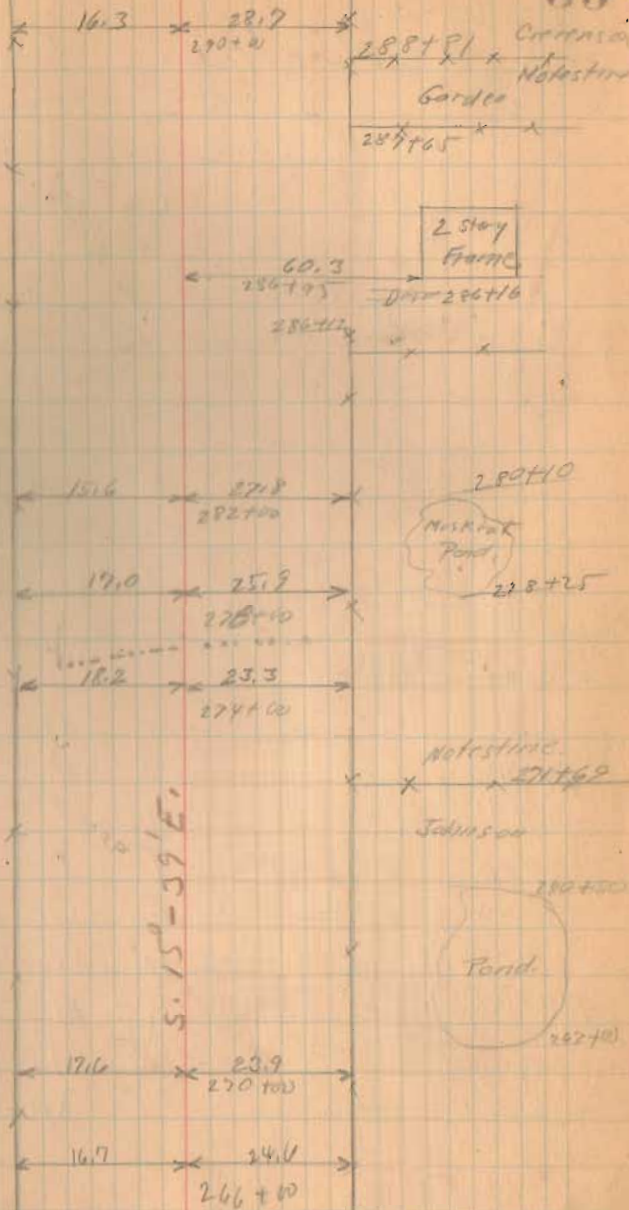

S.H. 607

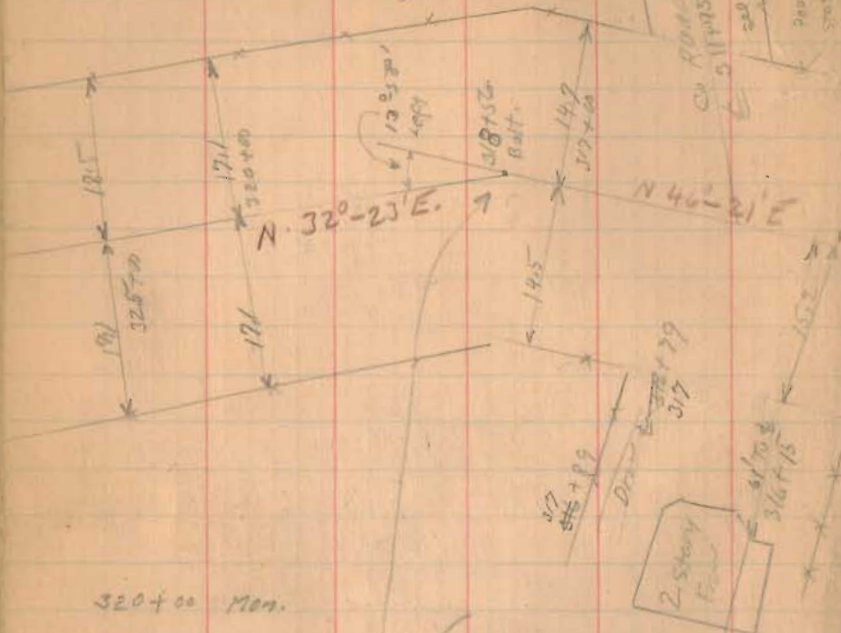

- 320+00 Mon.
- 317+00 Mon.
- 313+00 Mon.
- 309+00 Mon.
- 302+00 Mon.
- 296+00 Mon.

P.I. 318+56
 Δ $109^{\circ}58'$
 $D = 7^{\circ}$
 $T = 100.03$
 $E = 6.10$
 $L = 199.52$ (Hic)
 $R = 818.51$
 P.C. 317+55⁹⁷
 P.T. 319+55⁴⁹


(1467)
INDEXED ON MAP

Dec-18-1931 ✓
36



Zone Twp.
Monroe Twp.

Union Church
 N. E. Corner
 298+57
 Circumference

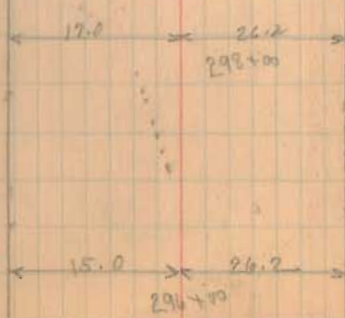

S.H. 607

345+00 Mon.

342+00 Mon.

339+00 Mon.

334+00 Mon.

333+00 Mon.


330+00 Mon.

225+00 Mon.

1867
INDEXED ON MAP

12-18-31

37

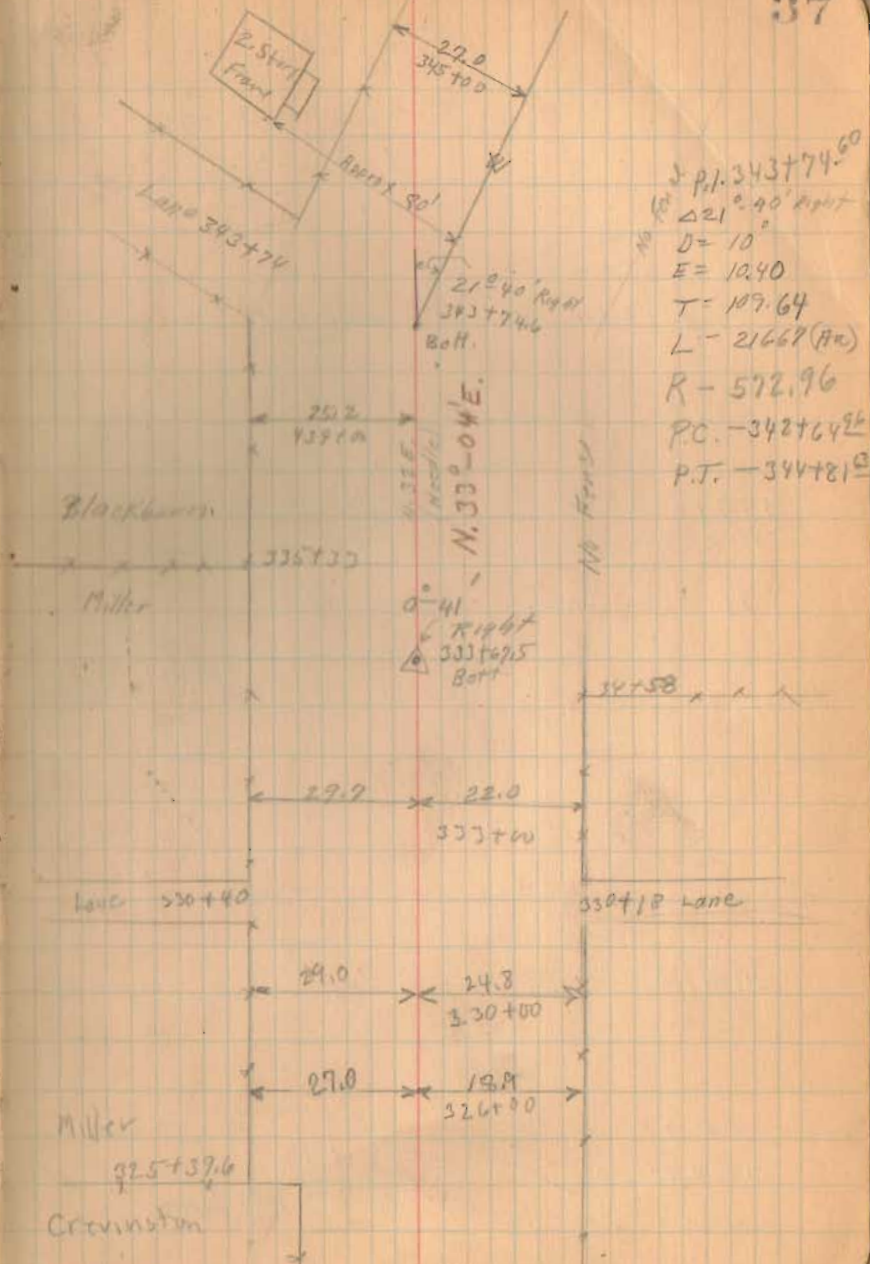

S.H. 609

407+00 Man.

402+00 Man.

397+00 Man.

391+82.8 Man. ($\frac{1}{2}$ of Angle)
P.L. line.

387+00 Man.

382+00 Man.

INDEXED ON MAP
1467

378+42.3 (90° from backsight)

374+00 Man.


Dec. 19-1931

Fog - Yrs.

Cold - No.

39

Wright
McGowan
Warner
McAdams
Wood

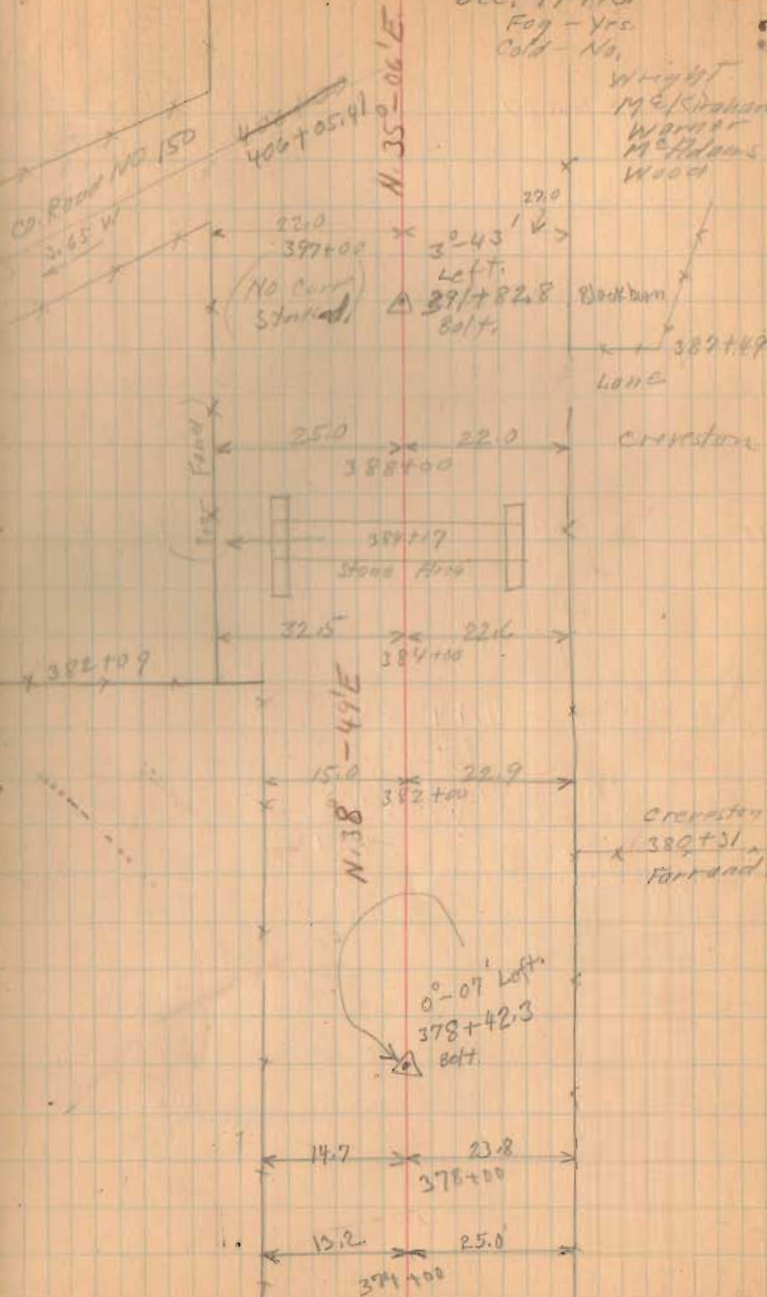

S.H. 607

422+00 Mon.



423+00 Mon.

421+00 Mon.

415+00 Mon.

1467
INDEXED ON MAP

40

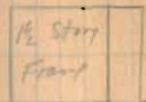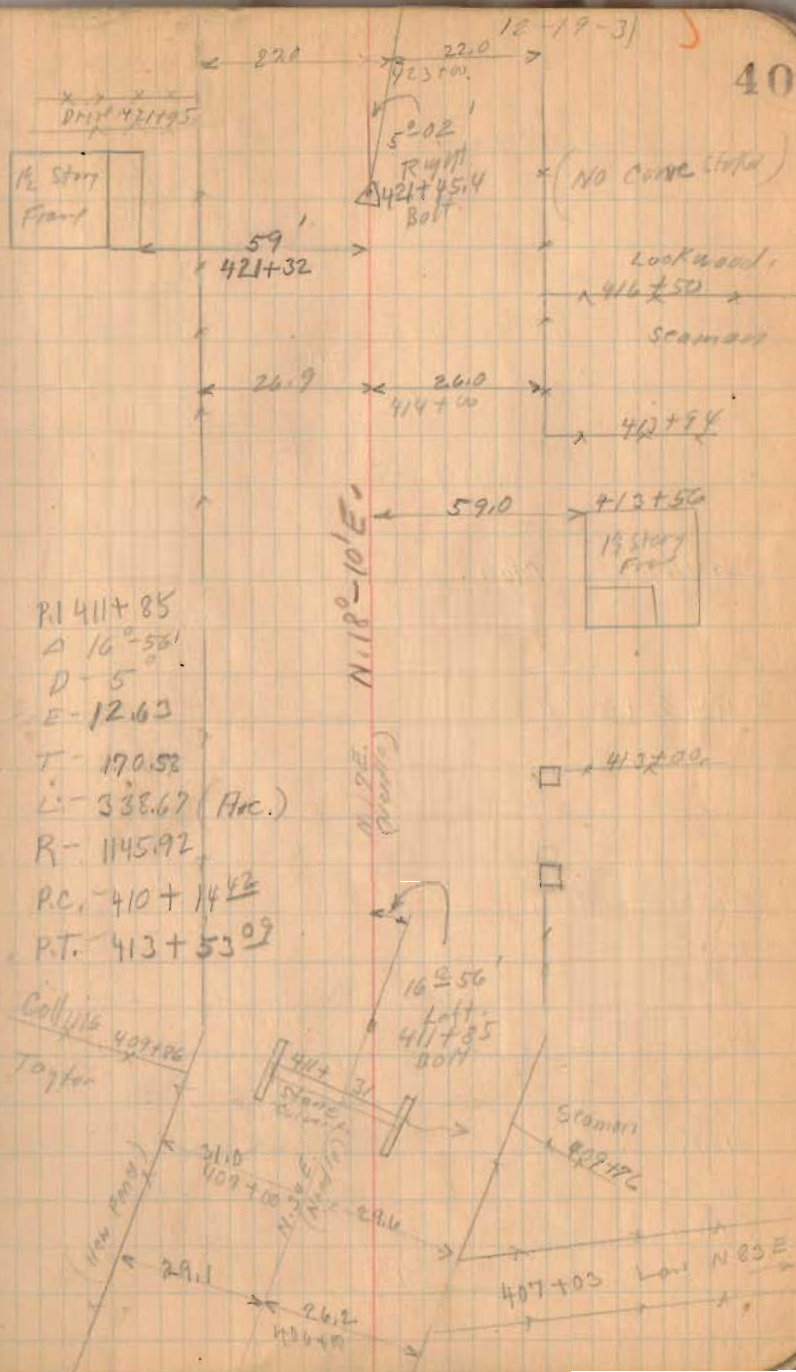

(NO CURVE STATE)

Lookwood
416+50
Stamers

402+54



413+00

- R1 411+85
- Δ 16° 56'
- D - 5
- E - 12.63
- T - 170.52
- L - 338.67 (Arc.)
- R - 1145.92
- P.C. 410+14.42
- P.T. 413+53.09

Collins Taylor



Stamers
409+06

407+03 L. N 83 E

S.H. 607

446+50 Mon.

443+00 Mon.

438+00 Mon.

434+00 Mon.

432+00 Mon.

1467
INDEXED ON MAP

Dec. 21-1931

Cloudy - Some
Cold - No.

41

P.L. 444+93

Δ - 43° 20'

D - 22°

E - 19.80

T - 103.46

L - 196.87 (710)

R - 260.44

P.C. 443+89.54


P.T. 445+86.51

Vassar

444+35

Devitt

442+32

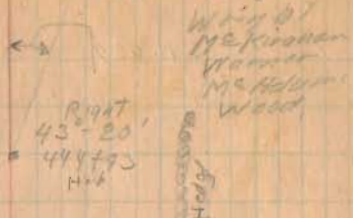

Blockburn

(S.R. No. 559)

Co. Road No. 157

442+37

(See Book 590 Page 39)

Collins

N. 14° - 42' E.

22.6
438+00

19.5

P.L. 436+02

Δ - 8° 30'

D - 3°

T - 144.92

E - 5.27

L - 283.33 (A70)

R - 1909.86

P.C. 434+60.08

P.T. 437+43.41

Collins

Devitt
431+58

Collins

20.6
434+00

437+02
Bolt

21.4

65.4
435+02

27.6
428+00

21.2

N. 23° - 12' E.

Lockwood 729+22

1/2 acre

432+00

432+50

S.M. 609

476+00 Mon.

473+00 Mon.

466+00 Mon.

460+00 Mon.

456+00 Mon.

451+00 Mon.

1467
INDEXED ON MAP

42

P.L. 774+325
D 12° 36'
D-C
T- 105.42
E- 5.80
L- 210.00 (Ave)
R- 954.93
P.C. 473+27.08
P.T. 475+37.08


Pony Macra Truss

Buller Ditch No. 510

Gibson

Vassar

High
Road
No. 157
E 461+15

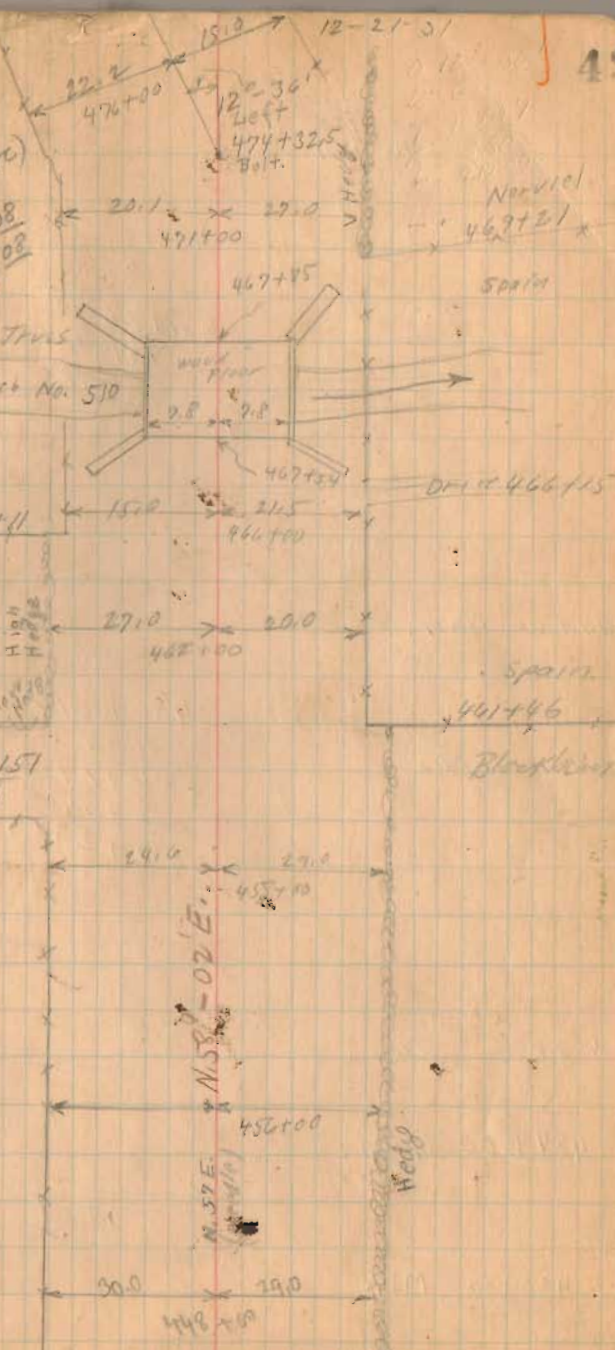

S.H. 607

499+00 Mon.

472+00 Mon

488+00 Mon

484+00 Mon

480+00 Mon

1467
INDEXED ON MAP

12-21-31

43

P.I. 498+54
 Δ - 29° 52'
 D - 20'
 E - 10.06
 T - 76.58
 L - 149.67 (Arc)
 R - 286.48
 P.C. 497+77.42
 P.T. 499+27.09

Dosny

Gibson

498+10

N. 25° - 16' E.

292.50'
Left.
498+54
Balt.

E 498+00
Co. Road No 158
5.5' E.

N. 55° - 12' E.

924'
Right

486+01.7
Balt.

P.I. 486+01.7
 Δ - 9° 46'
 D - 4'
 E - 5.22
 T - 122.38
 L - 244.17 (Arc)
 R - 1432.39
 P.C. 484+79.22
 P.T. 487+23.12

N. 45° - 26' E.

481+24

2 1/2 mi
Fishing

480+52
Approx 100

482+56
Dmrc

Very Poor Flood

17.1

490+80

499+10

S.H. 607

511+00 Man.

508+00 Man.

504+00 Man.

500+00 Man.

1467
INDEXED ON MAP

PI. 512+72.7
Δ - 28° 16'
D - 15'
E - 11.92
T - 96.18
L - 188.44 (Arc.)
R - 381.97
PC 511+97.52
PI. 513+85.96

Dec-22-1931

Rain A.M.

Wright


M. Expiration

Warren

M. Phillips

Wood.

Water of St. 114+68

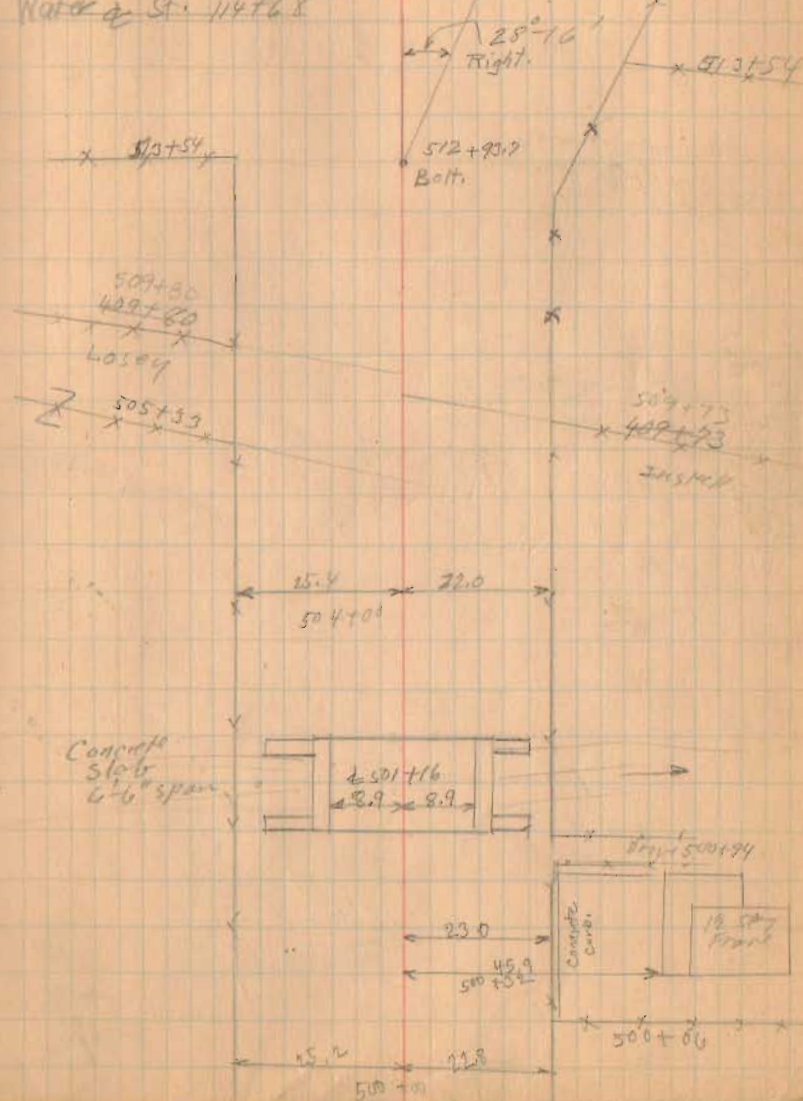


Sitt. 607

12-22-31

45

518782

Ca. Road 153
Columbus St.

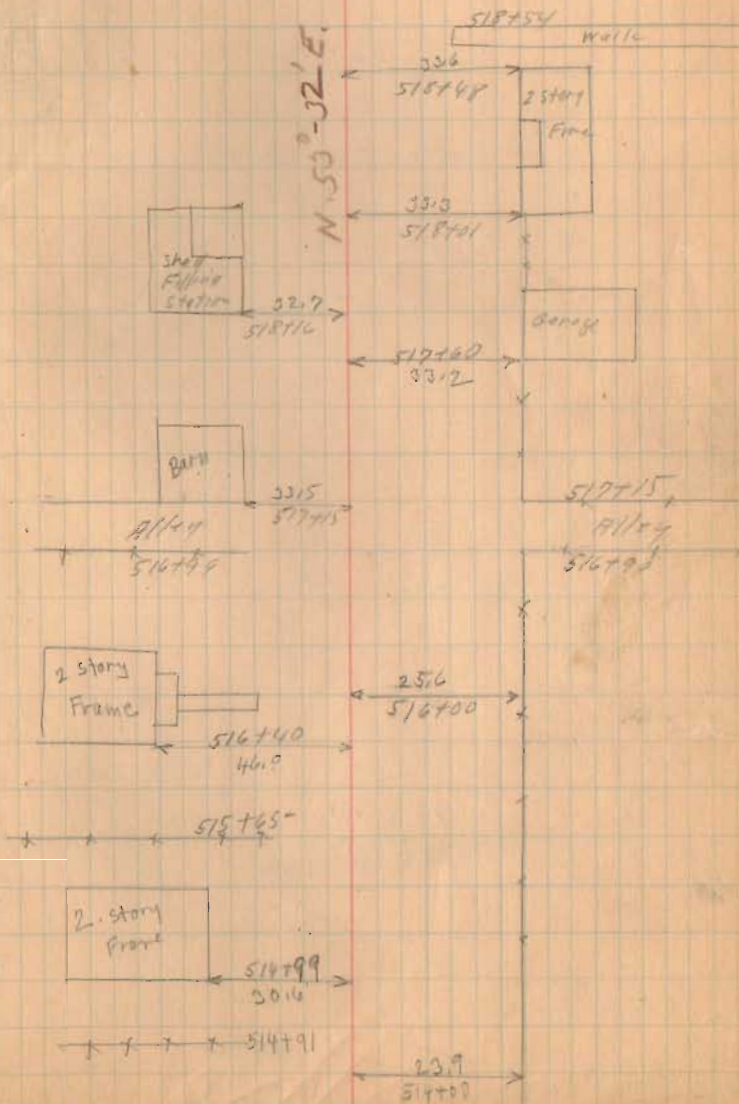

1467
INDEXED ON MAP

S.H. 607


BOLT Fd. (12/5/70)

Sta. 522+48

New WITNESSES

DEG.


1467
INDEXED ON MAP

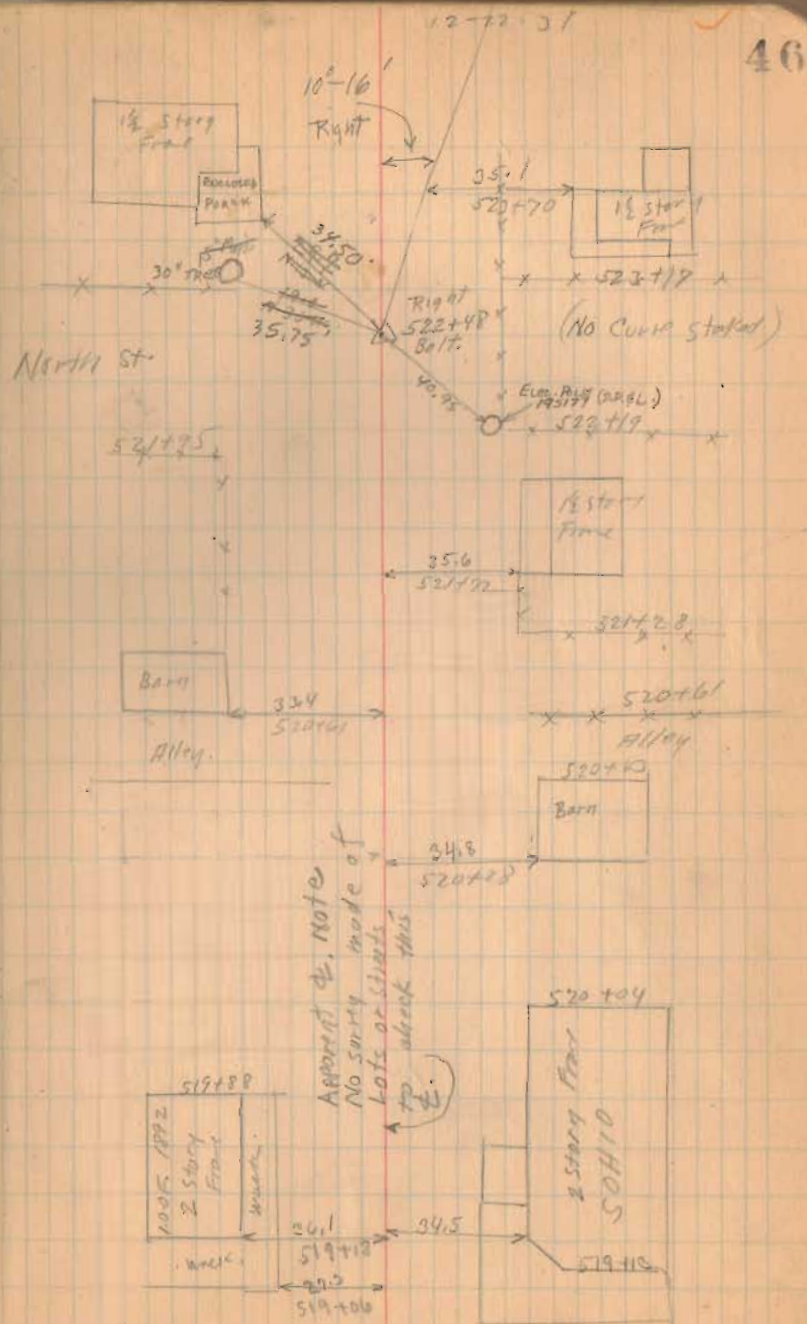

S.H. 607,

526+00 Man.

1467
INDEXED ON MAP

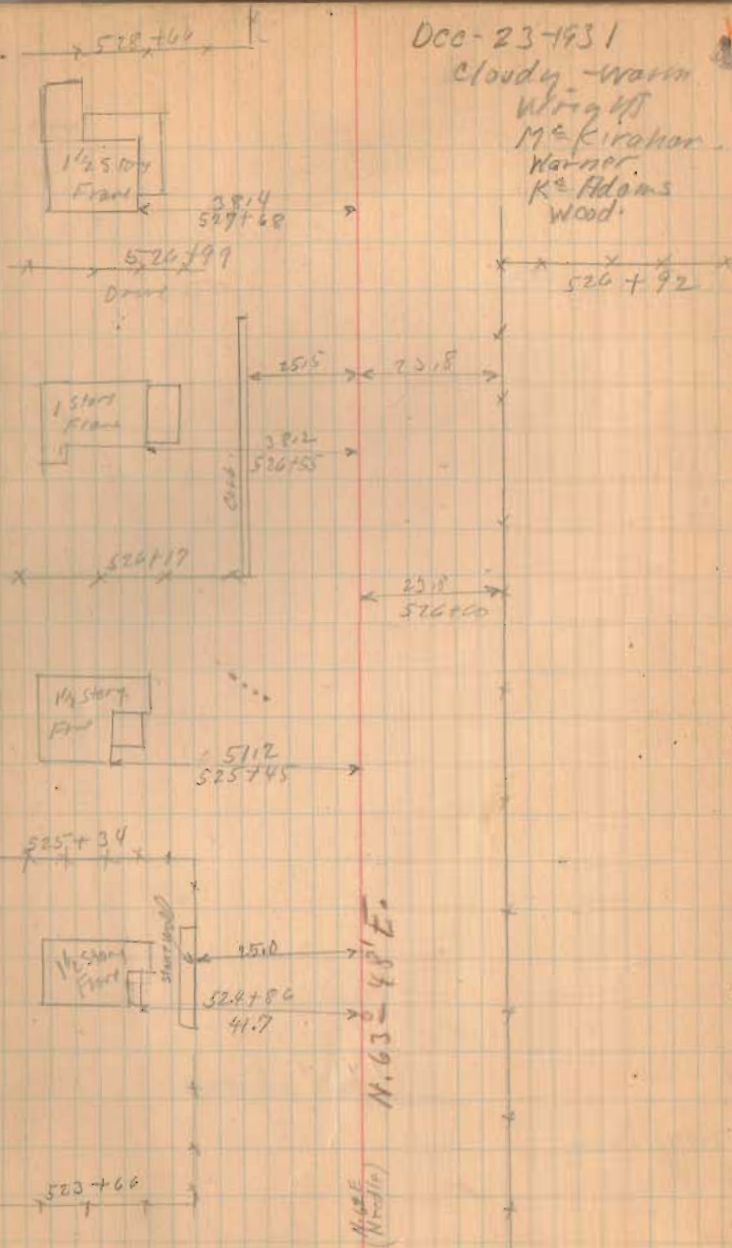

SH607

535+00 Mon.

(1467)
INDEXED ON MAP

529+00 Mon.

12-23-31

534114

1/2 story
Finl

46.8
535+66

Richard's

532+59

531132

1/2 story
Finl

47.6
530+93

concrete Wall
530+46

stone Arch

530+18

24.4
530+00

530+00

24.6

22.0

529+00

S.H. 607

572+00

569+00 Man.

561+00 Man.

557+00 Man.

554+00 Man.




1467
INDEXED ON MAP

12-23-31

50



PL 570+68.5
 Δ - 33° 0'
 D - 20'
 E - 12.30
 T - 84.86
 (Arc) L - 165.00
 R - 286.48
 $P.C.$ - 569+83.49
 $P.T.$ - 571+48.69

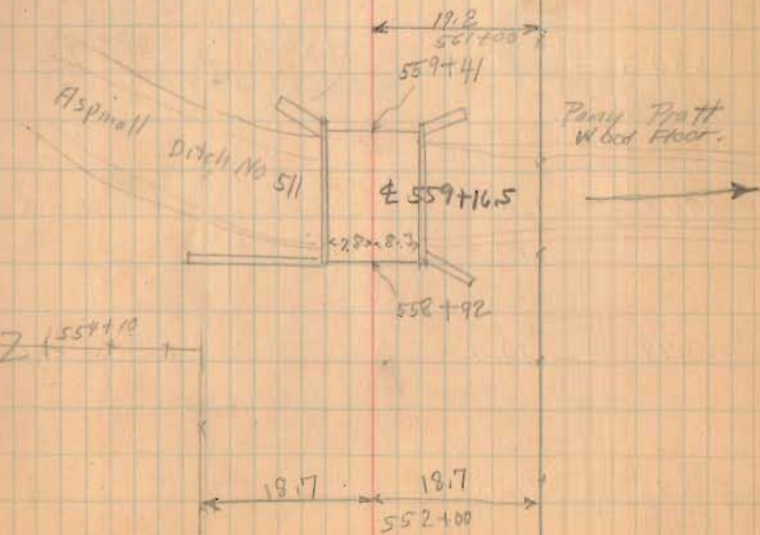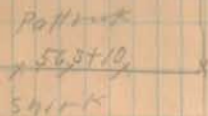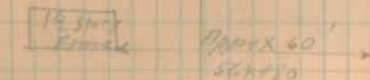

S.H. 607

Total Length 58,062.5 Feet
" " 10.9968 Miles
17½ feet less than 11 Miles.

580+00

(1467)
INDEXED ON MAP

576+00 Mon.

574+00 Mon.

12-20-31

51

