



Road 146

44+70

39+00

33+09

1535  
INDEXED ON MAP

Iron  
44+70  
1°-0' Right



Samuel Benton

X 44+27

The Donald Realty Co

Lane 35+24 ±

N. 85° E.  
N. 85° E.

15' Rear

Q 44.65  
N 26 E.

Q 29.40  
Wild cherry  
N 62 W

Iron  
33+09  
0°-45' left

X 31+30 X

172-39

33

Samuel Benton

X 44+93  
Ben Stanley





Road, 146 (Detail of Trp line)  
(NOT TO SCALE)

$$\begin{array}{r} .009264117 \\ 7243 \overline{) 671.00} \\ \underline{65187} \\ 1913 \end{array}$$


$$0^\circ - 32' -$$

$$sec = 1.00$$

2005.6 - 18.58  
 3968.1 - 36.76  
 5104 - 47.28  
 7243 - 67.10



1535  
 INDEXED ON MAP

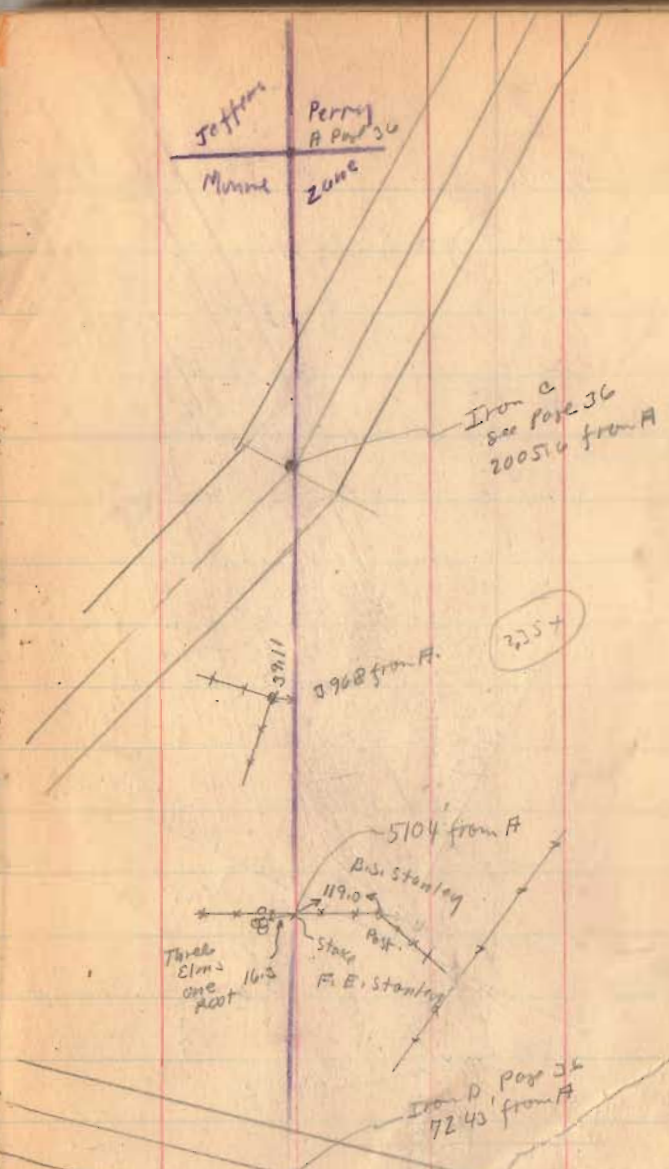



Road 146  
Detail Near sta. 56+95  
(see page 33)

Letters for this page only


- A. Iron  $\odot$  Road at angle sta. 56+95  
B. Top Line Monument  
C. Point in Road. sta 56+60.73  
D. Monument  
E. stake  
F. Top Line Monument 25' from  $\odot$  sta. 57+76  
G. Point in Road. sta 57+76

H.  $\odot$  Road at Top line sta. 56+99.50

$$HC = (25)(\tan 55^\circ) = (25)(1.428) = 35.70$$

$$HB = (25)(\sec 35^\circ) = (25)(1.223) = 30.58$$

$$FH = 93.09$$

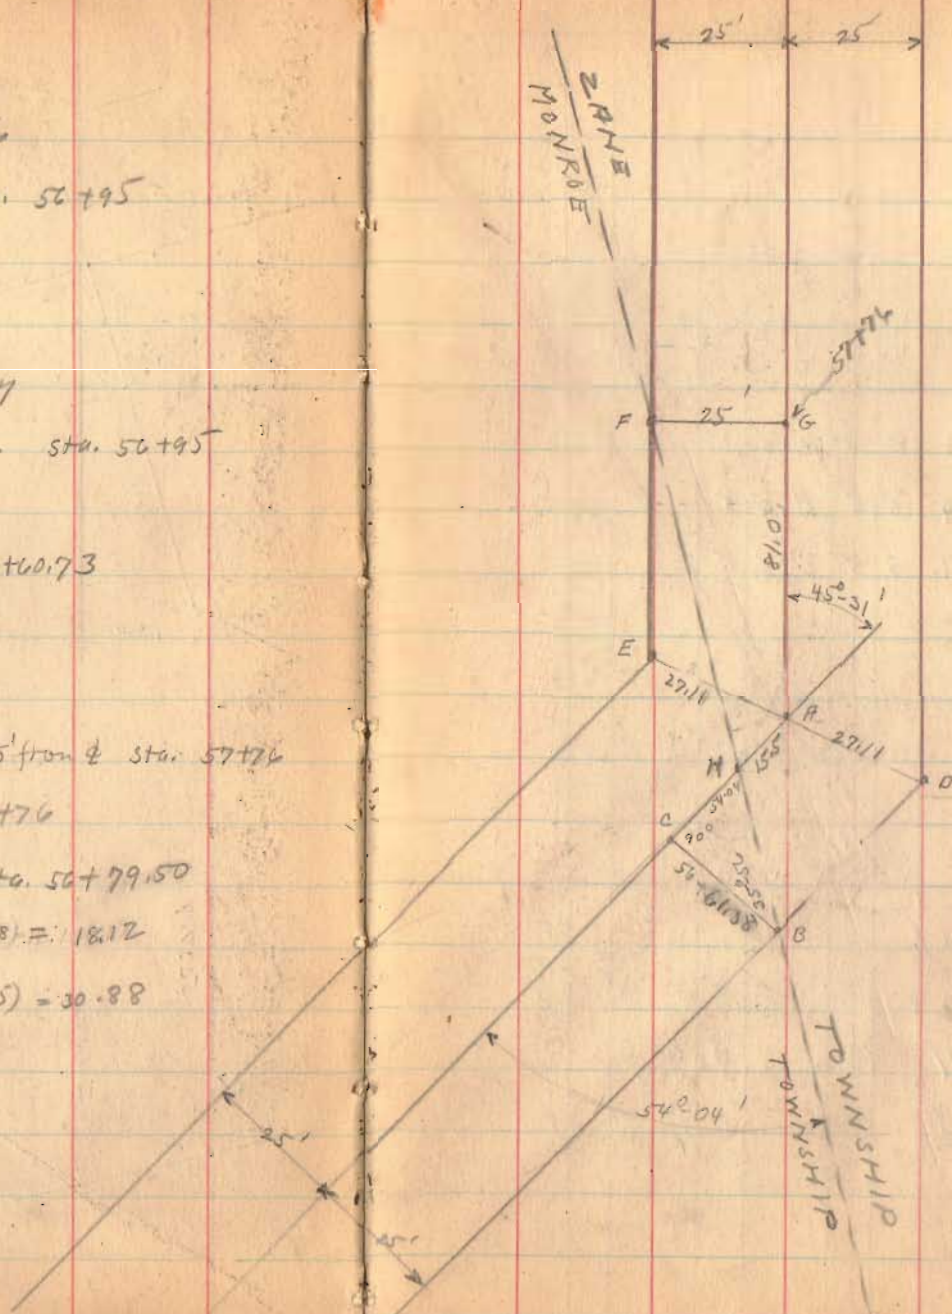

1535

INDEXED ON MAP