

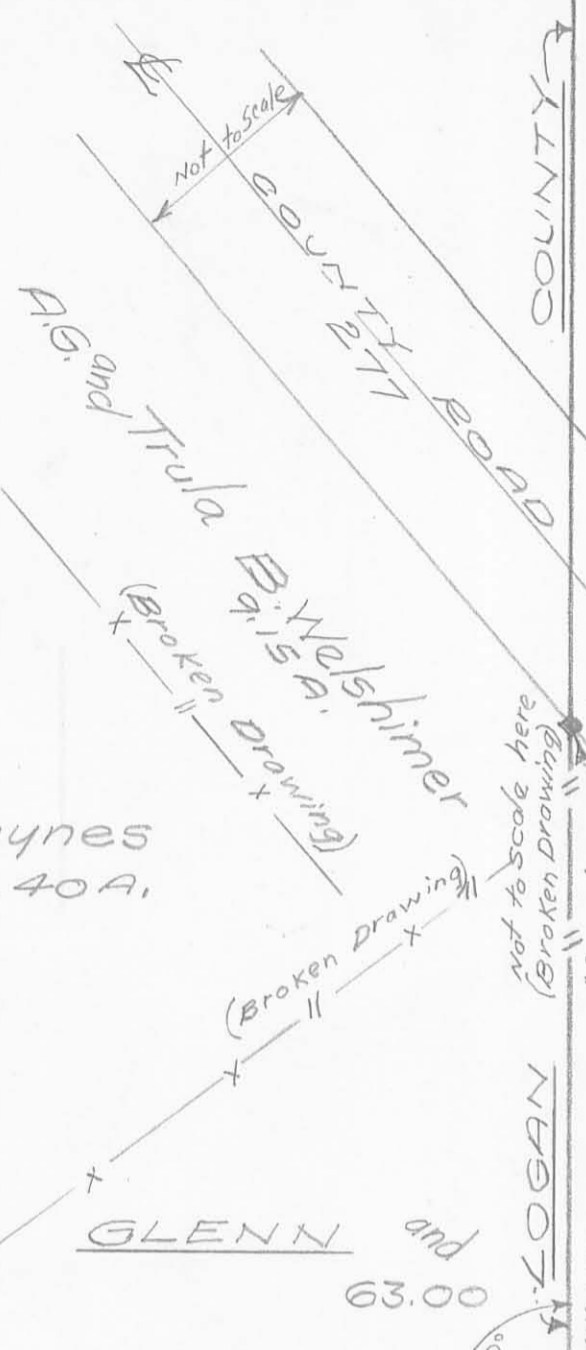


Wm. P. Haynes
137.40A.

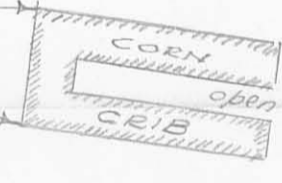

1" = 30'
(Note - Broken Drawings = 11)

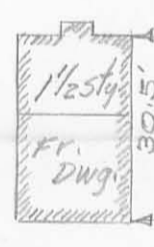

LOGAN COUNTY
ZANE TWP.

UNION COUNTY
ALLEN TWP.

Virginia Military

Survey # 3163


MAP SHOWING CONDITIONS
IN LOGAN COUNTY-
VICINITY OF C.H. 227

E.K. CORE-COUNTY ENGR.
LOGAN COUNTY.

(1997) 1P

Logan & Union County line Survey


FB 685

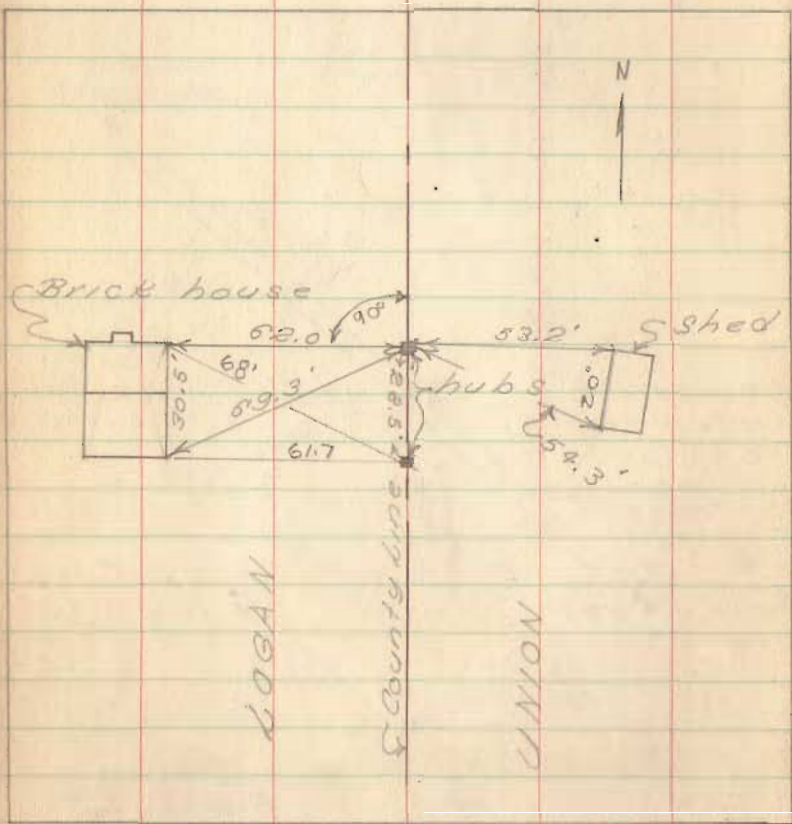

Party: M. Hand
N. Seysar
D. Suddon

March 2, 1949

8

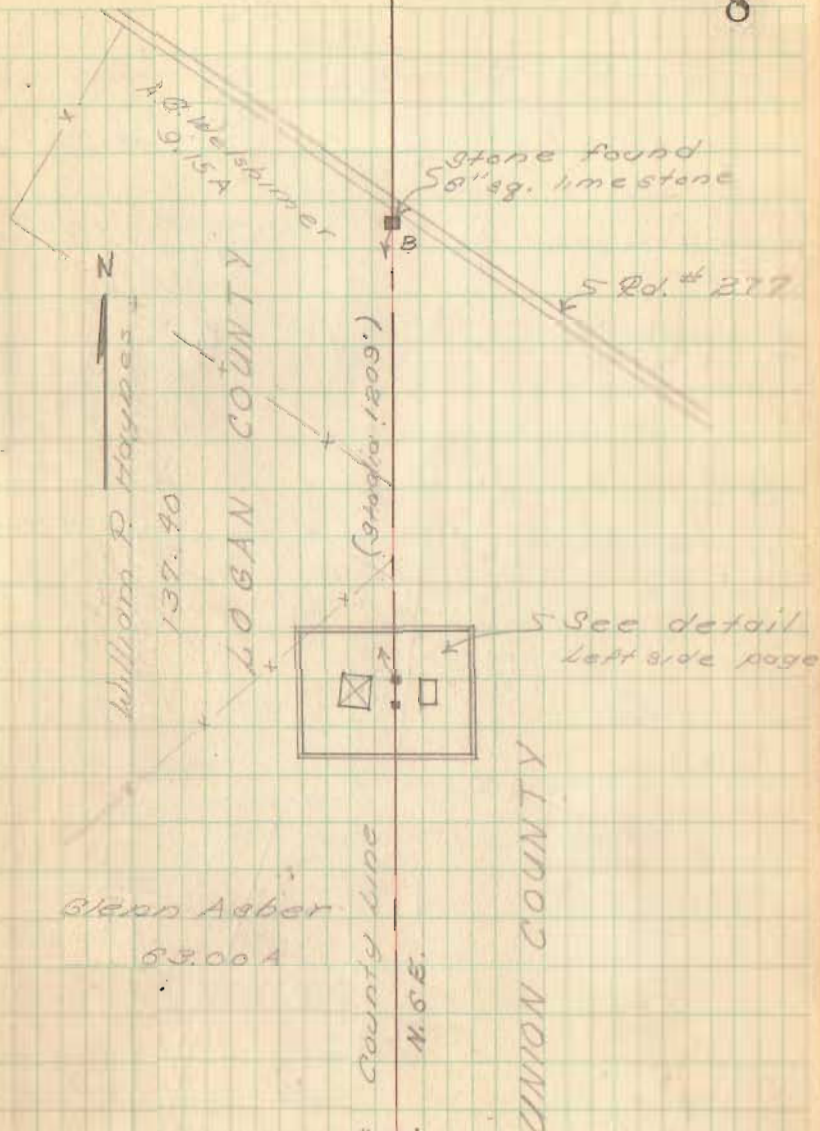

Note: - scaled drawing made of above - see SURVEY - 1997 INDEXED ON MAP