


Extension of Corporation line
of
Zanesfield

712
INDEXED ON MAP

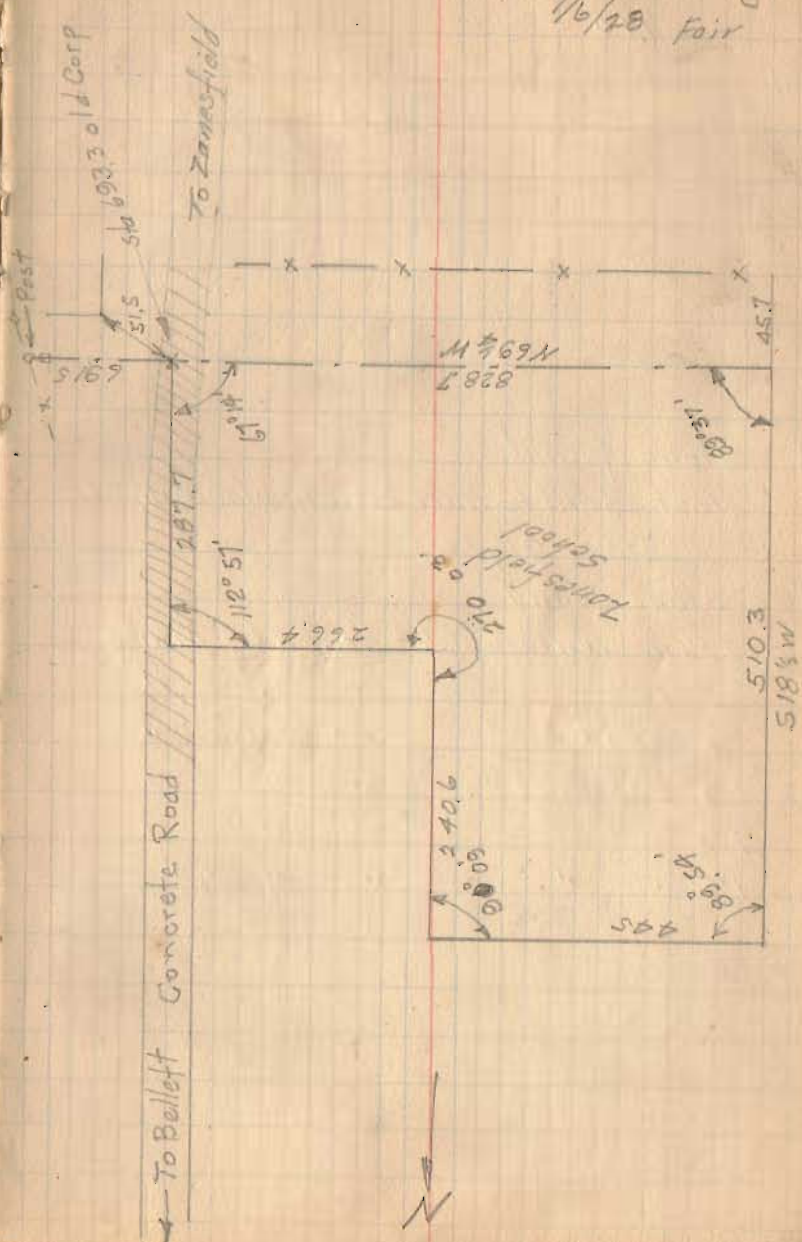

Ed Core
W A Montgomery
7/6/28 Fair