

Description of Property for
Edna C. Cushman to
Zanesfield Boy Scouts

Situated on Sandusky Street in Zanesfield, Jefferson Township, Logan County, Ohio and being part of Virginia Military Survey #3137 and more particularly described as follows:-

Beginning at an iron pin at the intersection of Water Street, Sandusky Street and Depot Road, thence S. 9° - 25' W 56.5 feet along the center of Depot Road to an iron spike, thence N 57° - 32' E 101.5 feet to a stake; thence, N 26° -02' W 111.1 feet to an iron spike in the center of Sandusky Street; thence with ^{the} center of said Sandusky Street S. 15° - 30' W 102.15 feet to the place of beginning, containing 0.14 of an acre.

This tract is taken from a 0.34 acre tract.

1989

10 -1


INDEXED ON MAP

Description of Property for
Boy Scouts to
Edna C. Cushman

Situated in Zanesfield, Jefferson Township, Logan County, Ohio
and being part of Virginia Military Survey #3137 and more particularly
described as follows:-

Begin at an iron pin at the intersection of Water Street, Sandusky
Street and Depot Road, thence S. $9^{\circ} - 25'$ W. 56.5 feet along the center
of said Depot Road to an iron spike, thence N. $57^{\circ} - 32'$ E. 101.5 to a
stake for a place of beginning of this description, thence continuing
N. $57^{\circ} - 32'$ E. 107.0 feet to a stake, thence S. $26^{\circ} - 02'$ E. 55.7 feet
to a post, thence S. $57^{\circ} - 32'$ W. 107.00 to a post; thence N. $26^{\circ} - 02'$ W.
55.7 feet to the beginning, containing 0.14 of an acre.

This tract is taken from a 1.13 acre tract.

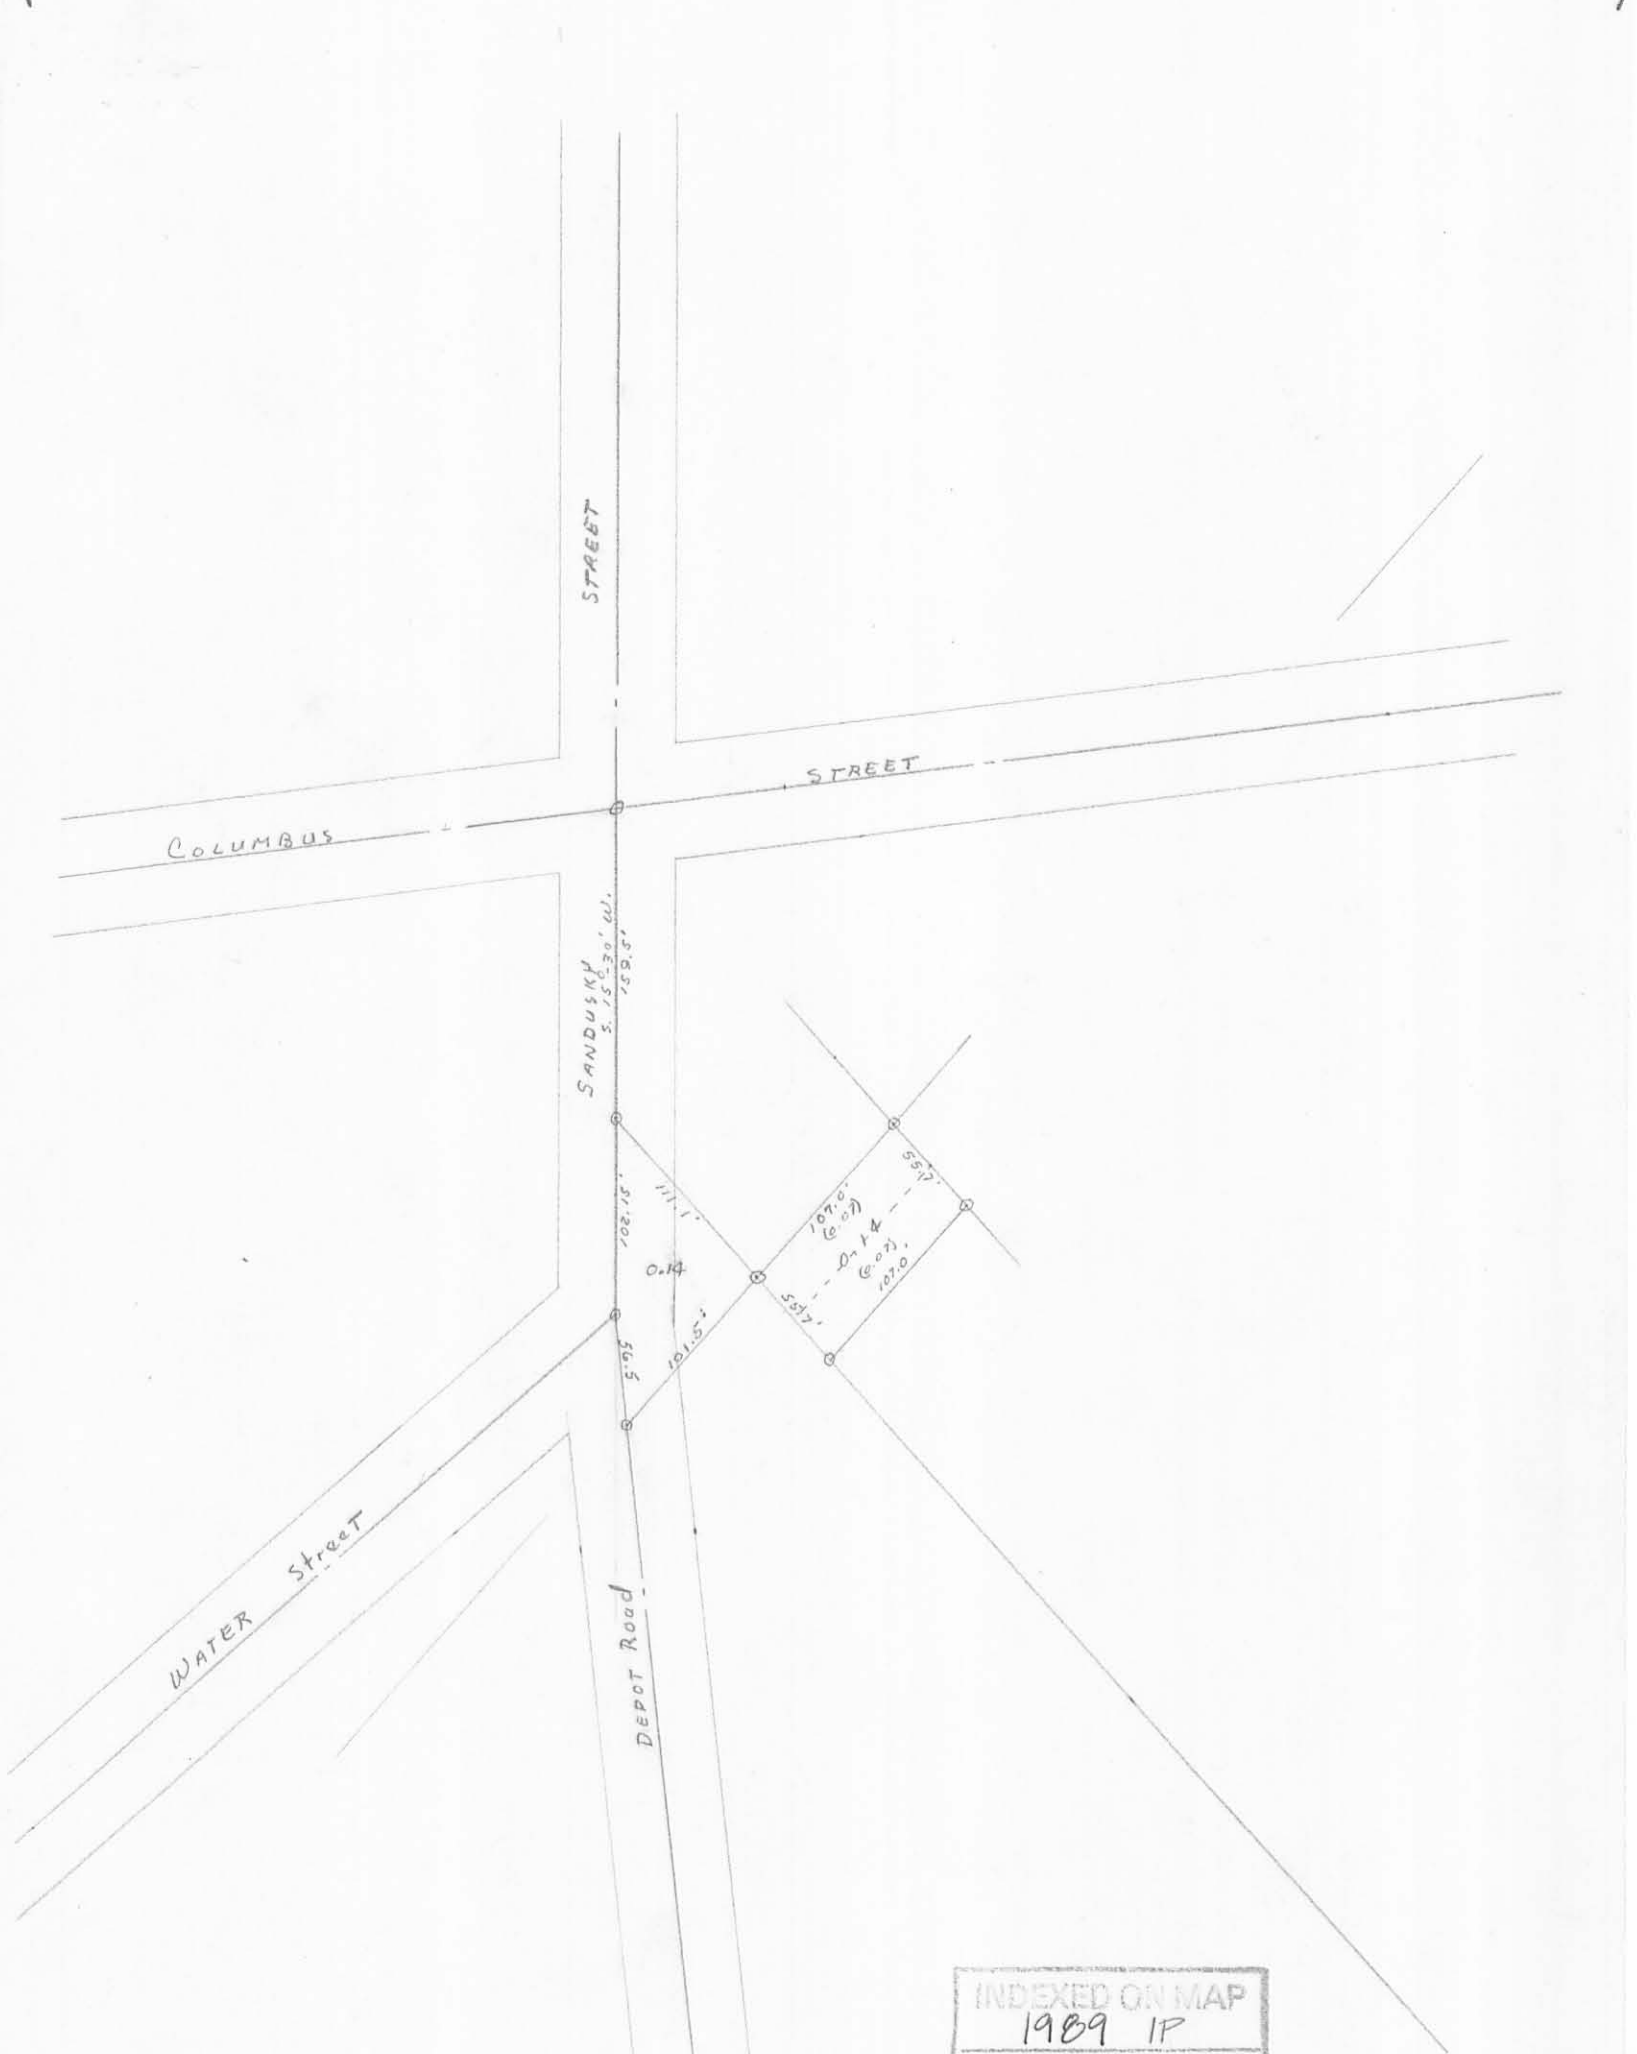


INDEXED ON MAP
1989 1P

Survey for exchange of
land between Edna C. Cushman
and Zanesfield Boy Scouts -
VMS 3197, Jefferson Twp, Zanesfield, Ohio

Party: - C. Kayser
G. Wilgus
O. Shirk

23 July 1947 73

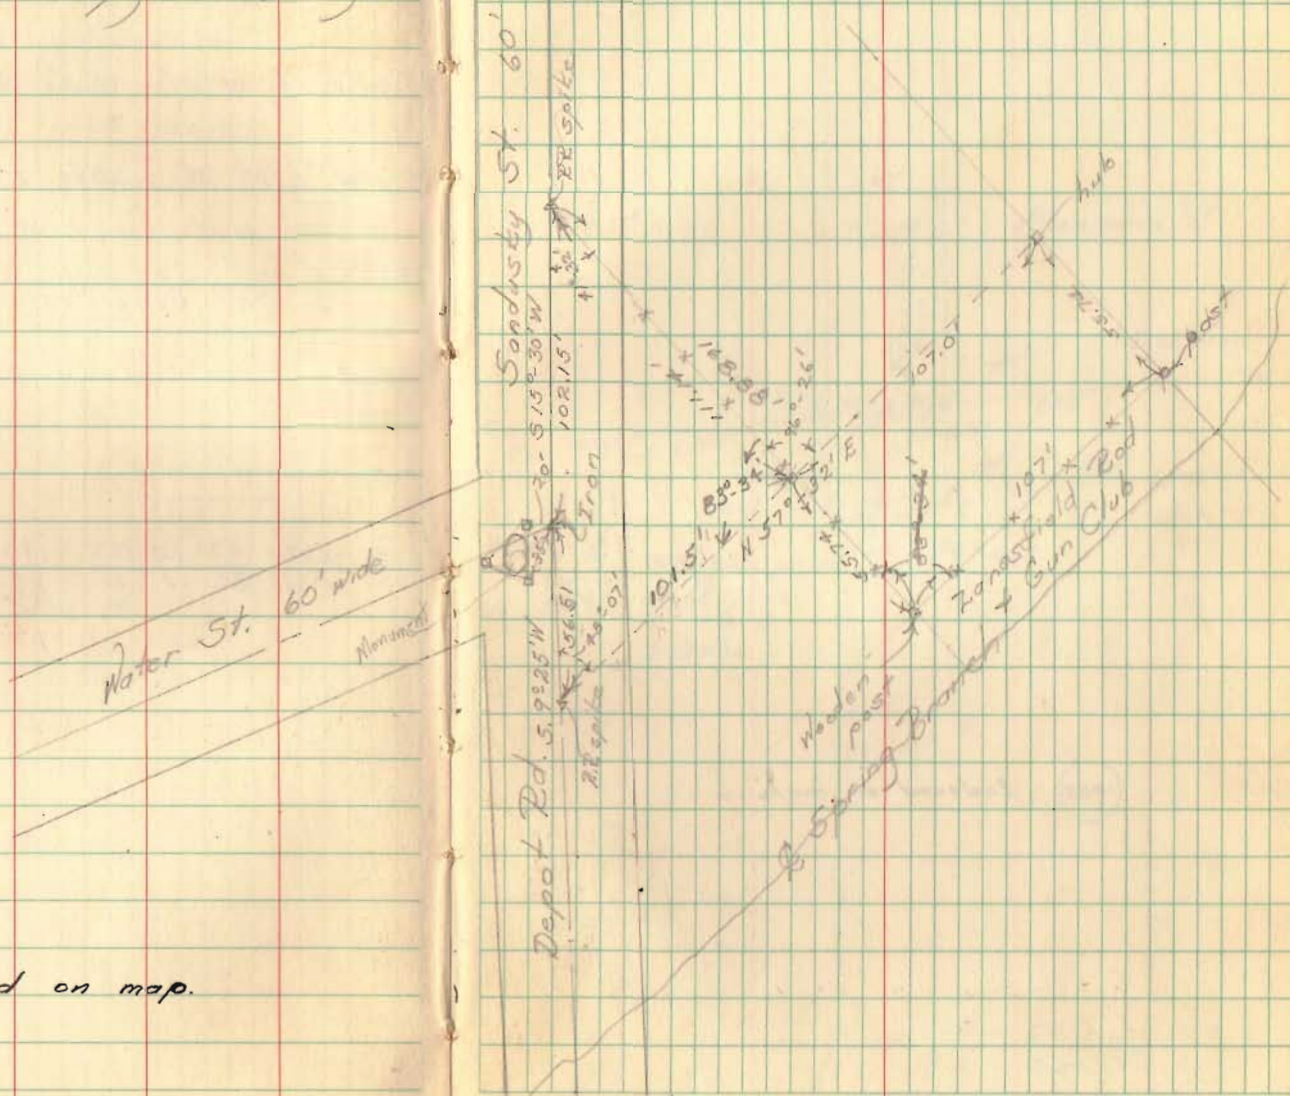

1989 Indexed on map.