

SURVEY OF
 LOT 41
 ZANESFIELD, OHIO
 MAY 9, 1964
 SCALE 1" = 50'

INDEXED ON MAP

3792 IP

Dan L. Dodson

Dan L. Dodson
 Reg. Surveyor 4270
 Bellefontaine, O.

□ = 2" x 2" x 18" Hub Set
 On Plat Book
 7/8/65
 D.E.G.

Lot 41
ZAVES FIELD

McCulloch Add. Plat BK B, Vol 2 pg. 98


near from cor of alley
along walk 6 lots to
crack in walk which

82 year old man says is only
survey mark along st.

Checks OK - used grade
made lots 55.45' OK

Edna K Davis


Lot 41 except 60' off Southend

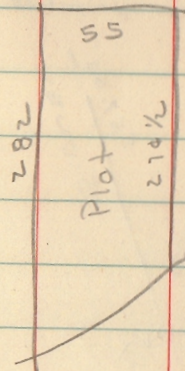

INDEXED ON MAP
3792

Dodson
Geoslin

5-9-64
70°
windy

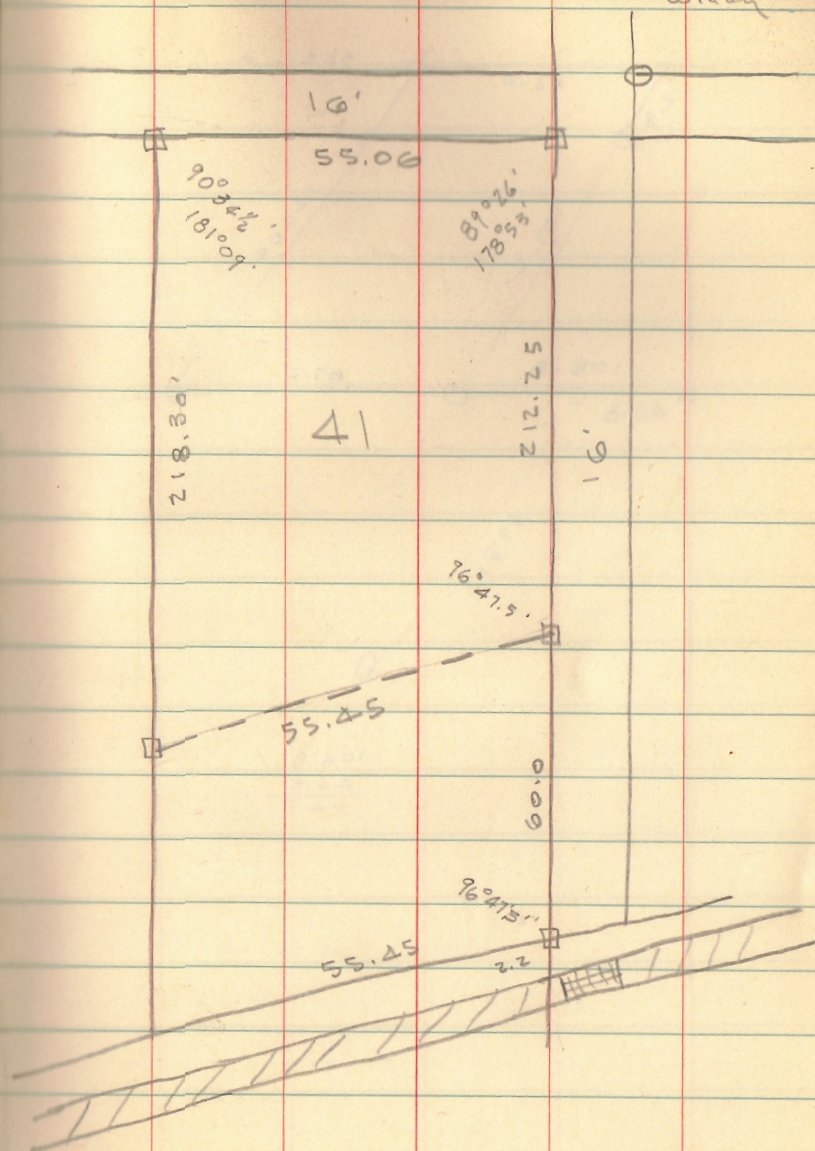

□ = Tkd Hub 2x2x18 Set