


1837
Sec. 0.00 to 0.23
Commissioners Journal 5, Page 184
60' Right of way

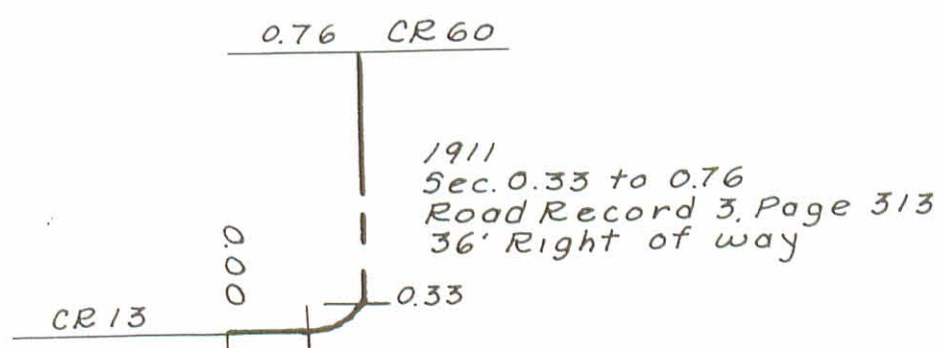

1958
Sec. 0.14 to 0.33
Sec. Plan X-79 A
60' Right of way
Easement Sheet Not Signed

1853
Sec. 0.00 to 0.14
Com. Journal 10, Page 164
45' Right of way

Road 79

Scale 3" = 1 Mi.