
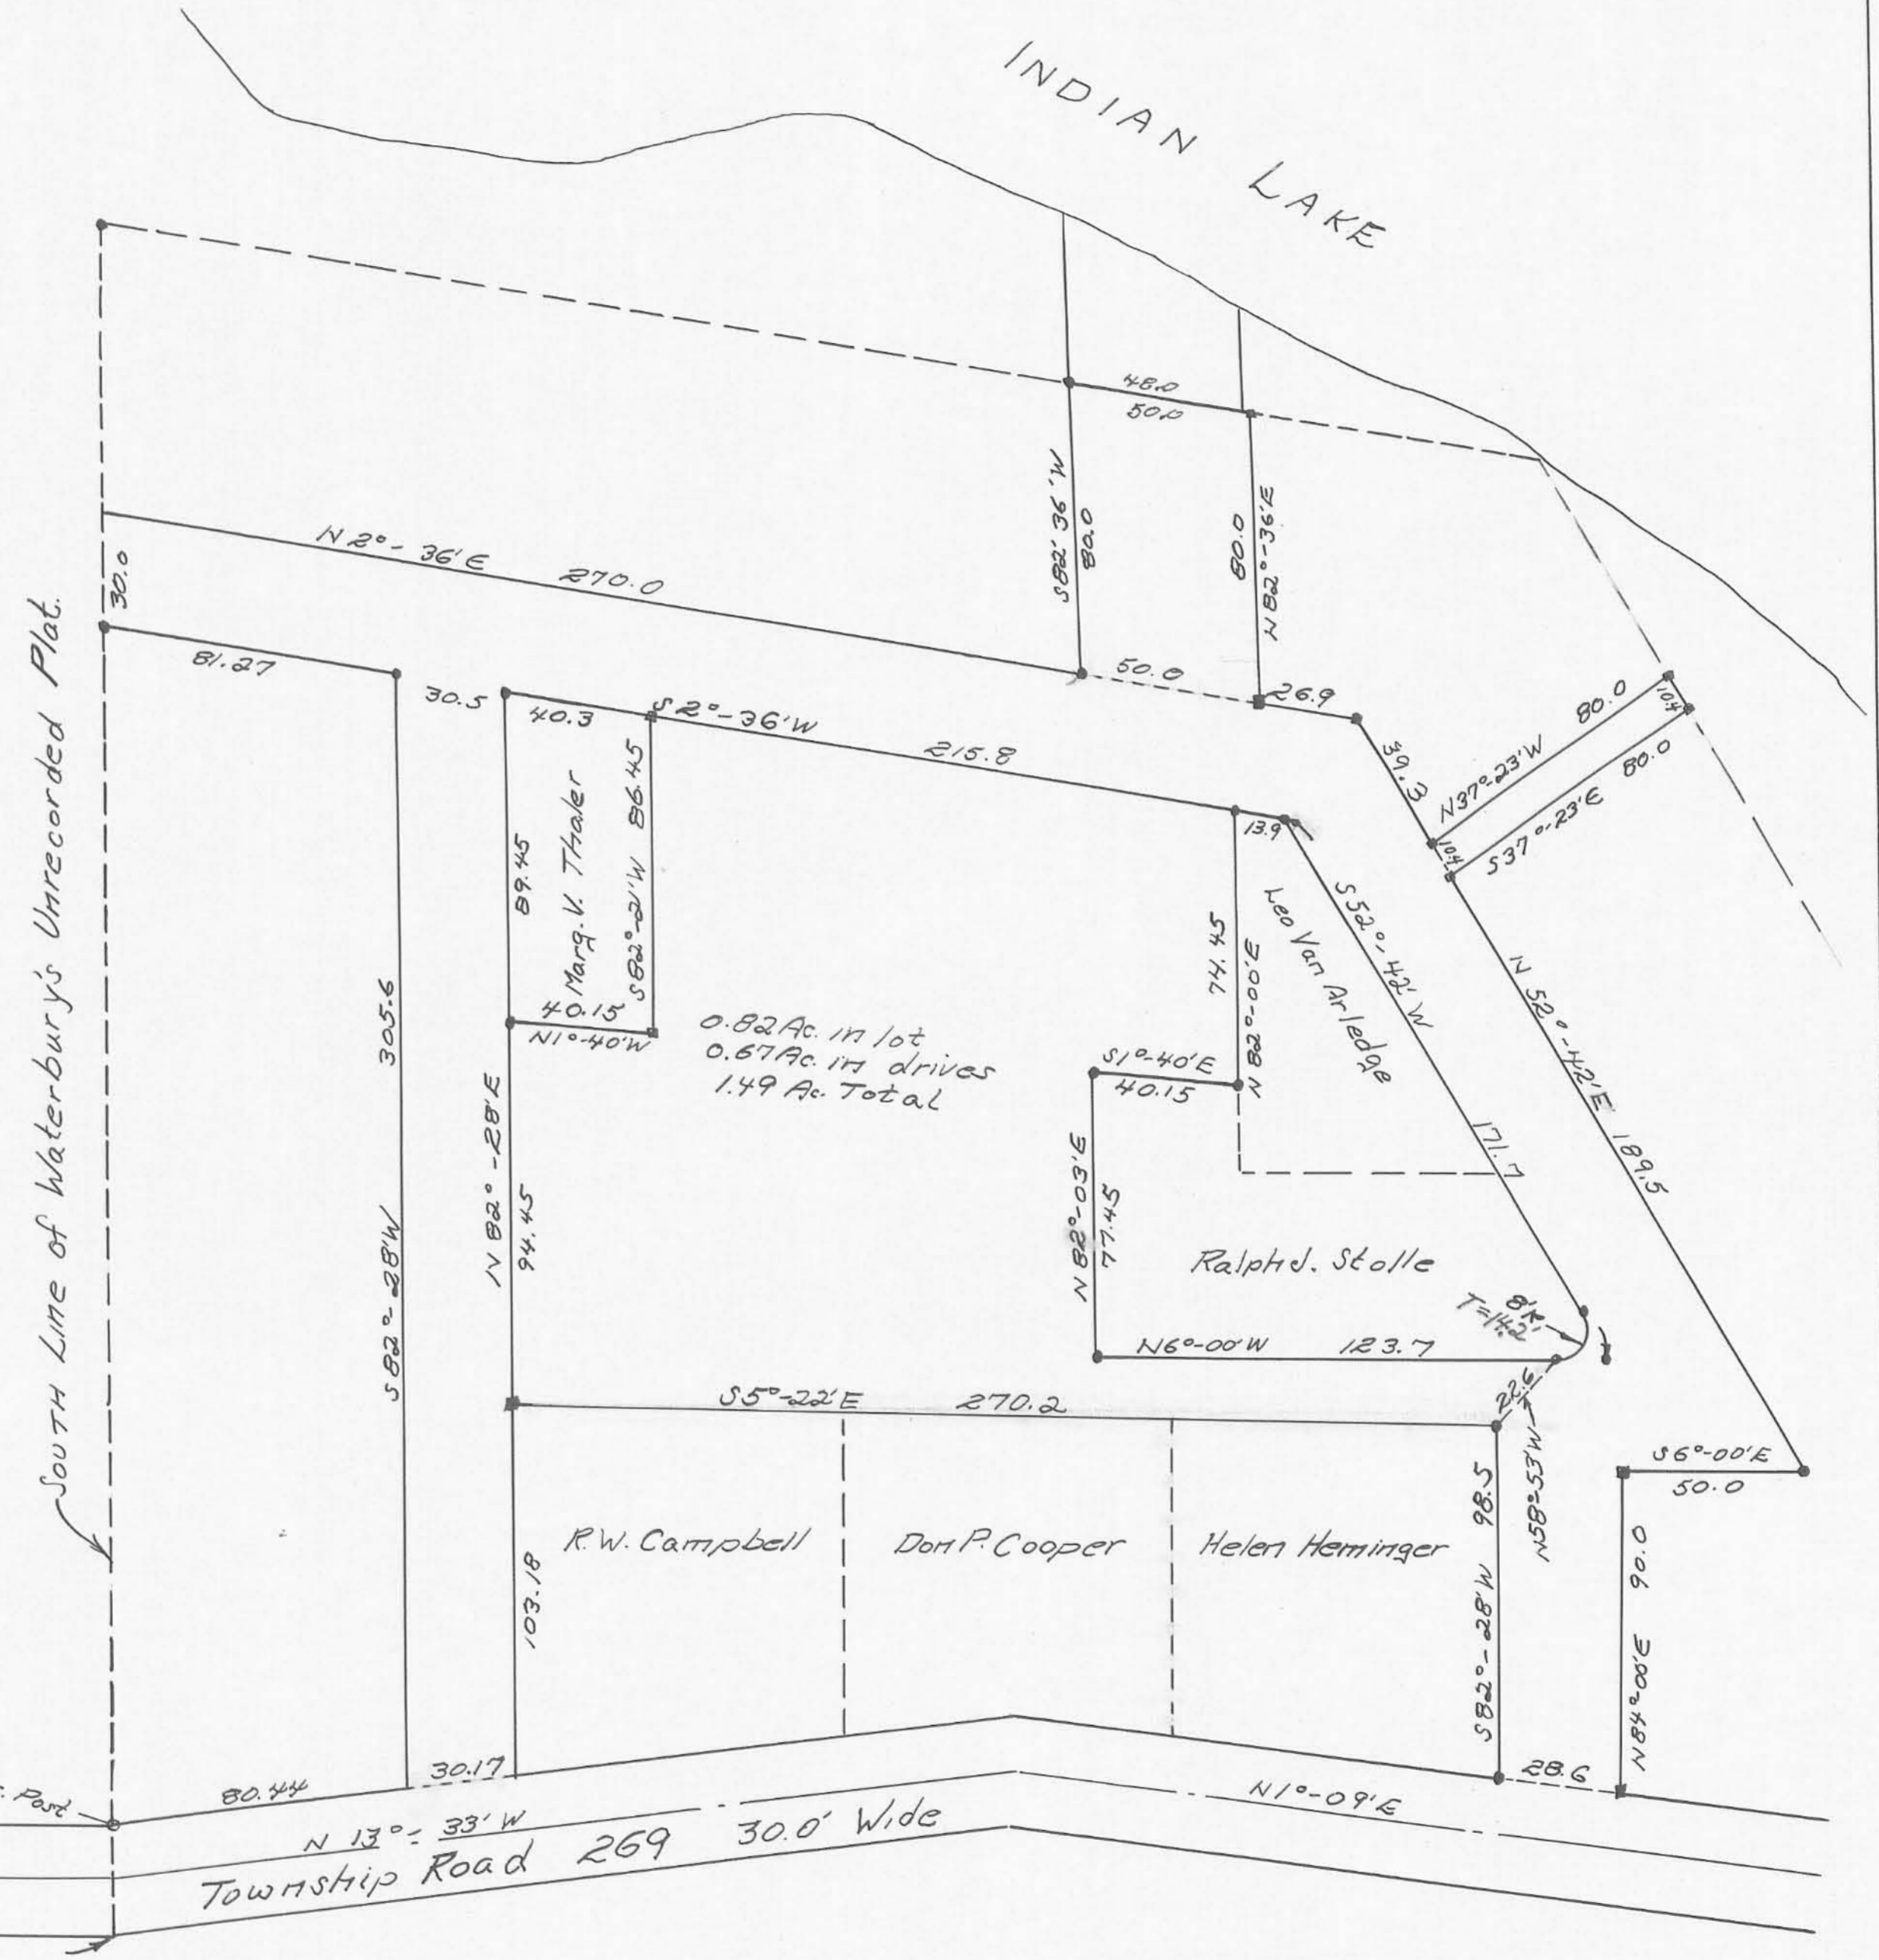


V.M.S. 9925-9946-10121  
 WASHINGTON TOWNSHIP  
 LOGAN COUNTY, OHIO  
**NETTLEINGHAM SURVEY**  
 OWEN K. SHIRK, SURVEYOR 4271  
 BELLEFONTAINE, OHIO  
 1" = 40' APRIL, 1968

- Denotes irons found.
- Denotes irons placed.

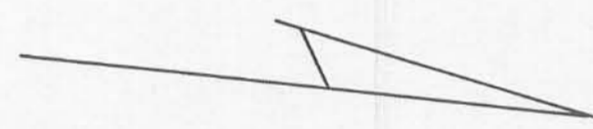

STA. 539+44 as shown on  
 Plan L-11 in Co. Engrs. Office.