


- = Irons Found
- = Irons Set
- = Hubs Found
- = Hubs Set

SCALE 1" = 20'

SURVEY OF
 LOTS 3, 4, 5 EXTENDED
 THOMAS, ADD. NO. 1, CHIPPEWA
 STORES TWP. - LOGAN CO., O.
 V.M.S. 12276
 1954

Surveyed & Drawn by
 Dan E. Dodson
 Surveyor-in-Training
 June 12, 1954

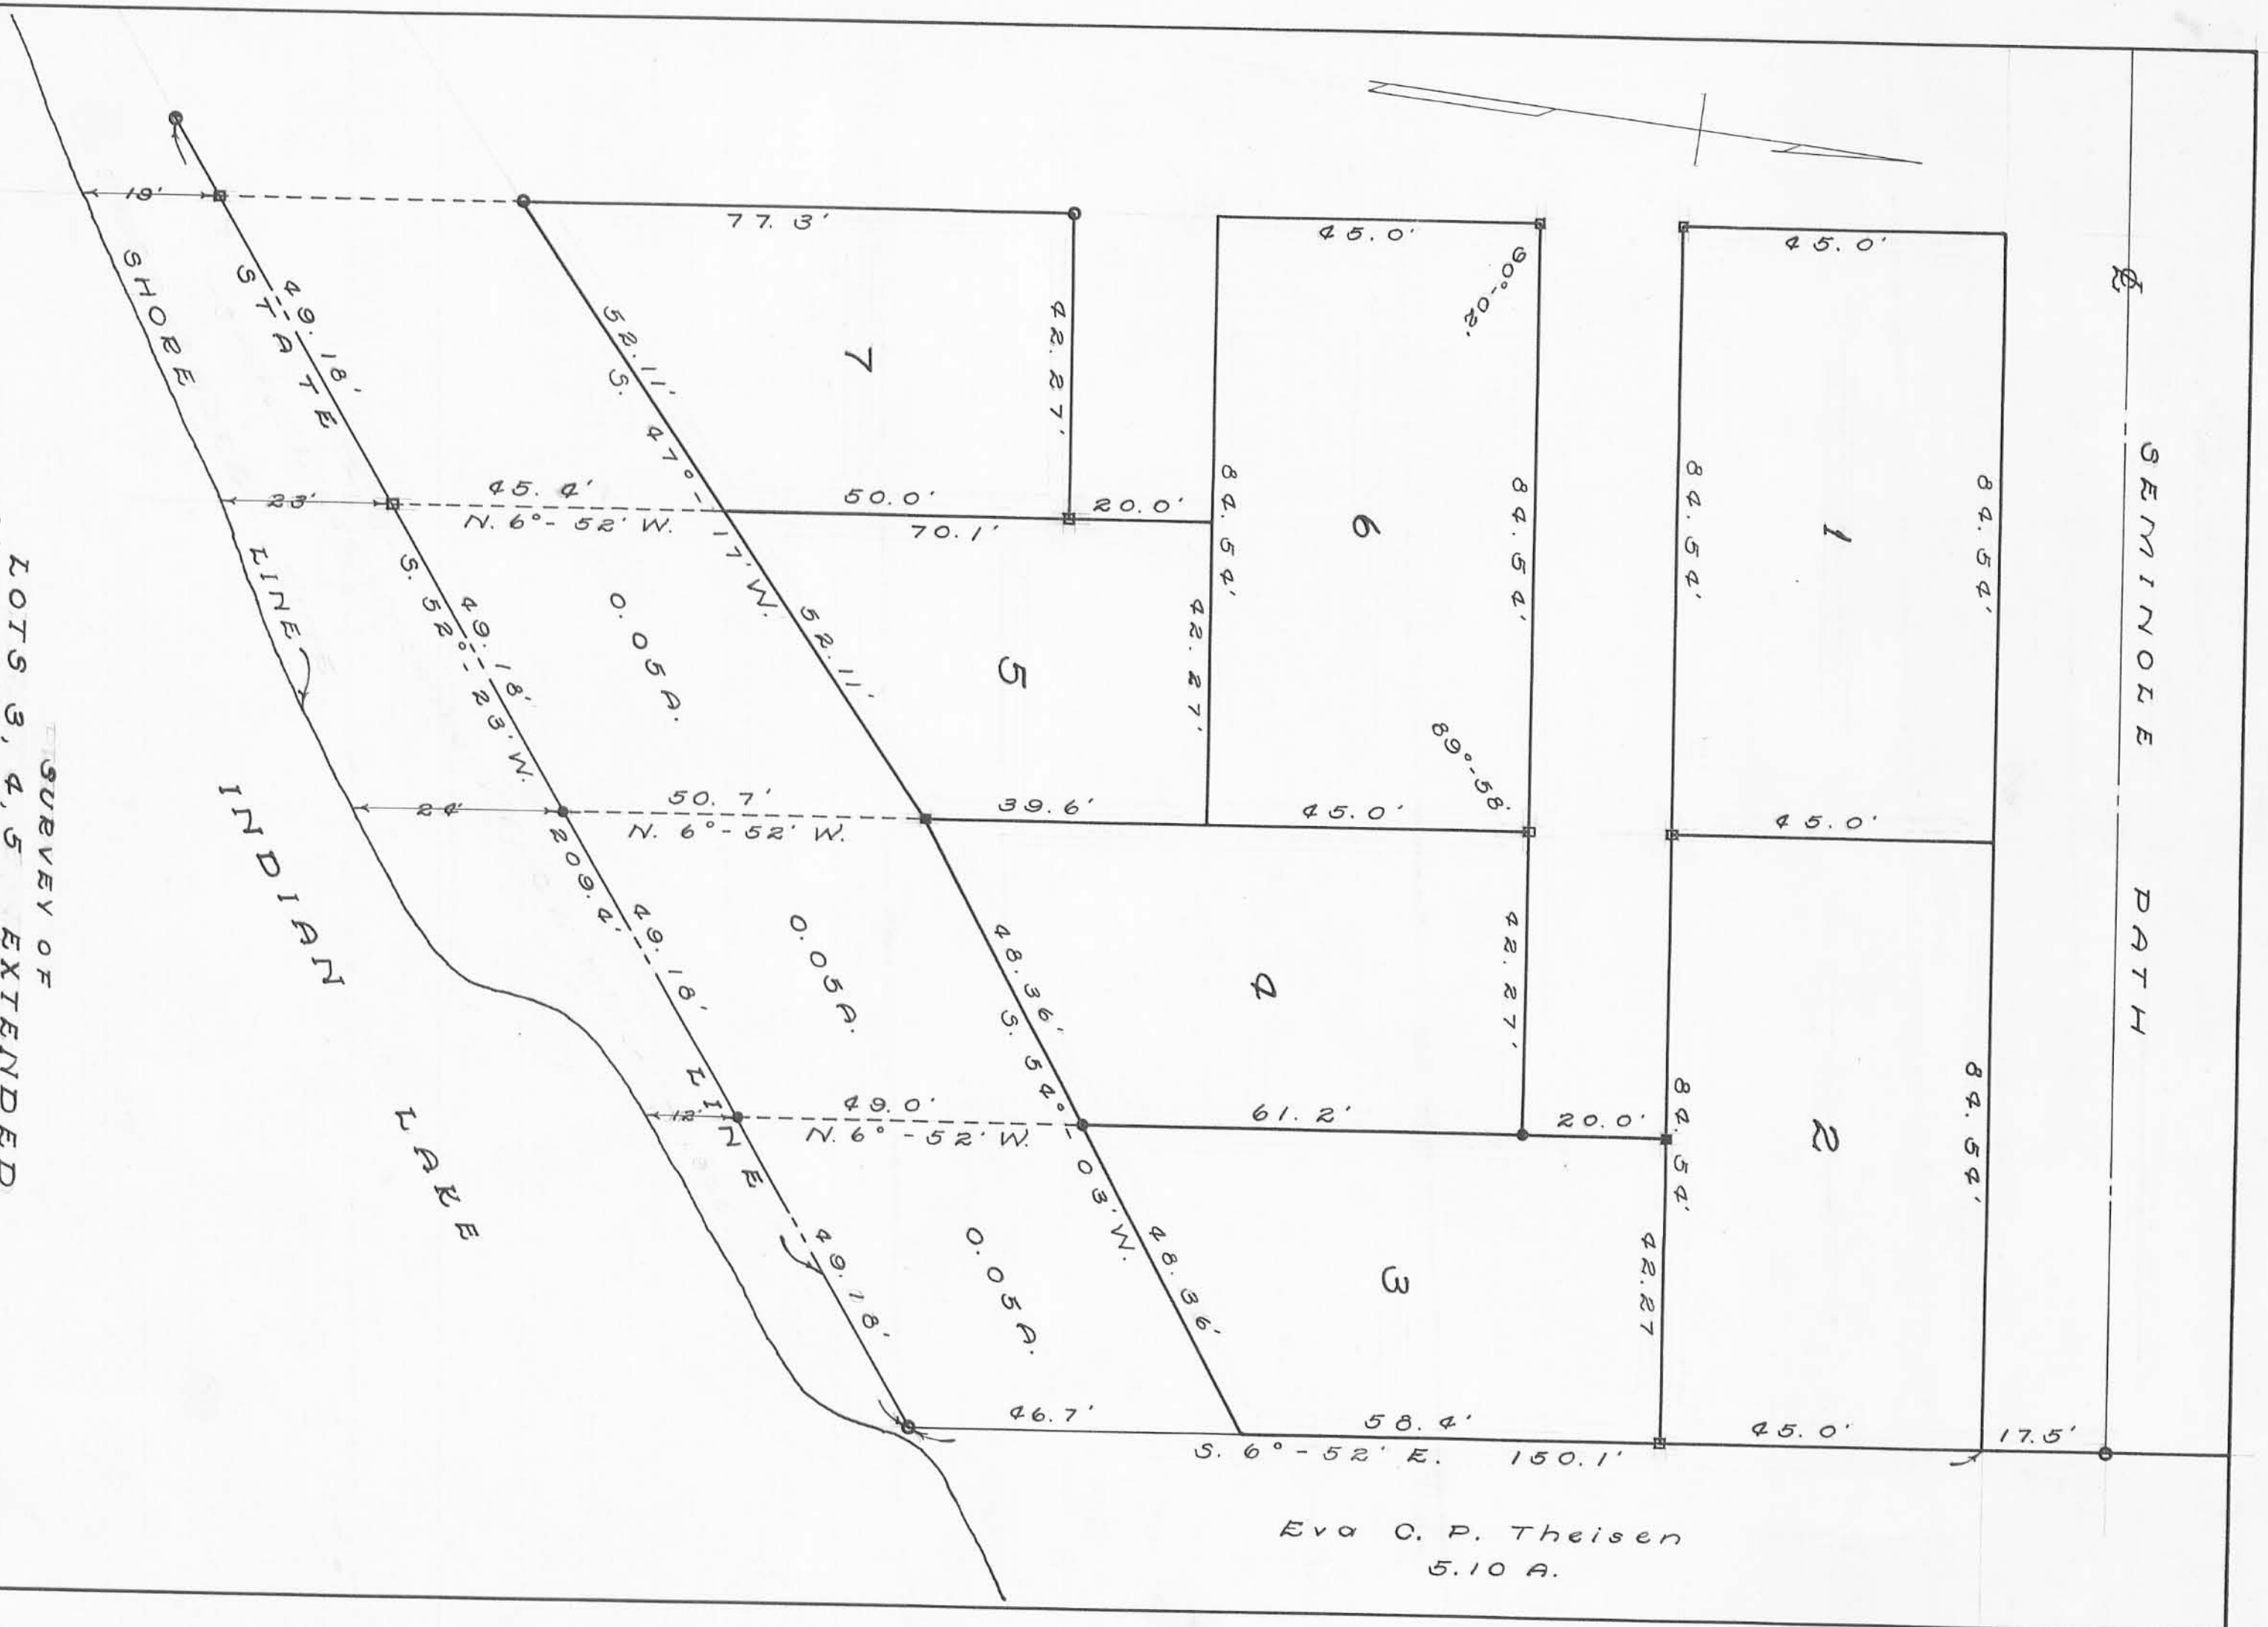

Eva C. P. Theisen
 5.10 A.