


SYMBOLS:
 • - P. K. Nails Set.
 ○ - 5/8" Rebars Fd.
 ● - 5/8" x 30" Rebars Set. (Capped).

Reference:
 Chippewa Park No. 1.
 Plat Cab. A Slide 221-223.

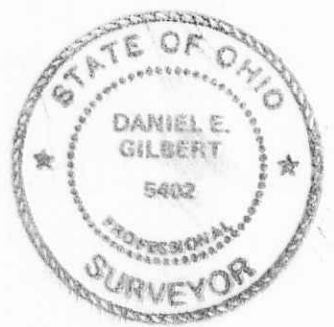

Survey of Lots No. 890, 891 & 910 Chippewa Park No. 1, V.M.S. No. 12276, Stokes Township, Logan County, Ohio.		
SCALE: 1" = 20'	APPROVED BY:	DRAWN BY DEG
DATE: 9-15-2001		REVISED
<i>Daniel E. Gilbert</i> Daniel E. Gilbert, P.S. Reg. Sur. No. 5402		DRAWING NUMBER 2001-033

INDEXED ON MAP 6293 S-435