
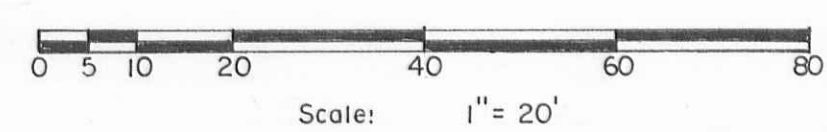


Union Drive - 30'

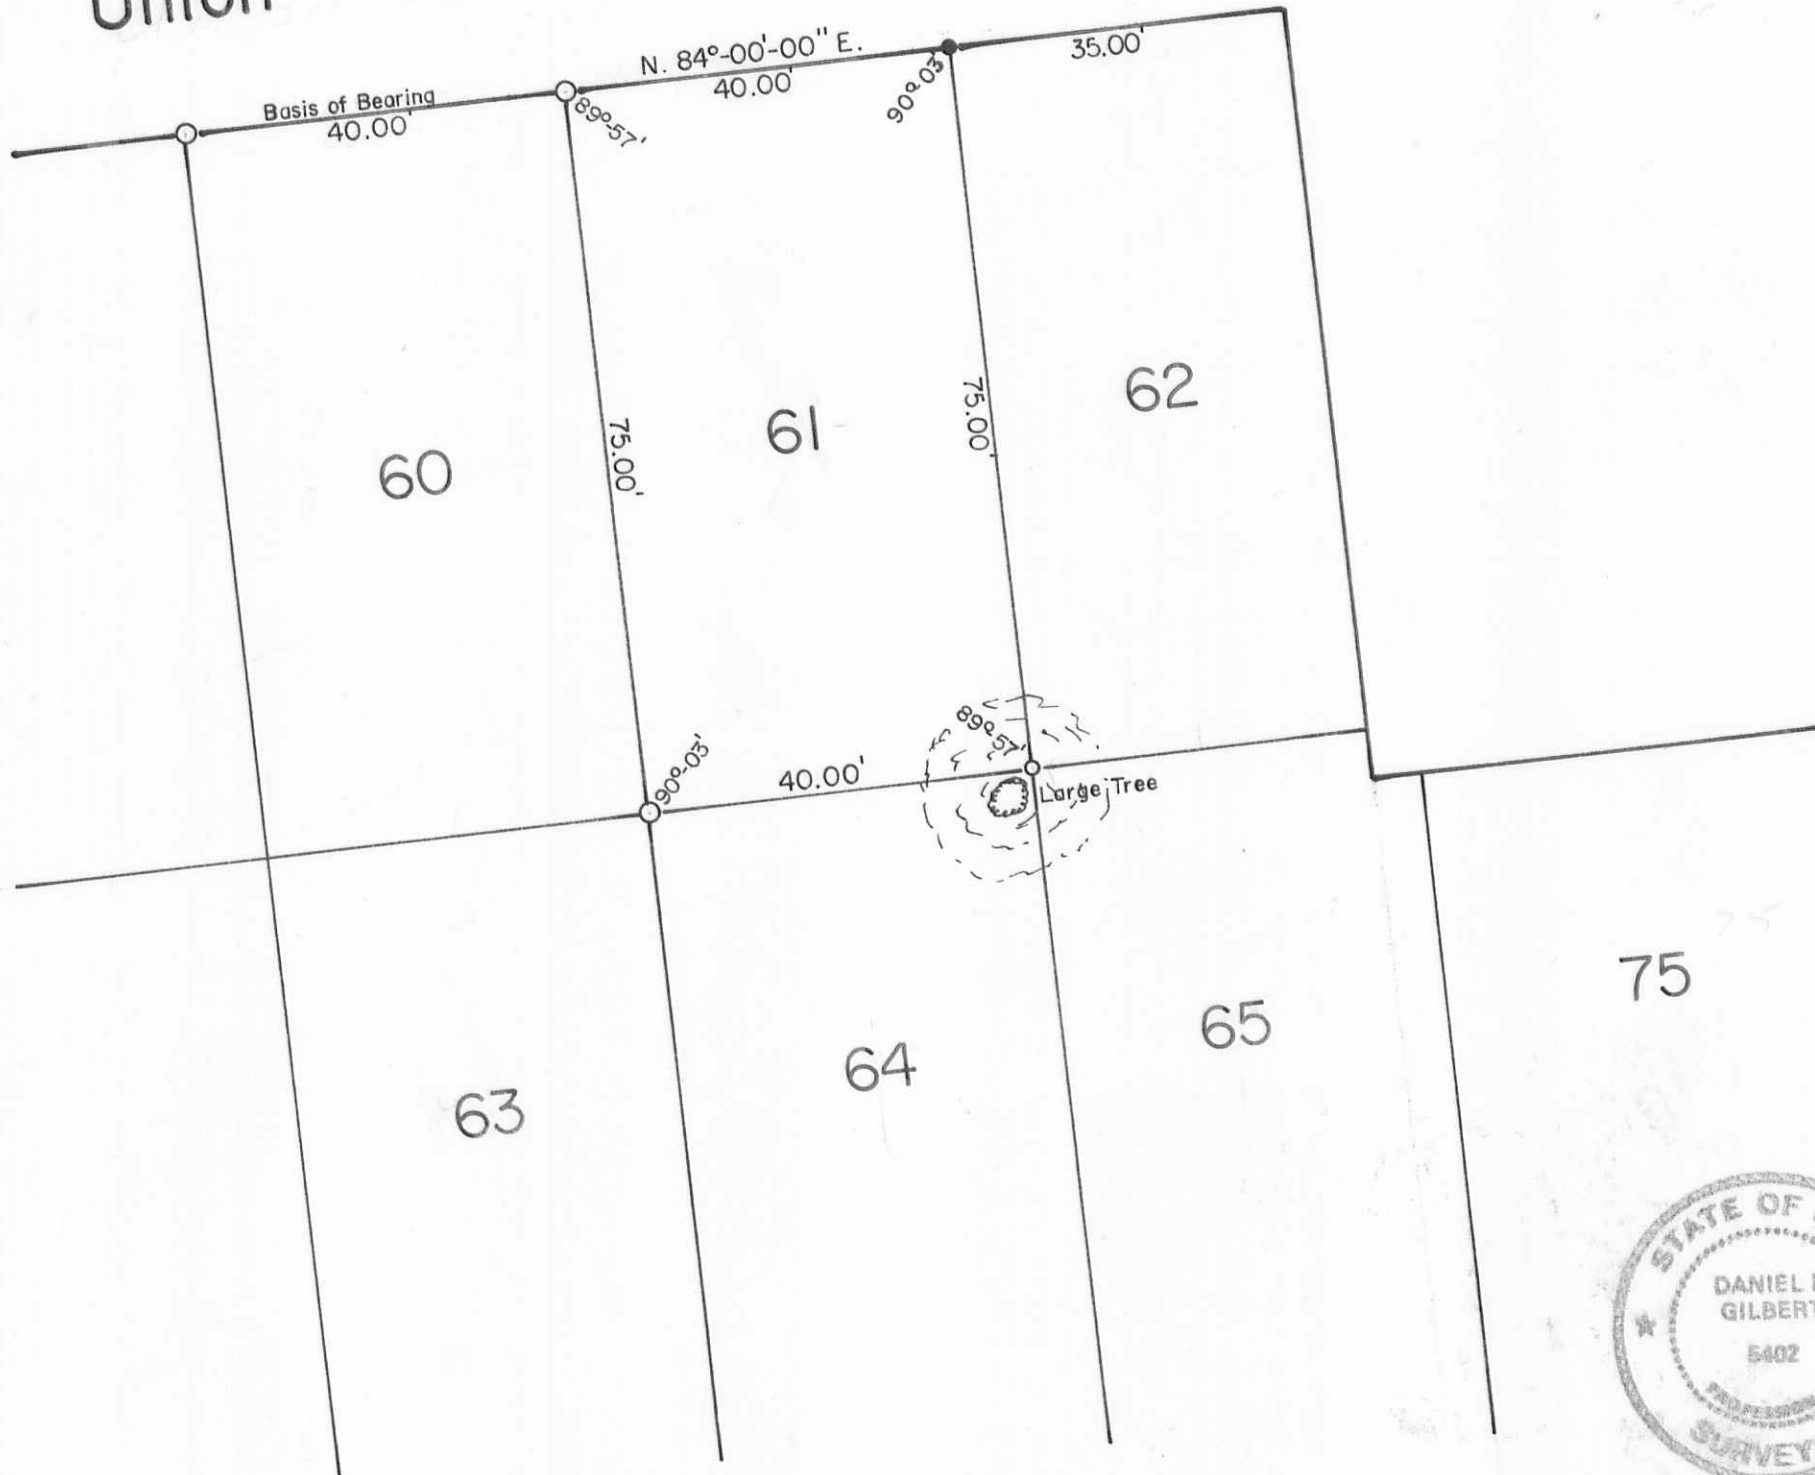

- SYMBOLS:
- - 5/8" Rebar Fd.
 - - 5/8" x 30" Rebar Set.
 - - 1" Iron Pipes Fd.

Reference:
Five Parks Allotment
Plat Cab. A, Slide 219-221.

Survey of Lot No. 61 Five Parks Allotment Washington Township, Logan County, Ohio.		
SCALE: 1" = 20' DATE: 12-13-1999	APPROVED BY:	DRAWN BY: DEG REVISED:
Daniel E. Gilbert, P.S. Reg. Sur. No. 5402		DRAWING NUMBER 099-046



INDEXED ON MAP
1887

S-402