


MAPLE AVENUE - 50'

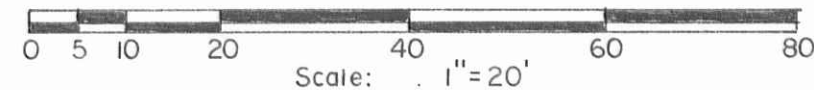

SYMBOLS:

- - 5/8" x 30" Rebars Fd. (LHG).
- ⊙ - 6 inch Concrete Monument Fd.

Reference:

Indian Lake Shores Allotment No. 1,  
Plat Cab. A Slide 399 (5-15-1962).

Foundation Survey - Lot No. 48 pt., Lot No. 49,  
Indian Lake Shores Allotment No. 1, V.M.S. No. 13393,  
Richland Township, Logan County, Ohio.

SCALE: 1" = 20'	APPROVED BY:	DRAWN BY DEG
DATE: 8-6-1999		REVISED

*Daniel E. Gilbert*  
Daniel E. Gilbert, P.S.  
Reg. Sur. No. 5402

DRAWING NUMBER  
099-030

5-491

INDEXED ON MAP  
#97 7128