


OAK ST. - 40'



Reference:
 Avondale Park Allotment No. 4 (7-21-1931)
 Plat Cabinet A Slide 248.

SYMBOLS:
 ○ - 5/8" x 30" Rebars Fd. (LHG)
 ● - 5/8" x 30" Rebars Set. (DEG)

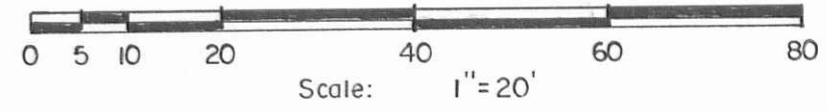

Survey of Lots No. 170, 171, 172 & 173.
 Avondale Park Allotment No. Four.
 Stokes Township, Logan County, Ohio.

SCALE: 1" = 20'	APPROVED BY:	DRAWN BY: DEG
DATE: 8-3-1999		REVISED:

Daniel E. Gilbert
 Daniel E. Gilbert, P.S.
 Reg. Sur. No. 5402

DRAWING NUMBER
 099-029

INDEXED ON MAP
 9656

5-493