

LAWRENCE ST. - 45'
 N. 3°-43' E. 484.12' To Iron Bolt Found at
 intersection of centerline at JAY Avenue.

Iron Bolt Fd.

201.46' N. 86°-49'-40" W.
 19.00' 40.00' (Basis of Bearing) 384.39' 142.93'
W. WILLIAMS AVE. - 34'

Iron Pipe Fd.

15.0' ALLEY
 N. 3°-51'-23" E. 135.22'
 116.22'

Henry E. Artis
 Deed Vol. 374 P. 795
 Per. Par. No. 17-091-07-16-011.000
0.15 Acres
 S. 86°-49'-40" E. 40.00'

Mildrena Brown
 O.R. Vol. 24 P. 268-269
 (6-9-1986)
 Per. Par. No. 17-091-07-16-008.000
4,648.72^{sq} ft or 0.107 Acres



Marilyn S. William et al
 Deed Vol. 378 P. 92-93 (8-4-1978)
 Per. Par. No. 17-091-07-16-009.000
0.20 Acres
 S. 3°-51'-23" W. 116.22'

Alfonso Bregaston et ux
 Deed Vol. 169 P. 350 (3-17-1941)
 Per. Par. No. 17-091-07-16-010.000
0.15 Acres
 135.22'

N. 4°-00' E. 484.11' To Iron Bar in Mon. Box Found
 at intersection of centerline at JAY Avenue.
WALKER ST. - 30'

C. I. Mon. in Mon. Box Fd.

- - P. K. Nail Set.
- - 5/8" x 30" Rebars Set.

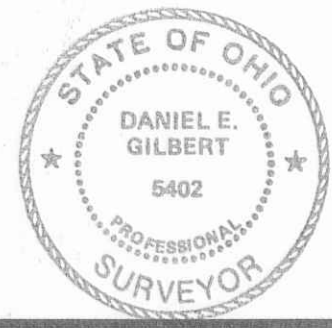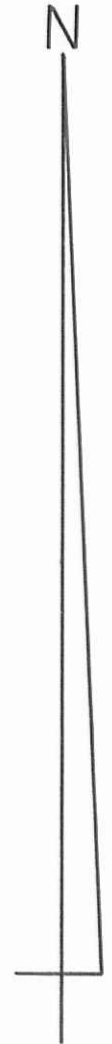

Mildrena Brown Survey, Frac. Sec. No. 35 T.4 R.14, BMRS.
 City of Bellefontaine, Lake Township,
 Logan County, Ohio.

SCALE: 1" = 20'	APPROVED BY:	DRAWN BY DEG
DATE: 2-13-1990		REVISED

Daniel E. Gilbert

Daniel E. Gilbert, P.S.
 Reg. Sur. No. 5402

DRAWING NUMBER
 090-009 A

INDEXED ON MAP
 8000

S-657