



U.S. R. No. 33

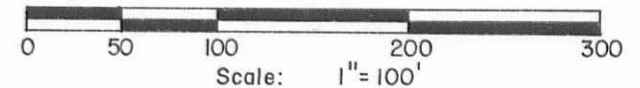

Daniel E. Gilbert

DANIEL E. GILBERT, P.S.
 REG. SUR. NO. 5402
 400 N. PARK ST.
 BELLEFONTAINE, OHIO 43311
 TELEPHONE: 1 (513) 593-1428

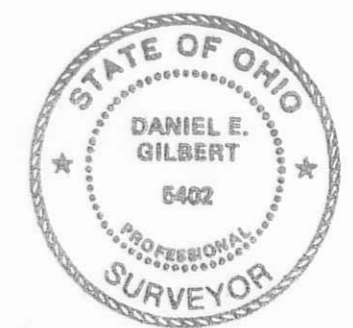

- ◇ - R. R. Spikes Fd.
- - 5/8" x 30" Rebars Fd.
- - 5/8" x 30" Rebar Set.
- ✱ - 3/4" Iron Bars Fd.

TOLERANCES (EXCEPT AS NOTED)	REVISIONS		
	NO.	DATE	BY
DECIMAL	1		
±	2		
FRACTIONAL	3		
±	4		
ANGULAR	5		
±			

VAN HARVEY SURVEY			
Frac. Sec. No. 36, T. 4, R. 14, BMRS. Lake Township, Logan County, Ohio.			
DRAWN BY	DEG	SCALE	MATERIAL
CHK'D	DEG	DATE	As Noted
TRACED	DEG	APP'D	DRAWING NO.
			091-064

INDEXED ON MAP
7080