


HELEN L. TROYER  
 Vol. 396 P. 064 (7-3-1982) 1.54 ACRES  
 PER. PAR. No. 23-049-00-00-044

BROKEN SCALE

T.R. No. 37

60' R/W.

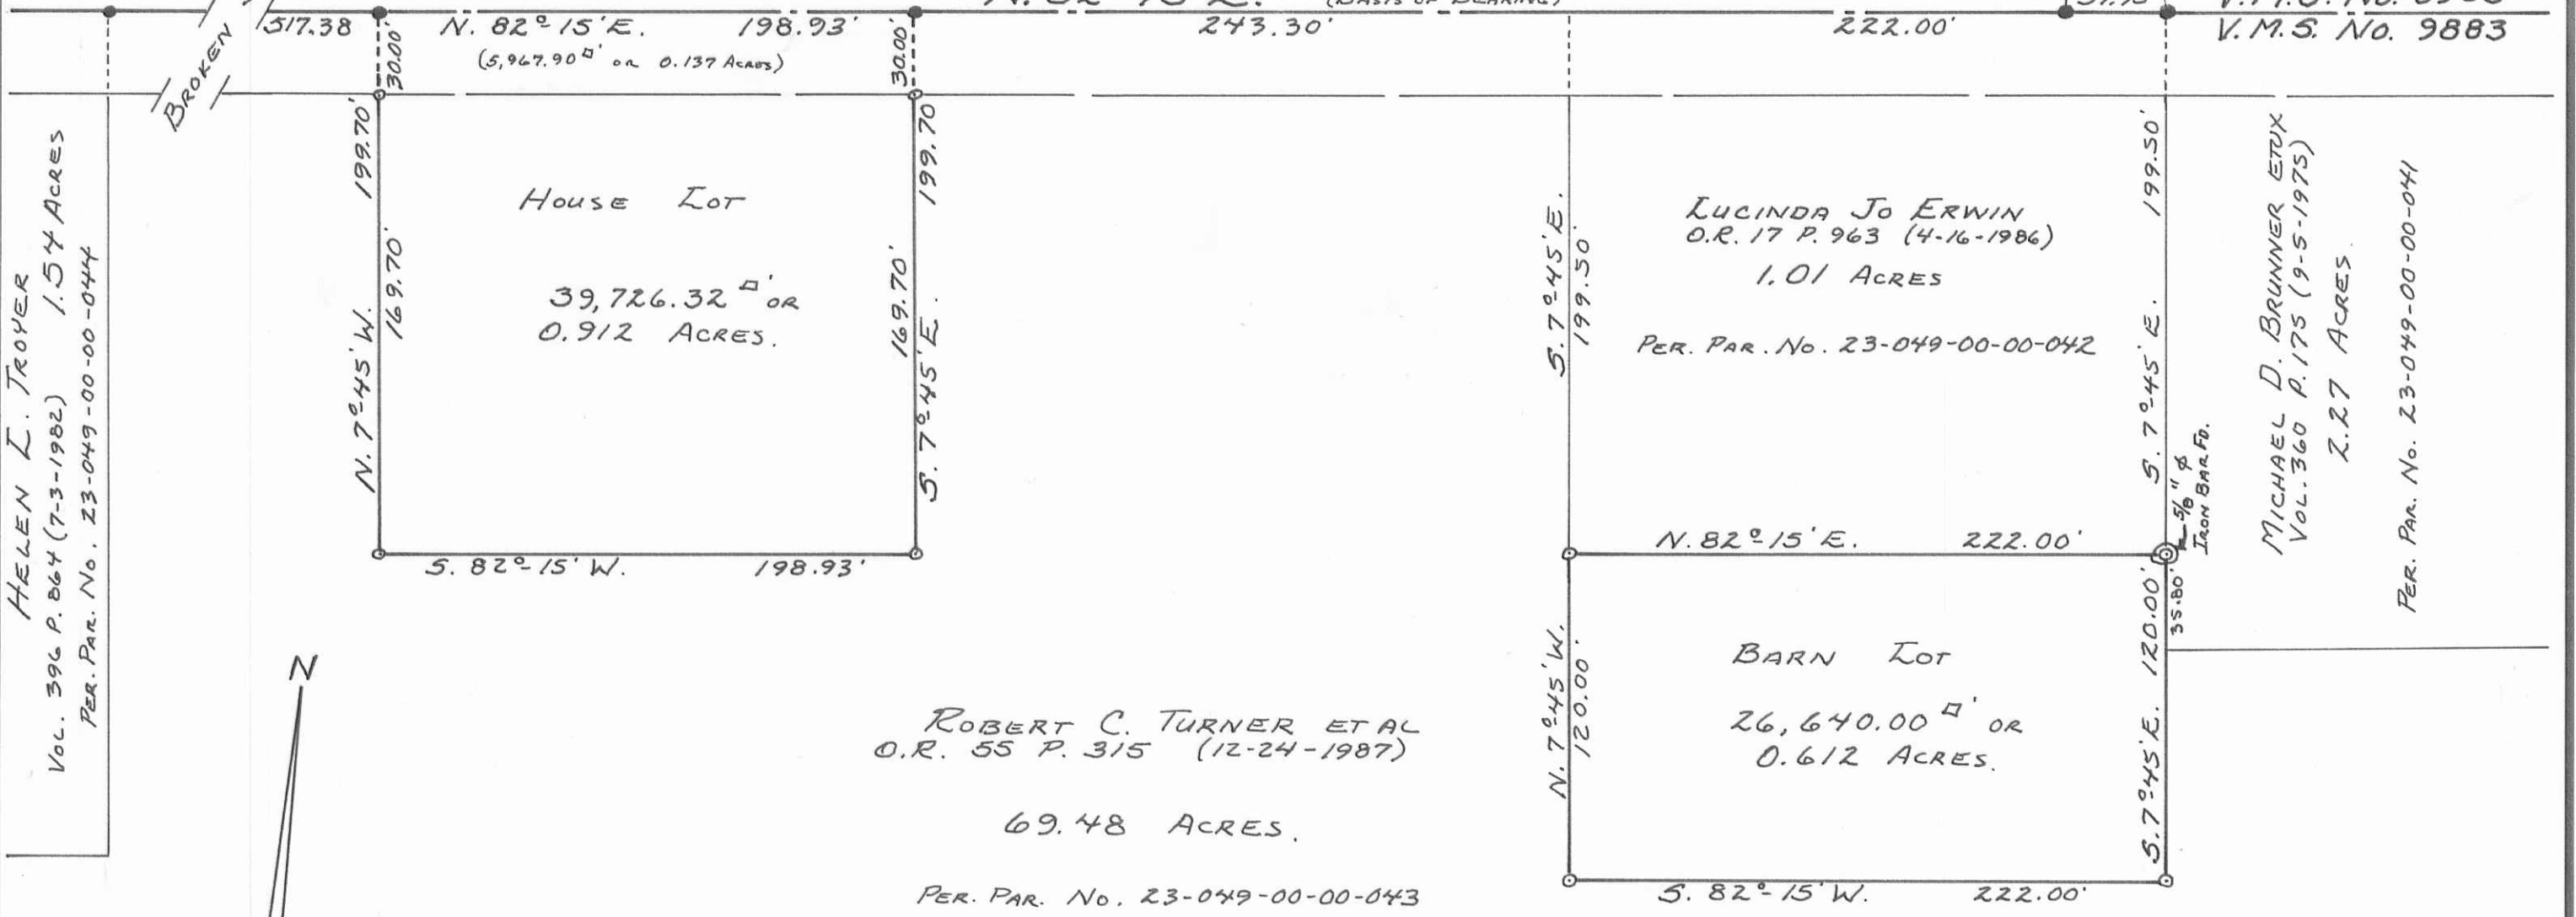

MICHAEL D. BRUNNER ETUX  
 Vol. 360 P. 175 (9-5-1975)  
 2.27 ACRES  
 PER. PAR. No. 23-049-00-00-041

LEGEND:  
 ● - R.R. SPIKES FD. OR. SET.  
 ○ - 5/8" X 30" REBARS SET.

INDEXED ON MAP  
 3552



TURNER SURVEY, V.M.S. No. 9883		
M.C. ARTHUR TOWNSHIP		
LOGAN COUNTY, OHIO		
SCALE: 1"=60'	APPROVED BY:	DRAWN BY DEG
DATE: 3-24-1988		REVISED
 DANIEL E. GILBERT, P.S. REG. SUR. No. 5402 BELLEFONTAINE, OHIO 43311		
DRAWING NUMBER		088-009

S-743