


CHANNEL

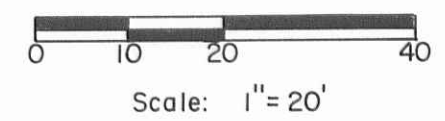

Per. Par. No. 36-019-10-01-043.000
 Lot No. 40
 Jennie L. Moore
 Vol. No. 363 P. 168 (4-16-1976).

- SYMBOLS:
- - 5/8" x 30" Rebars Fd.
 - - 5/8" x 30" Rebars Set.
 - ⊙ - 1" I.D. Iron Pipe Fd.
 - ⊗ - 1 1/2" O.D. Iron Pipe Fd.

Total Tract - 7,750.575^{sq ft} or 0.178 Acres.

MOORE SURVEY - Lot No. 40 and Extension Thereto,
 Fernwood Subdivision No. 1 - Long Island, V.M.S. No. 13393,
 Richland Township, Logan County, Ohio.

SCALE: 1" = 20'	APPROVED BY:	DRAWN BY: DEG
DATE: 8-4-1994		REVISED:



Daniel E. Gilbert
 Daniel E. Gilbert, P.S.
 Reg. Sur. No. 5402

DRAWING NUMBER
 094-026

Reference:
 Fernwood Subdivision No. 1 (7-II-1923).
 Plat Cab. A Slide 179.

INDEXED ON MAP
 8894

S-786