



INDIAN


LAKE

SHADY LANE

Robert J. Meyers et ux  
Vol. No. 240 P. 427 (10-26-1956)  
**Lot 133**  
36-019-06-04-004.000

Irvin D. Henderson et ux  
O.R. No. 127 P. 214 (4-29-1991)  
**Lot 134**  
36-019-06-04-005.000

Eugene L. Tartell et ux  
Vol. No. 359 P. 171 (7-2-1973)  
**Lot 135**  
36-019-06-04-006.000

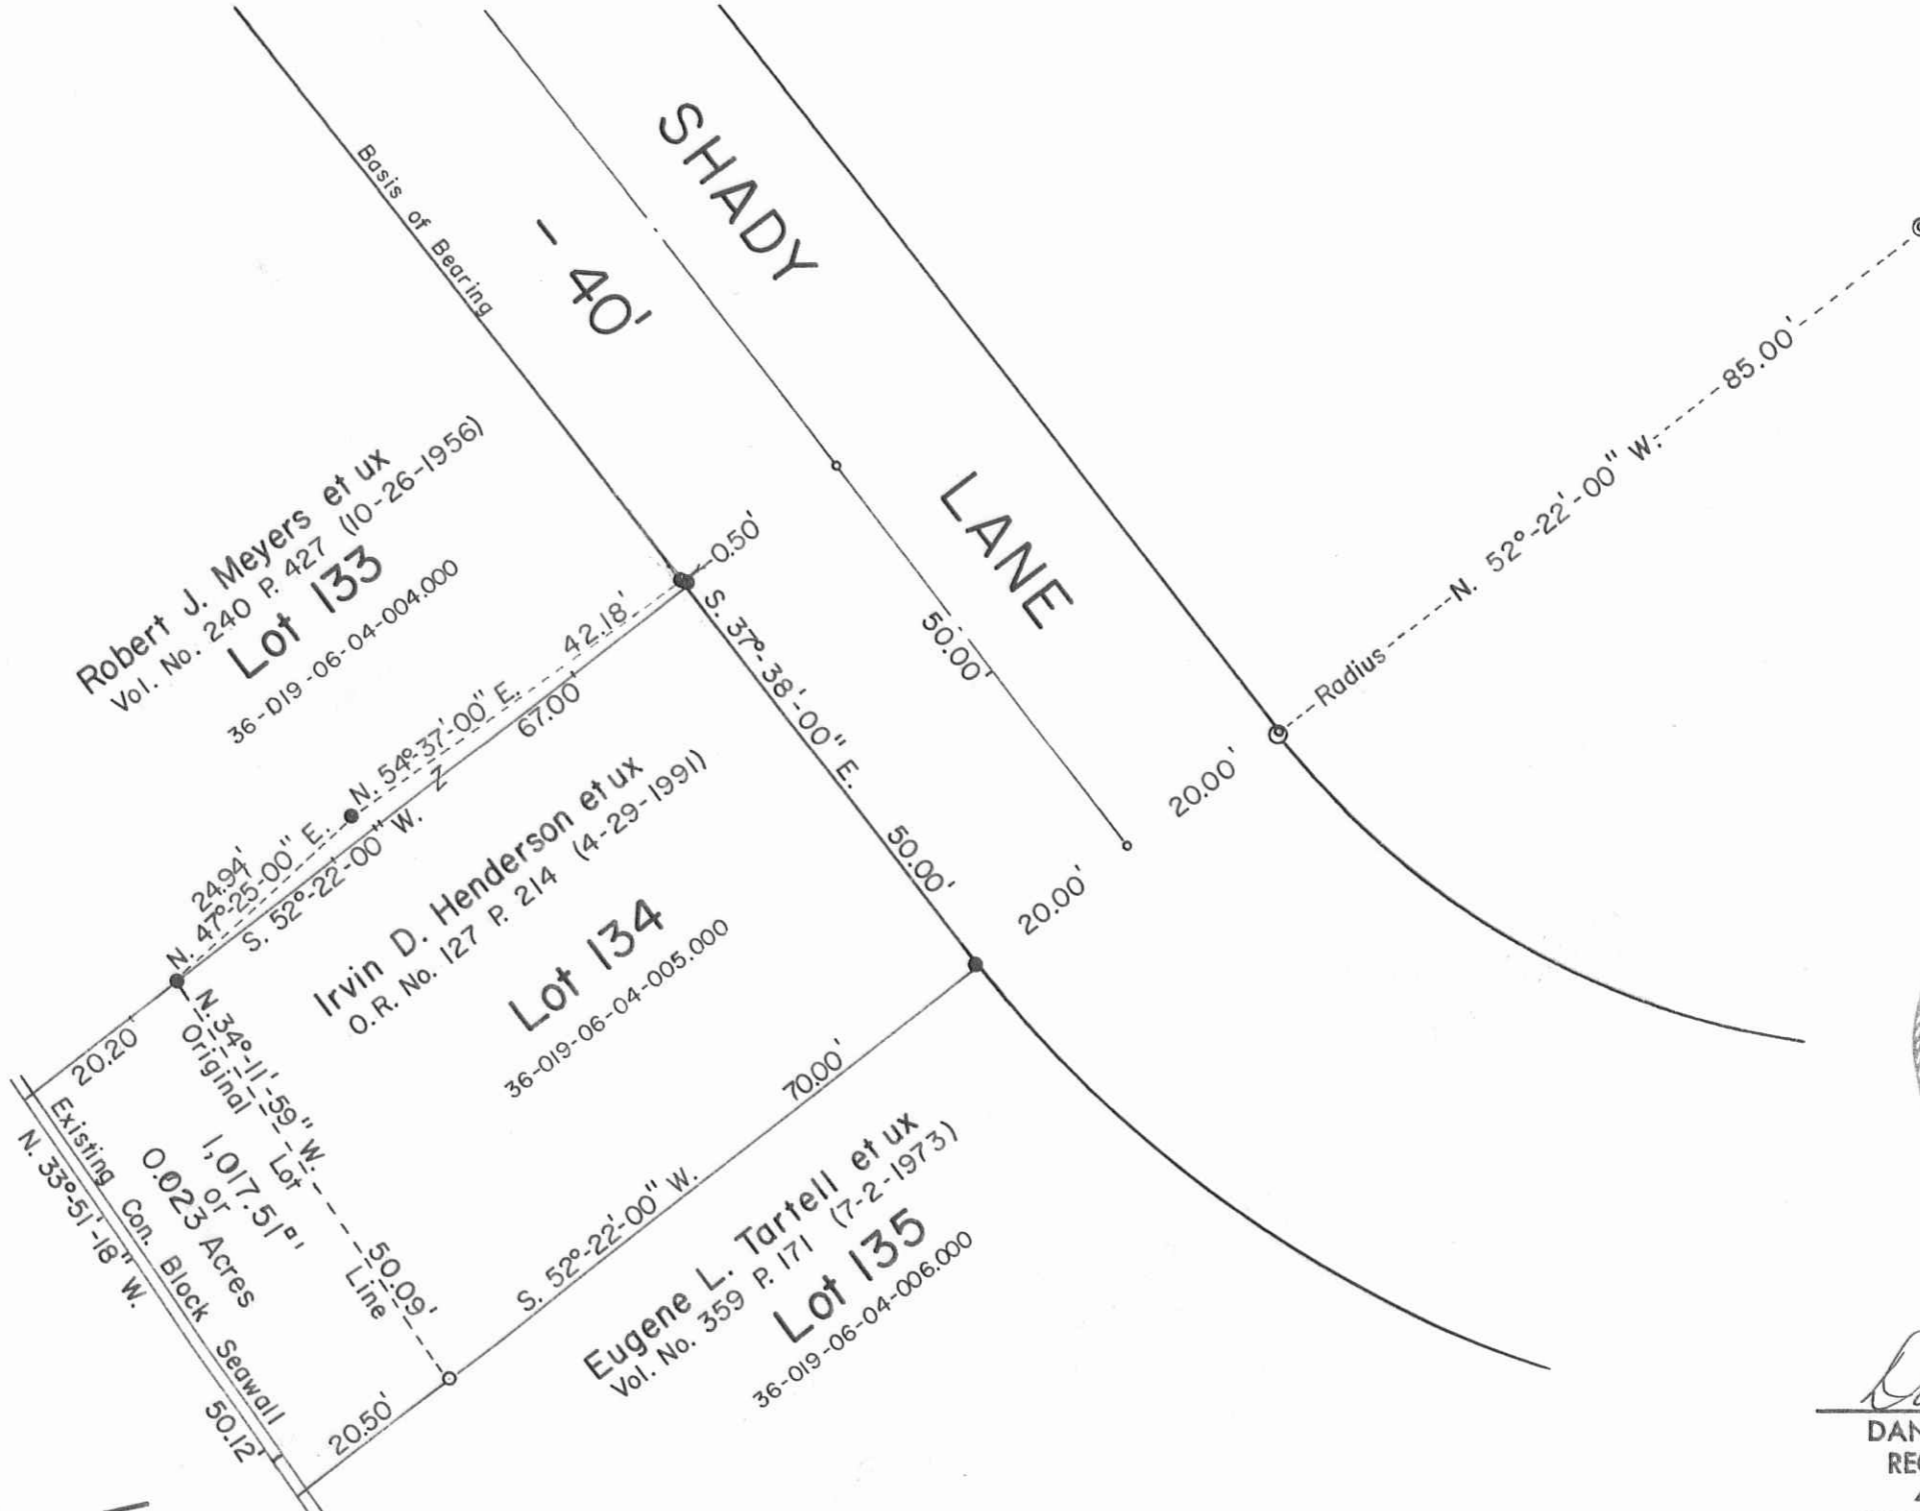

*Daniel E. Gilbert*  
DANIEL E. GILBERT, P.S.  
REG. SUR. NO. 5402  
400 N. PARK ST.  
BELLEFONTAINE, OHIO 43311  
TELEPHONE: 1 (513) 593-1428



Scale: 1" = 20'

INDEXED ON MAP  
6605

- SYMBOLS:
- - P. Nails Set.
  - - 3/4" Iron Pipe Fd.
  - - 5/8" x 30" Rebars Set.
  - ⊙ - 1" Round Iron Bar Fd.

REFERENCE:  
Fernwood Subdivision No. 2.  
Plat Cab. A Slide 261 (7-22-1946).

TOLERANCES (EXCEPT AS NOTED)	REVISIONS			HENDERSON RESURVEY, V.M.S. No. 13393, Lot No. 133 Pt. 134, Fernwood Sub. No. 2, Long Island, Richland Township, Logan County, Ohio.
	NO.	DATE	BY	
DECIMAL	1			DRAWN BY DEG CHK'D DEG TRACED DEG
±	2			
FRACTIONAL	3			SCALE 1" = 20'
±	4			MATERIAL As Noted
ANGULAR	5			DATE 10-26-1992
±				APP'D
				DRAWING NO. 092-053C

S-800